
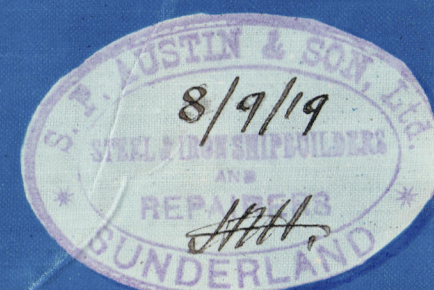
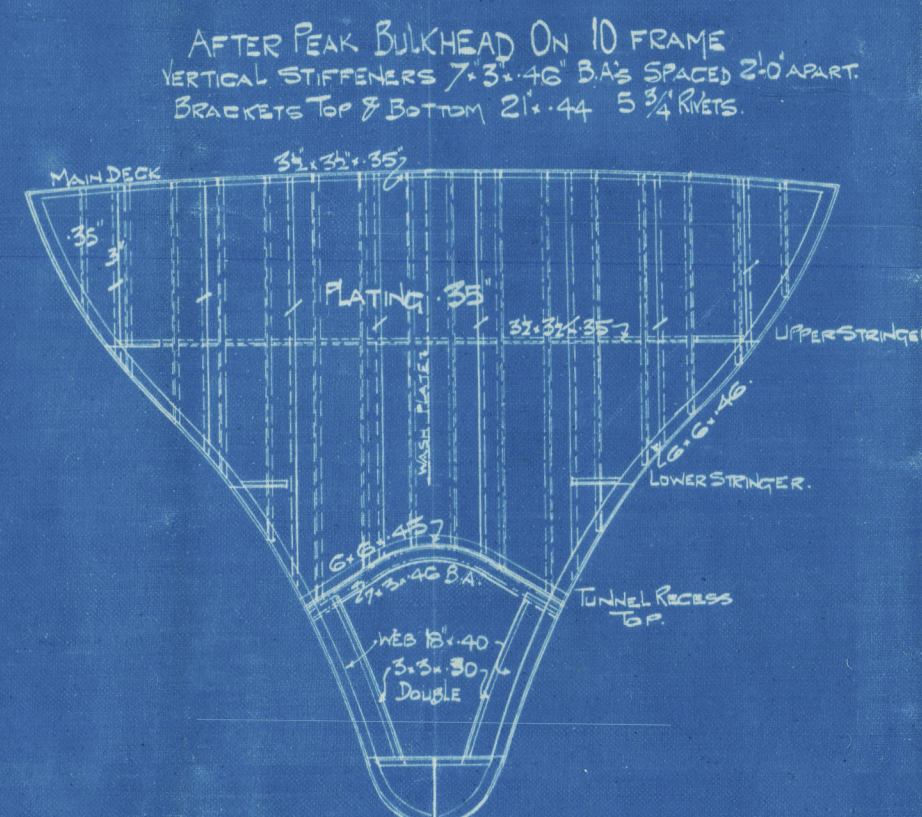
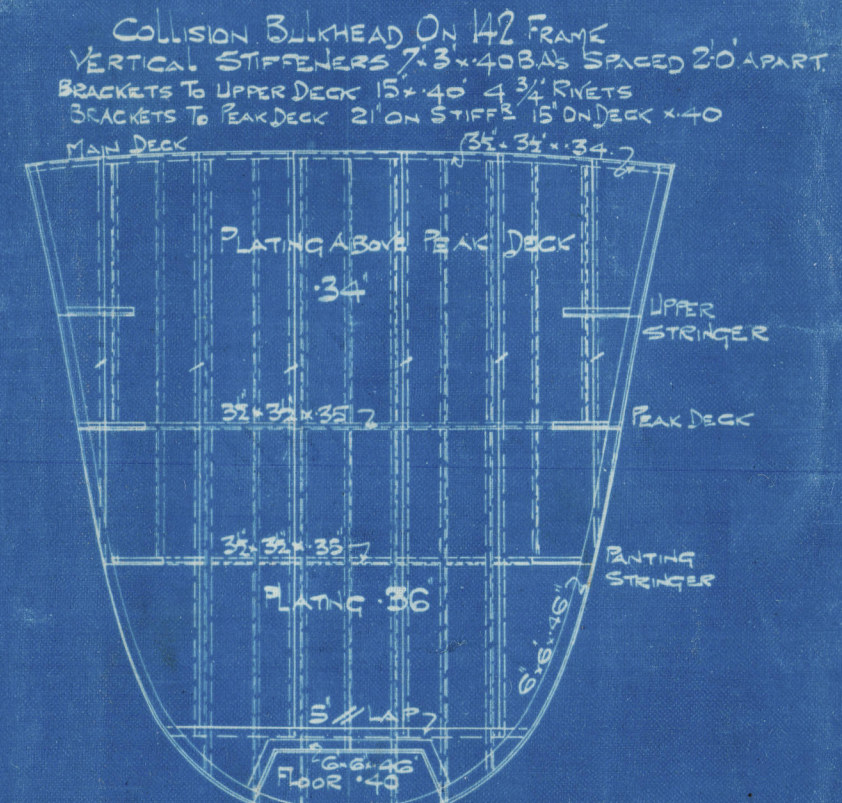
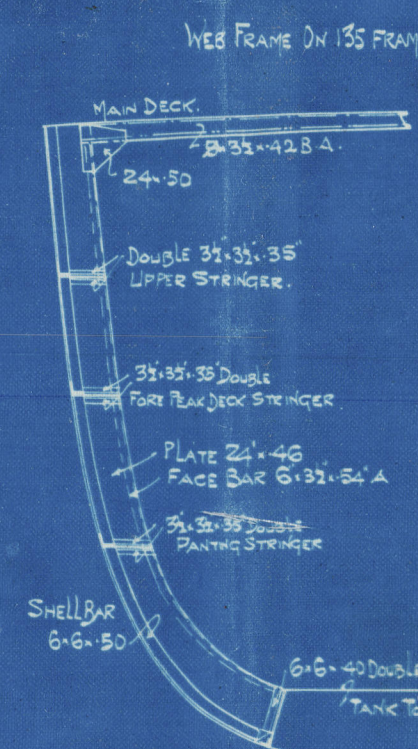
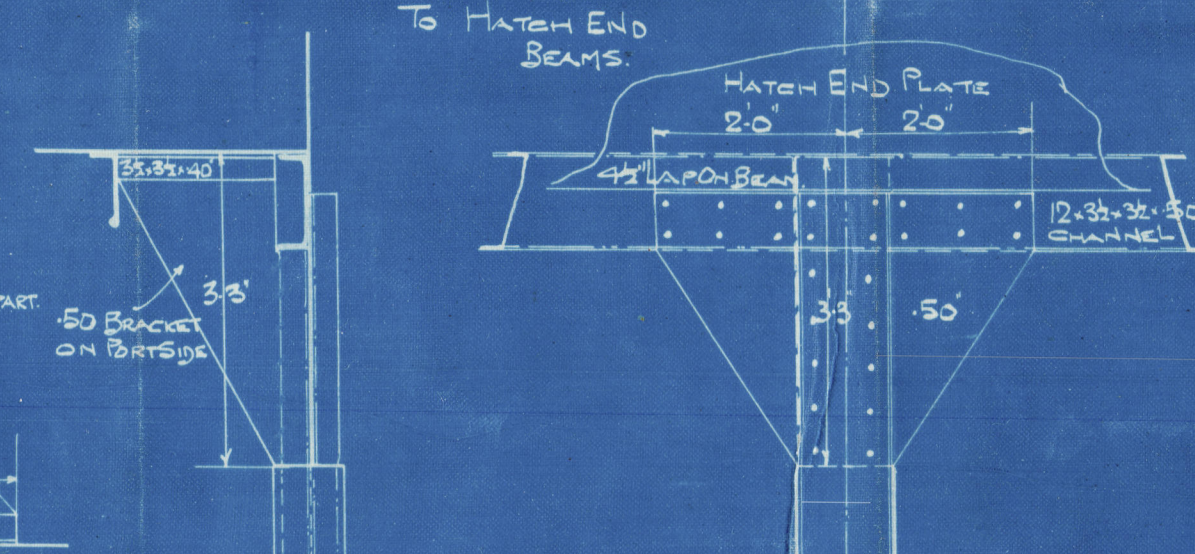
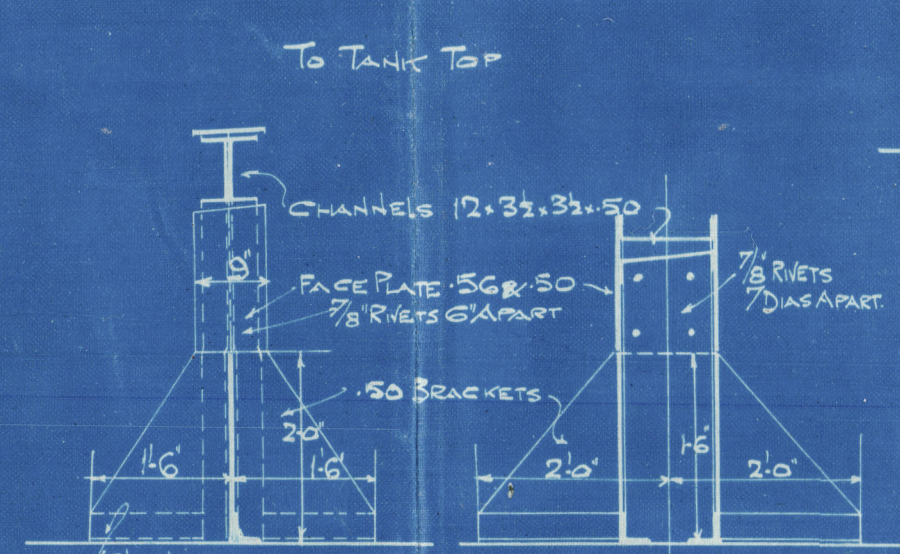


S.S. "MARDINIAN."
AMENDED PROFILE & DECK PLANS.
No 303 H TYPE VESSEL
LENGTH S.P. 303'-0" BREADTH MLD 42'-9" DEPTH MLD 23'-0"

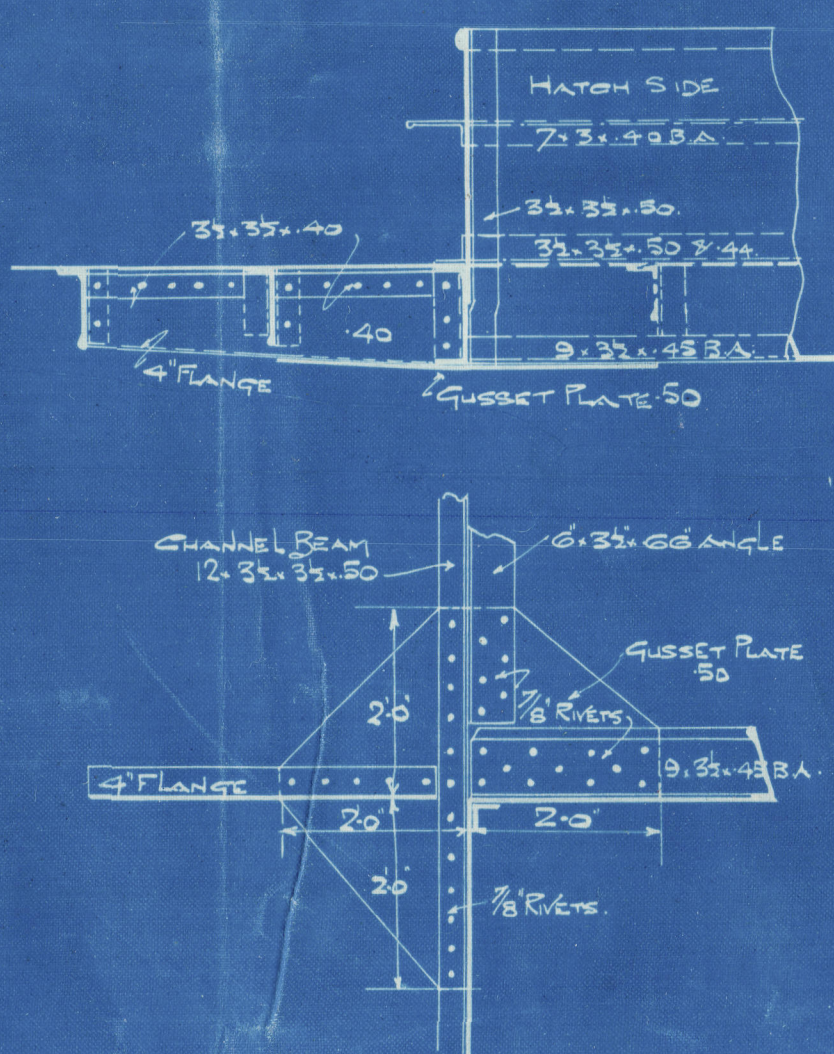

S.P. AUSTIN & SON.

— No 303. —

PROFILE & DECKS.

(AS BUILT)

S.S. "MARDINIAN."

SLD RPT No 27606

W 55 - 0181



© 2021

Lloyd's Register
Foundation