



LENGTH 154'-3" BREADTH 30'-0" x ~~10'-0"~~ DEEP. (47.02 M x 9.14 M x ~~3.05 M~~ DRAFT 1.98 M)
 LOADED DRAFT = 6'-6" ~~9'-0"~~
 SCALES: 1/4" = 1'-0" & 1/2" = 1'-0"
 1/48 & 1/24

Particulars of equipment to be submitted.

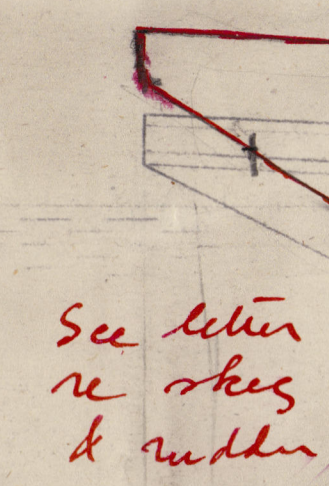

ALL RIVETS TO BE $\frac{3}{4}$ " DIAM. SPACED $4\frac{1}{2}$ " DIAS. IN WLT CONNECTIONS
ALL WELDING AS PER RULES. *4 dia in shell & deck joints*

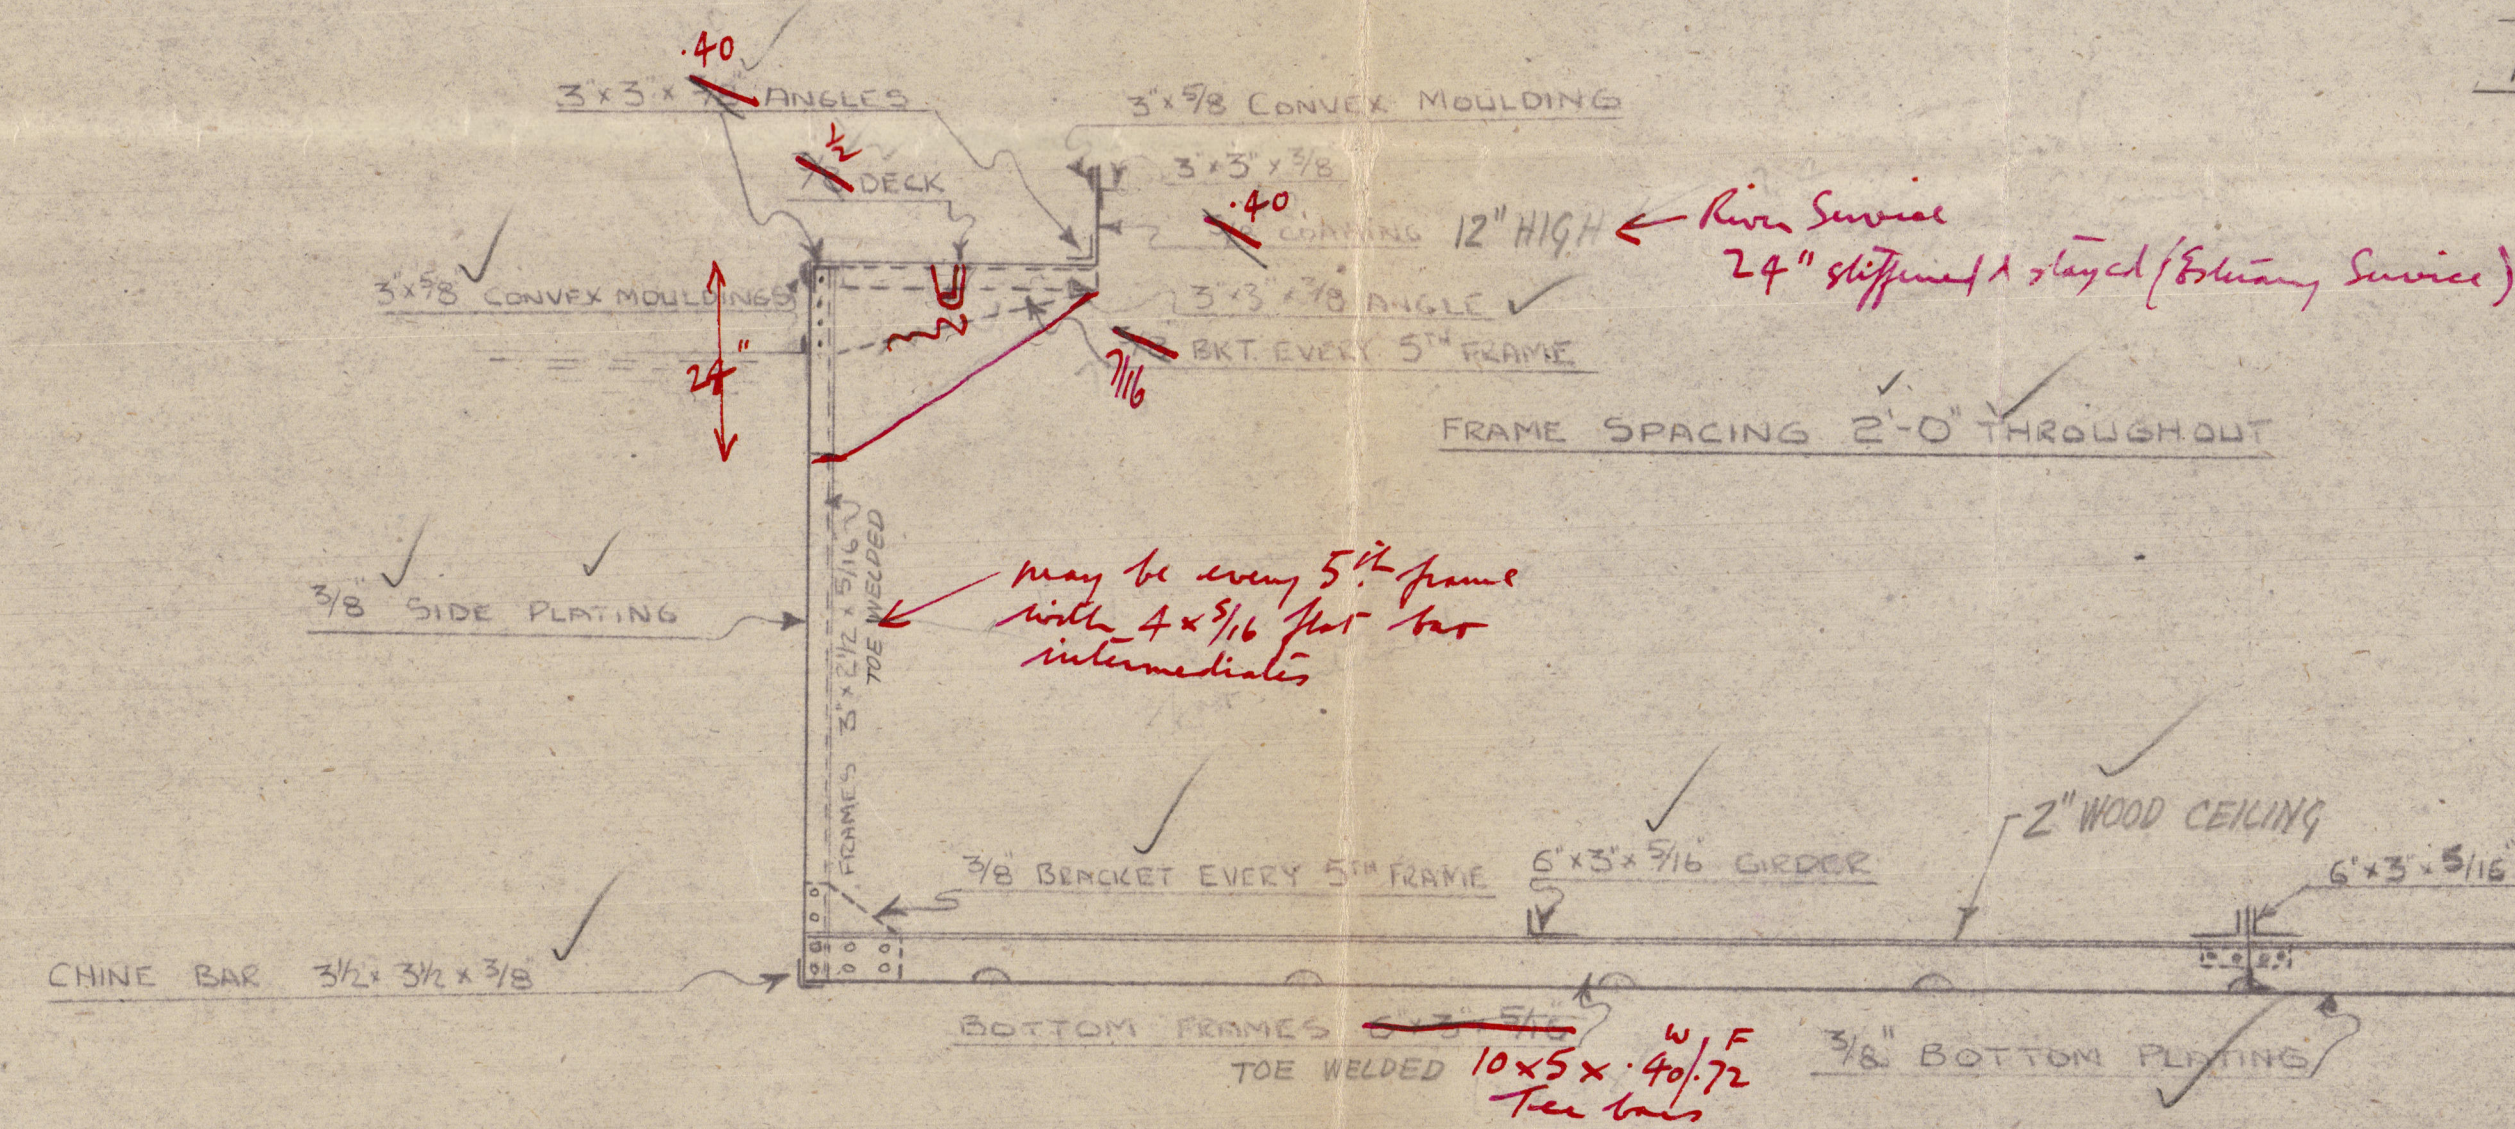

5x 9/16

note

70° at center
10° at sides

= 3% = note

HATCH BOARD

4'10 x 9/16

Spaced 5' apart

Hatch covers 2 3/8

& Hatch closing approximates to Rule

$$\frac{24^2 \times 5 \times 5}{50 \times 6} + \frac{12}{8} = 7$$

4. Vessel restricted to River Service
hulls may be $14 \times \frac{7}{8}$ at center & $7 \times \frac{7}{8}$ at ends
with $10 \times \frac{1}{2}$ flats 17×1 thin. Spacing $5' - 0"$
2" cover. Trusslike bottoms & cleats
to be provided.
Shell & deck may also be reduced by $\frac{1}{16}$
for this service.

BROOKE MARINE LTD.
SHIPBUILDERS & ENGINEERS
OULTON ROAD

LOWE STOUT
Lloyd's Register
Foundation
W553-0016

RECORDS DEPT.
LONDON

~~PIONER~~★

38

BROOKE MARINE LTD.

600 TON BARGE

SECTIONS

Lloyd's Register
Foundation

W553-0016