

MIDSHIP SECTION

"INDRASANIHA"

As per spec built

SCALE 1/2" = 1 FOOT

No 262 S.S.

To Class 100 A Lloyds 3 Tonnage Rule

Naturals
1/2 Depth = 54.02
1/2 Breadth = 24.52
Depth = 33.23

111.77

104.77 = Framing No

x 408.08


42754.5 = Plating No

Proportions
Depth to Upper Deck = 12.28
" " " " " " = 16.80
Breadths = 8.32

Equipment

111.77 x 408.08 = 45611 + (1/8 of 45611 x 225 / 408.08) = 48754.5 approx

2 Bowers stockless, 65 1/2 cwt
1 Bower ea stock 43 1/2
1 Stream --- 15 1/4
1 Hedge --- 7 1/2
270 fathoms 2 1/16 Stay Chain Cable
90 --- 1 1/16 Stay Wire
120 --- 5 Steel Wire
2 @ 90 fathoms 2 1/8
2 @ --- 2 1/8

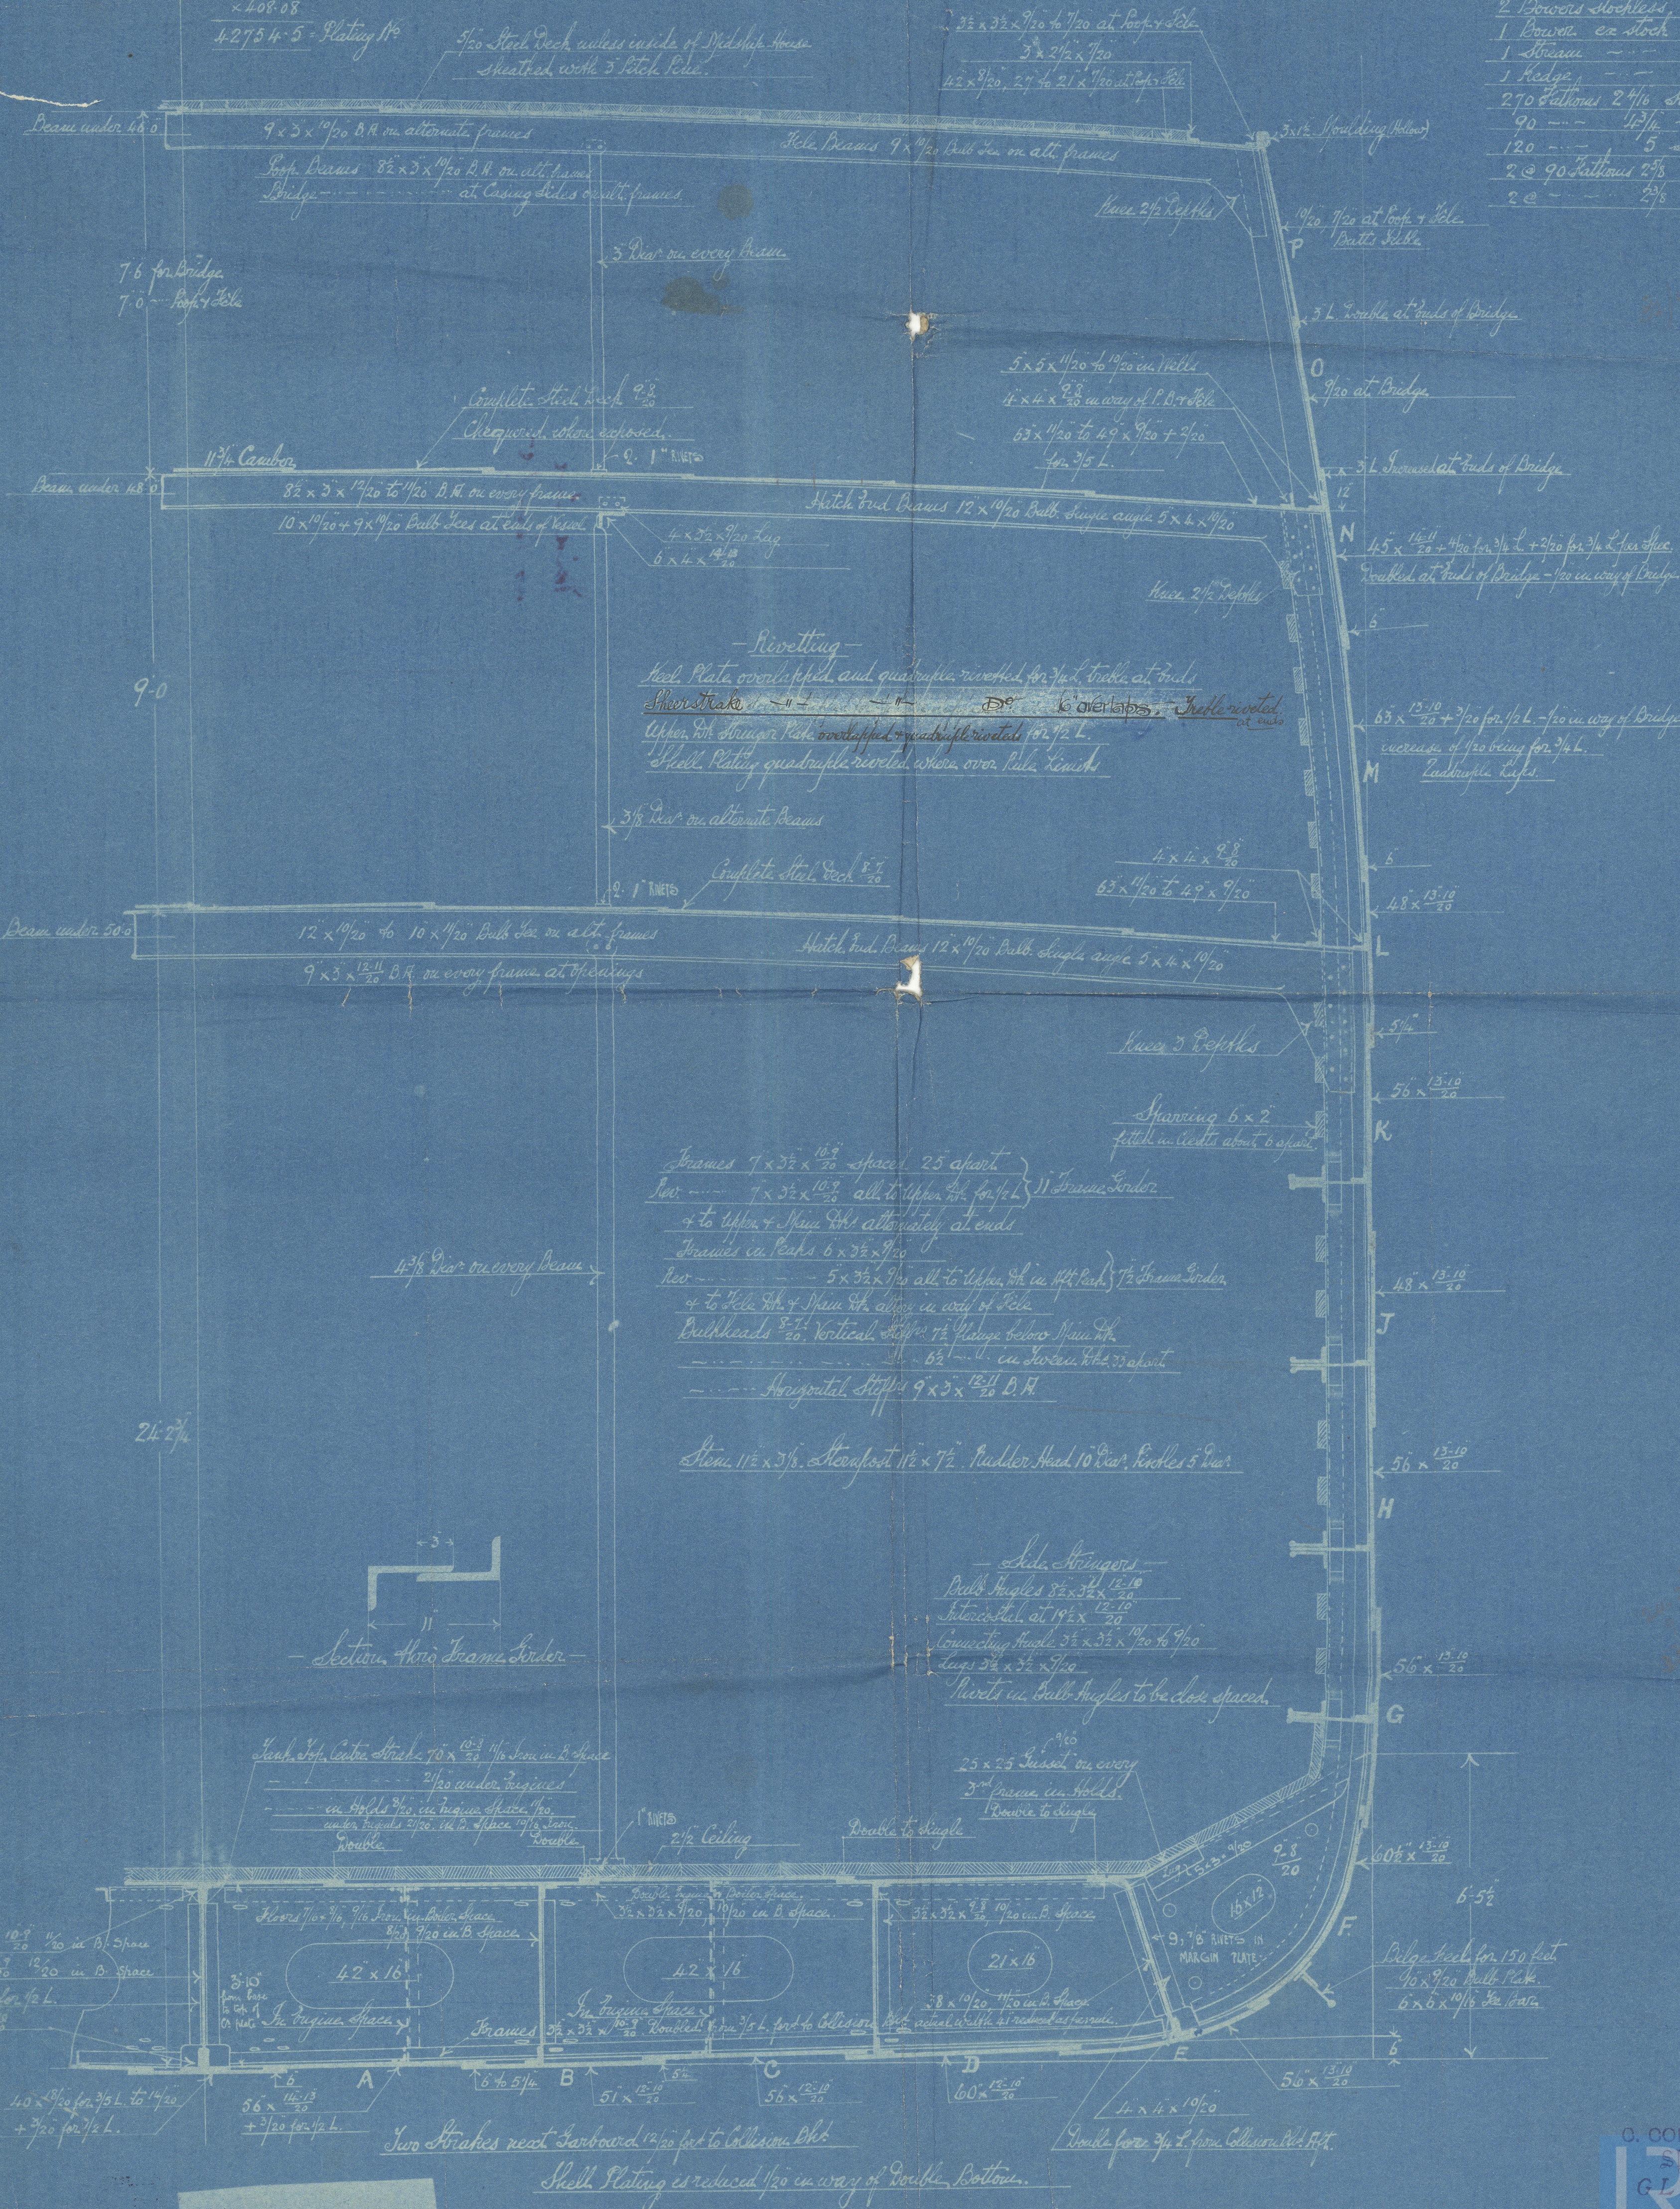

O. CONNELL & CO.

Shipbuilders,

GLASGOW

Lloyds Register

Foundation

W551-0147

C. Connell ob:
no 262 2/5
'Inarasamha'
Gript no 19303



0
Mia Lee
as Built.

2/- 54-4-0 Jugoslavia

RETAIN



© 2021

W558-0197

Lloyd's Register

Foundation