


PROFILE AND DECK PLANS
 PLAN SHEWING UNDER DECK GIRDER, STANCHIONS ETC
 DIMENSIONS - 390' 0" x 52' 0" x 30' 3" MOULDED.
 SCALE 1/8" = 1' 0"

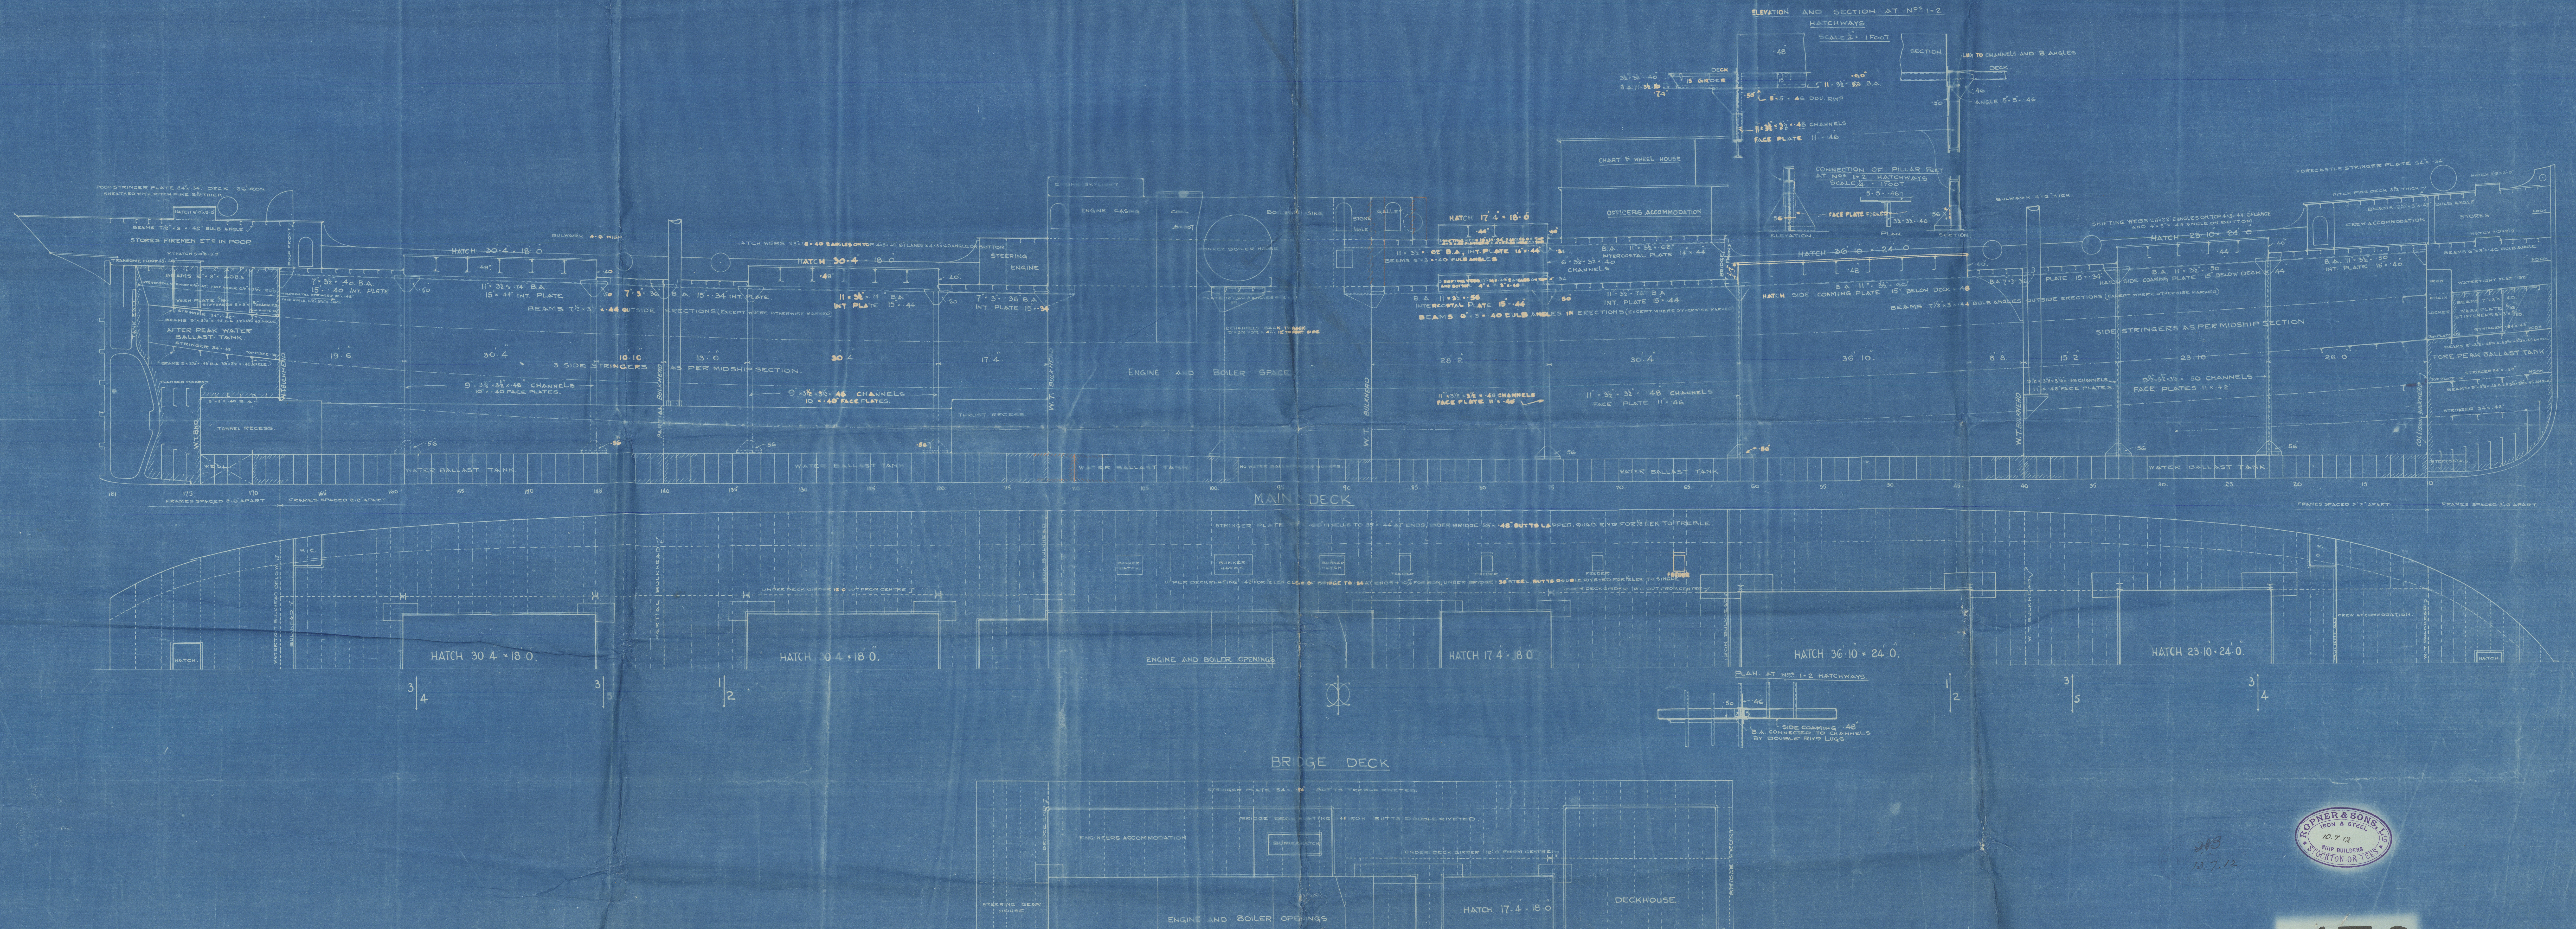

470.

Roper Hon. 1d


No 470

Profit & ducks as built

S/L. Wickenham.

Ind. Report 7/4 5d

RETAI

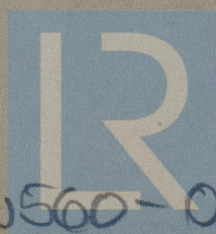

© 2020

Lloyd's Register
Foundation

W560-0032