


25 - 9 - 02
30 - 9 - 02
17 - 10 - 02
3 - 12 - 02
6 12 - 02
16 12 02
24 - 12 - 02
8 1 - 03.

As Built




E. H. 19/8/05

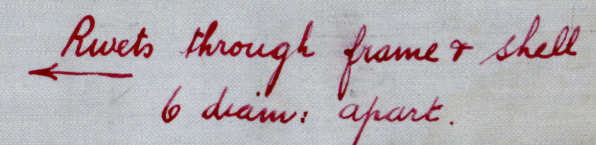

RETAIN

Profile as built.

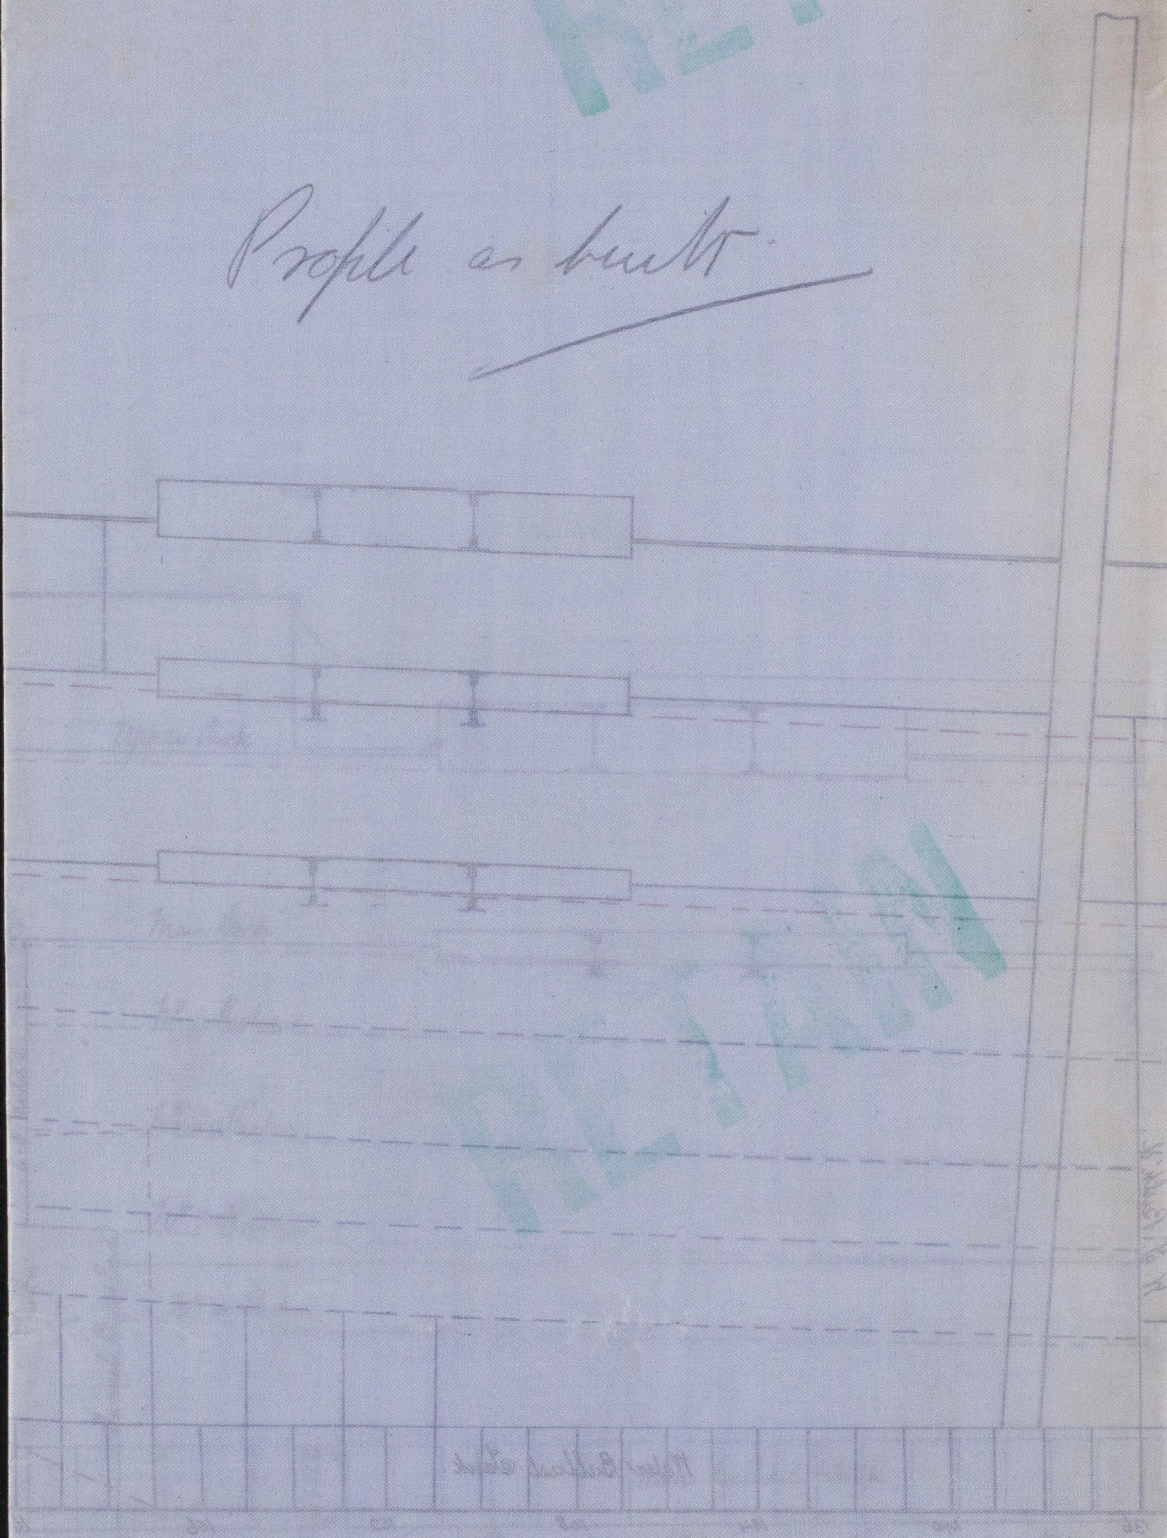

50/50/25
1980



© 2020

Lloyd's Register

W508 Foundation 0086