


18.3.03
8.4.03
5.5.03
9.1.04


Steel Twin Screw Steamer — $R^{\circ} 403$
460'0" x 55'6" x 36'0"
Scale 1/2 Inch = 1 Foot.

Alex. Stephen & Sons Ltd.
SHIPBUILDERS & ENGINEERS,
GLASGOW
DRAWING NO 2686
13/3/03.

Section in way of
Boiler Space

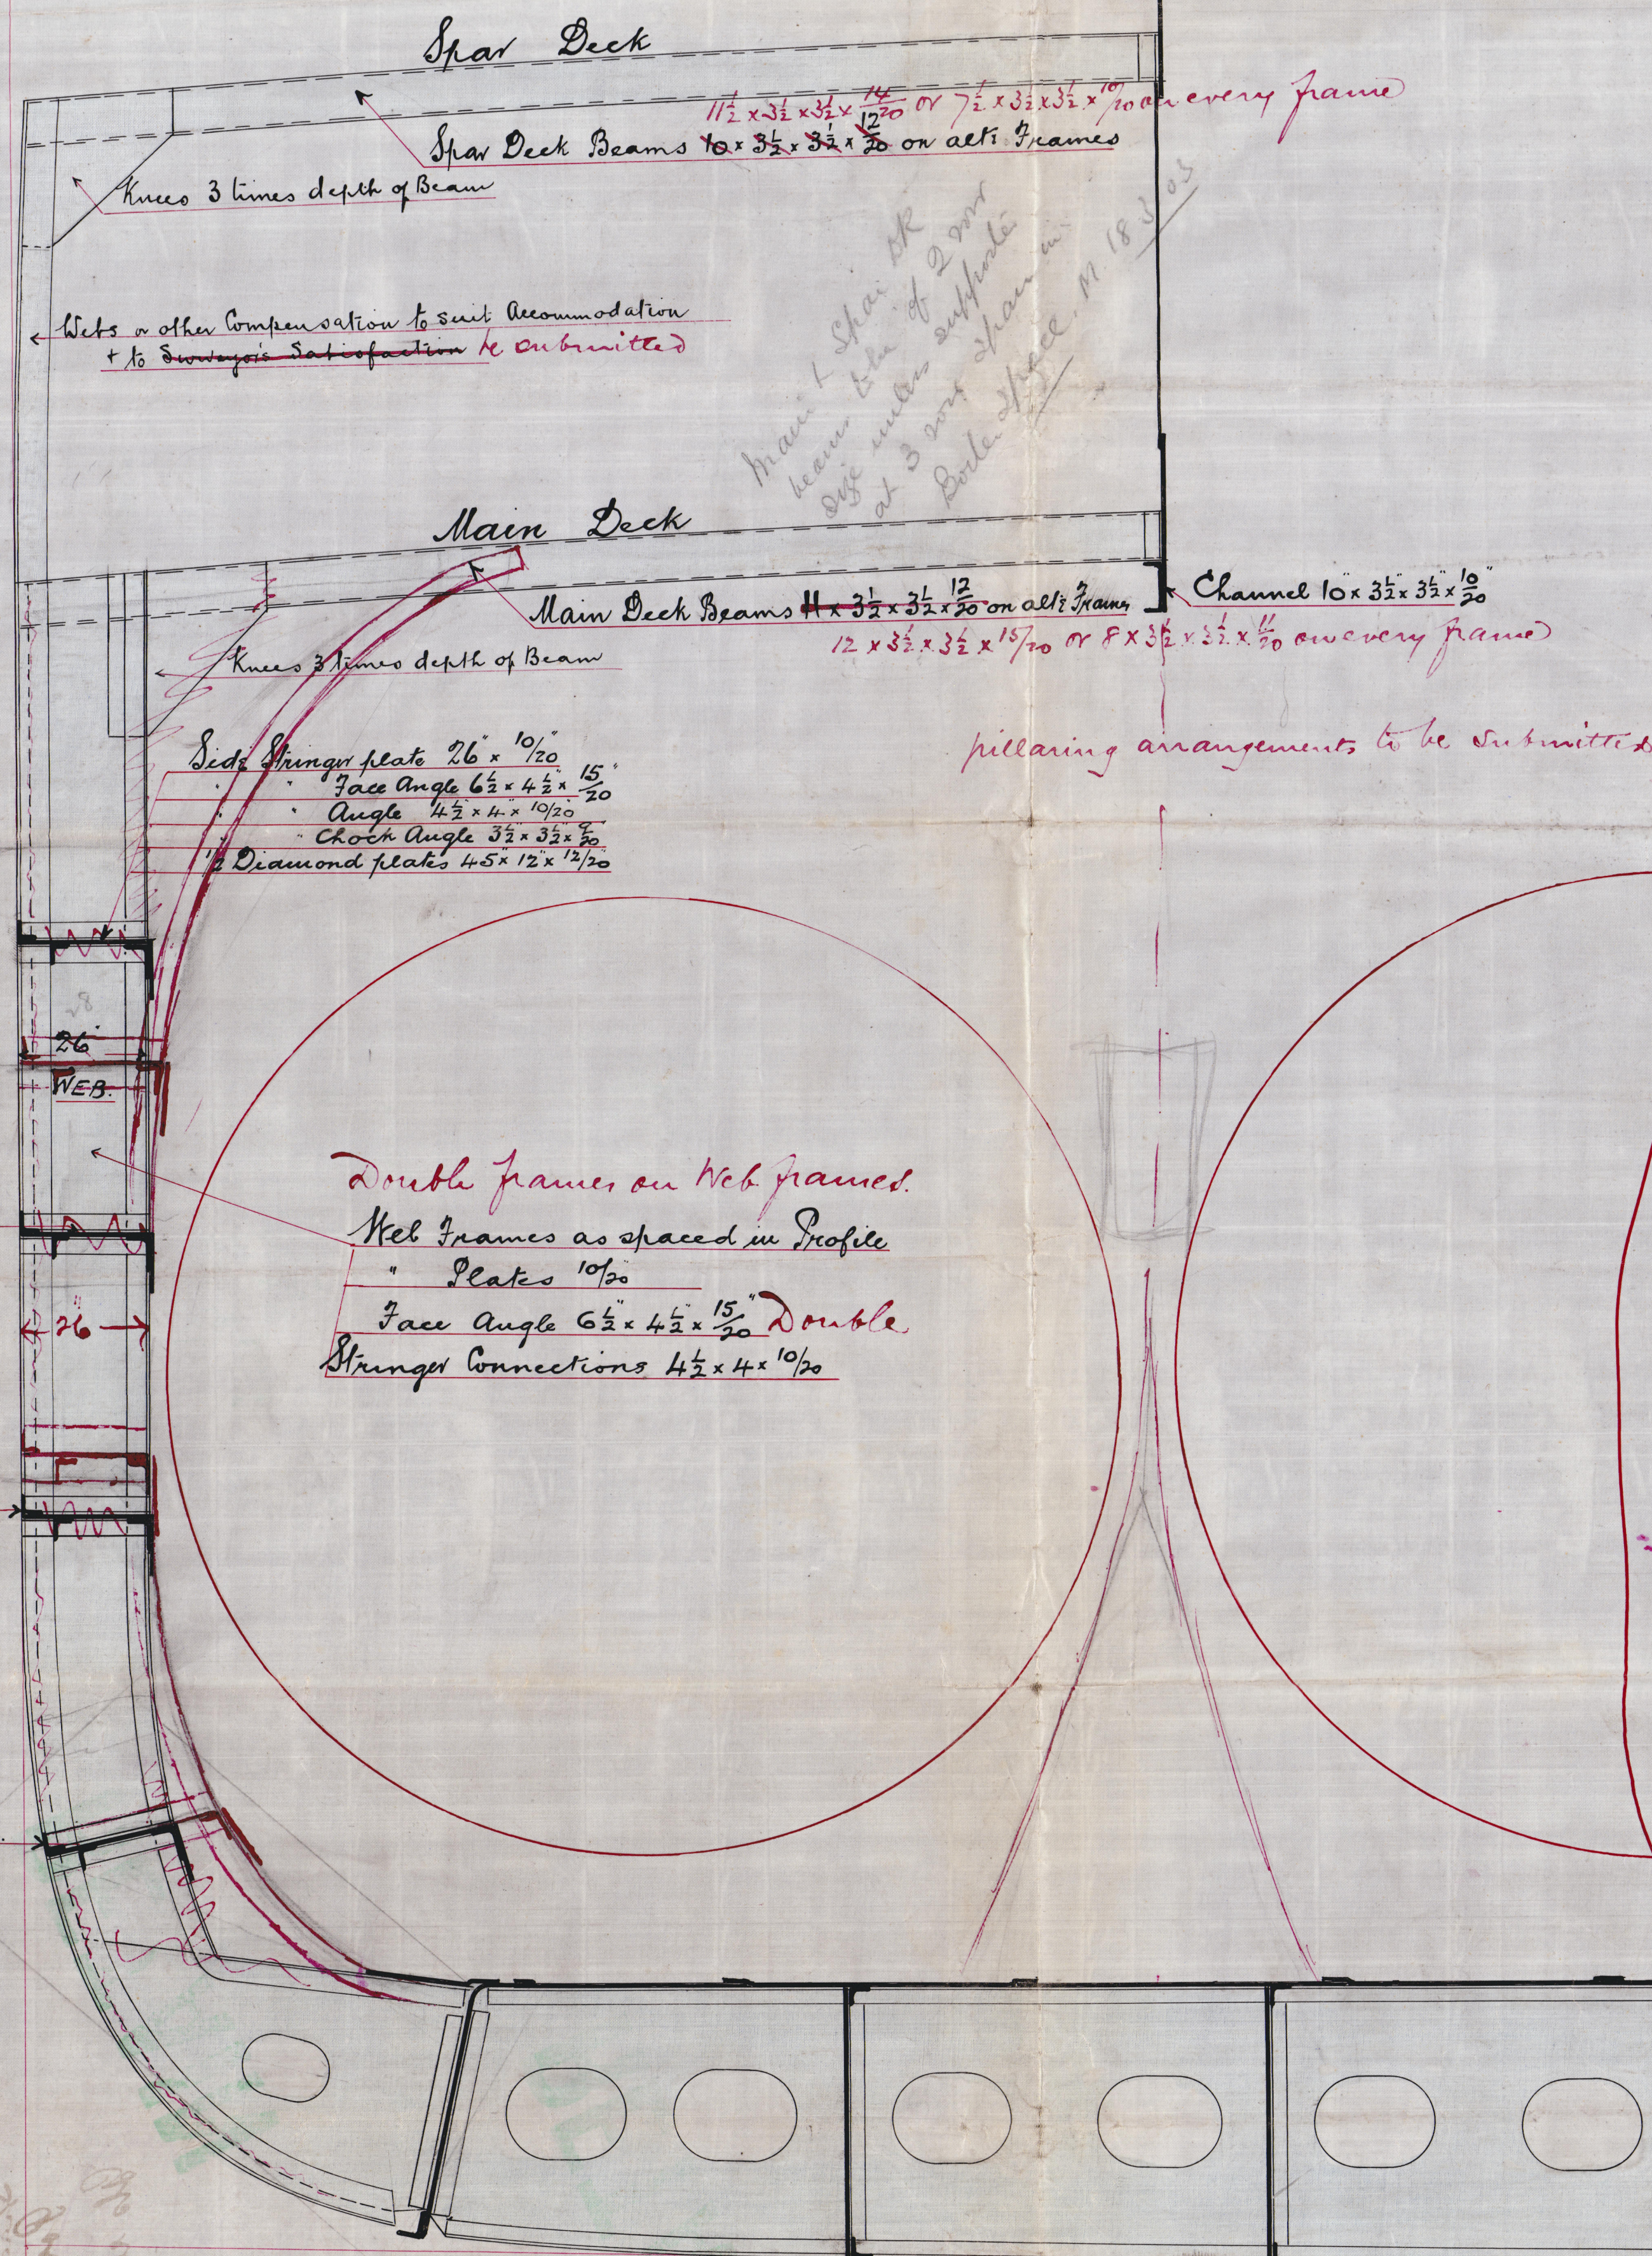

Section in way of
Engine Space

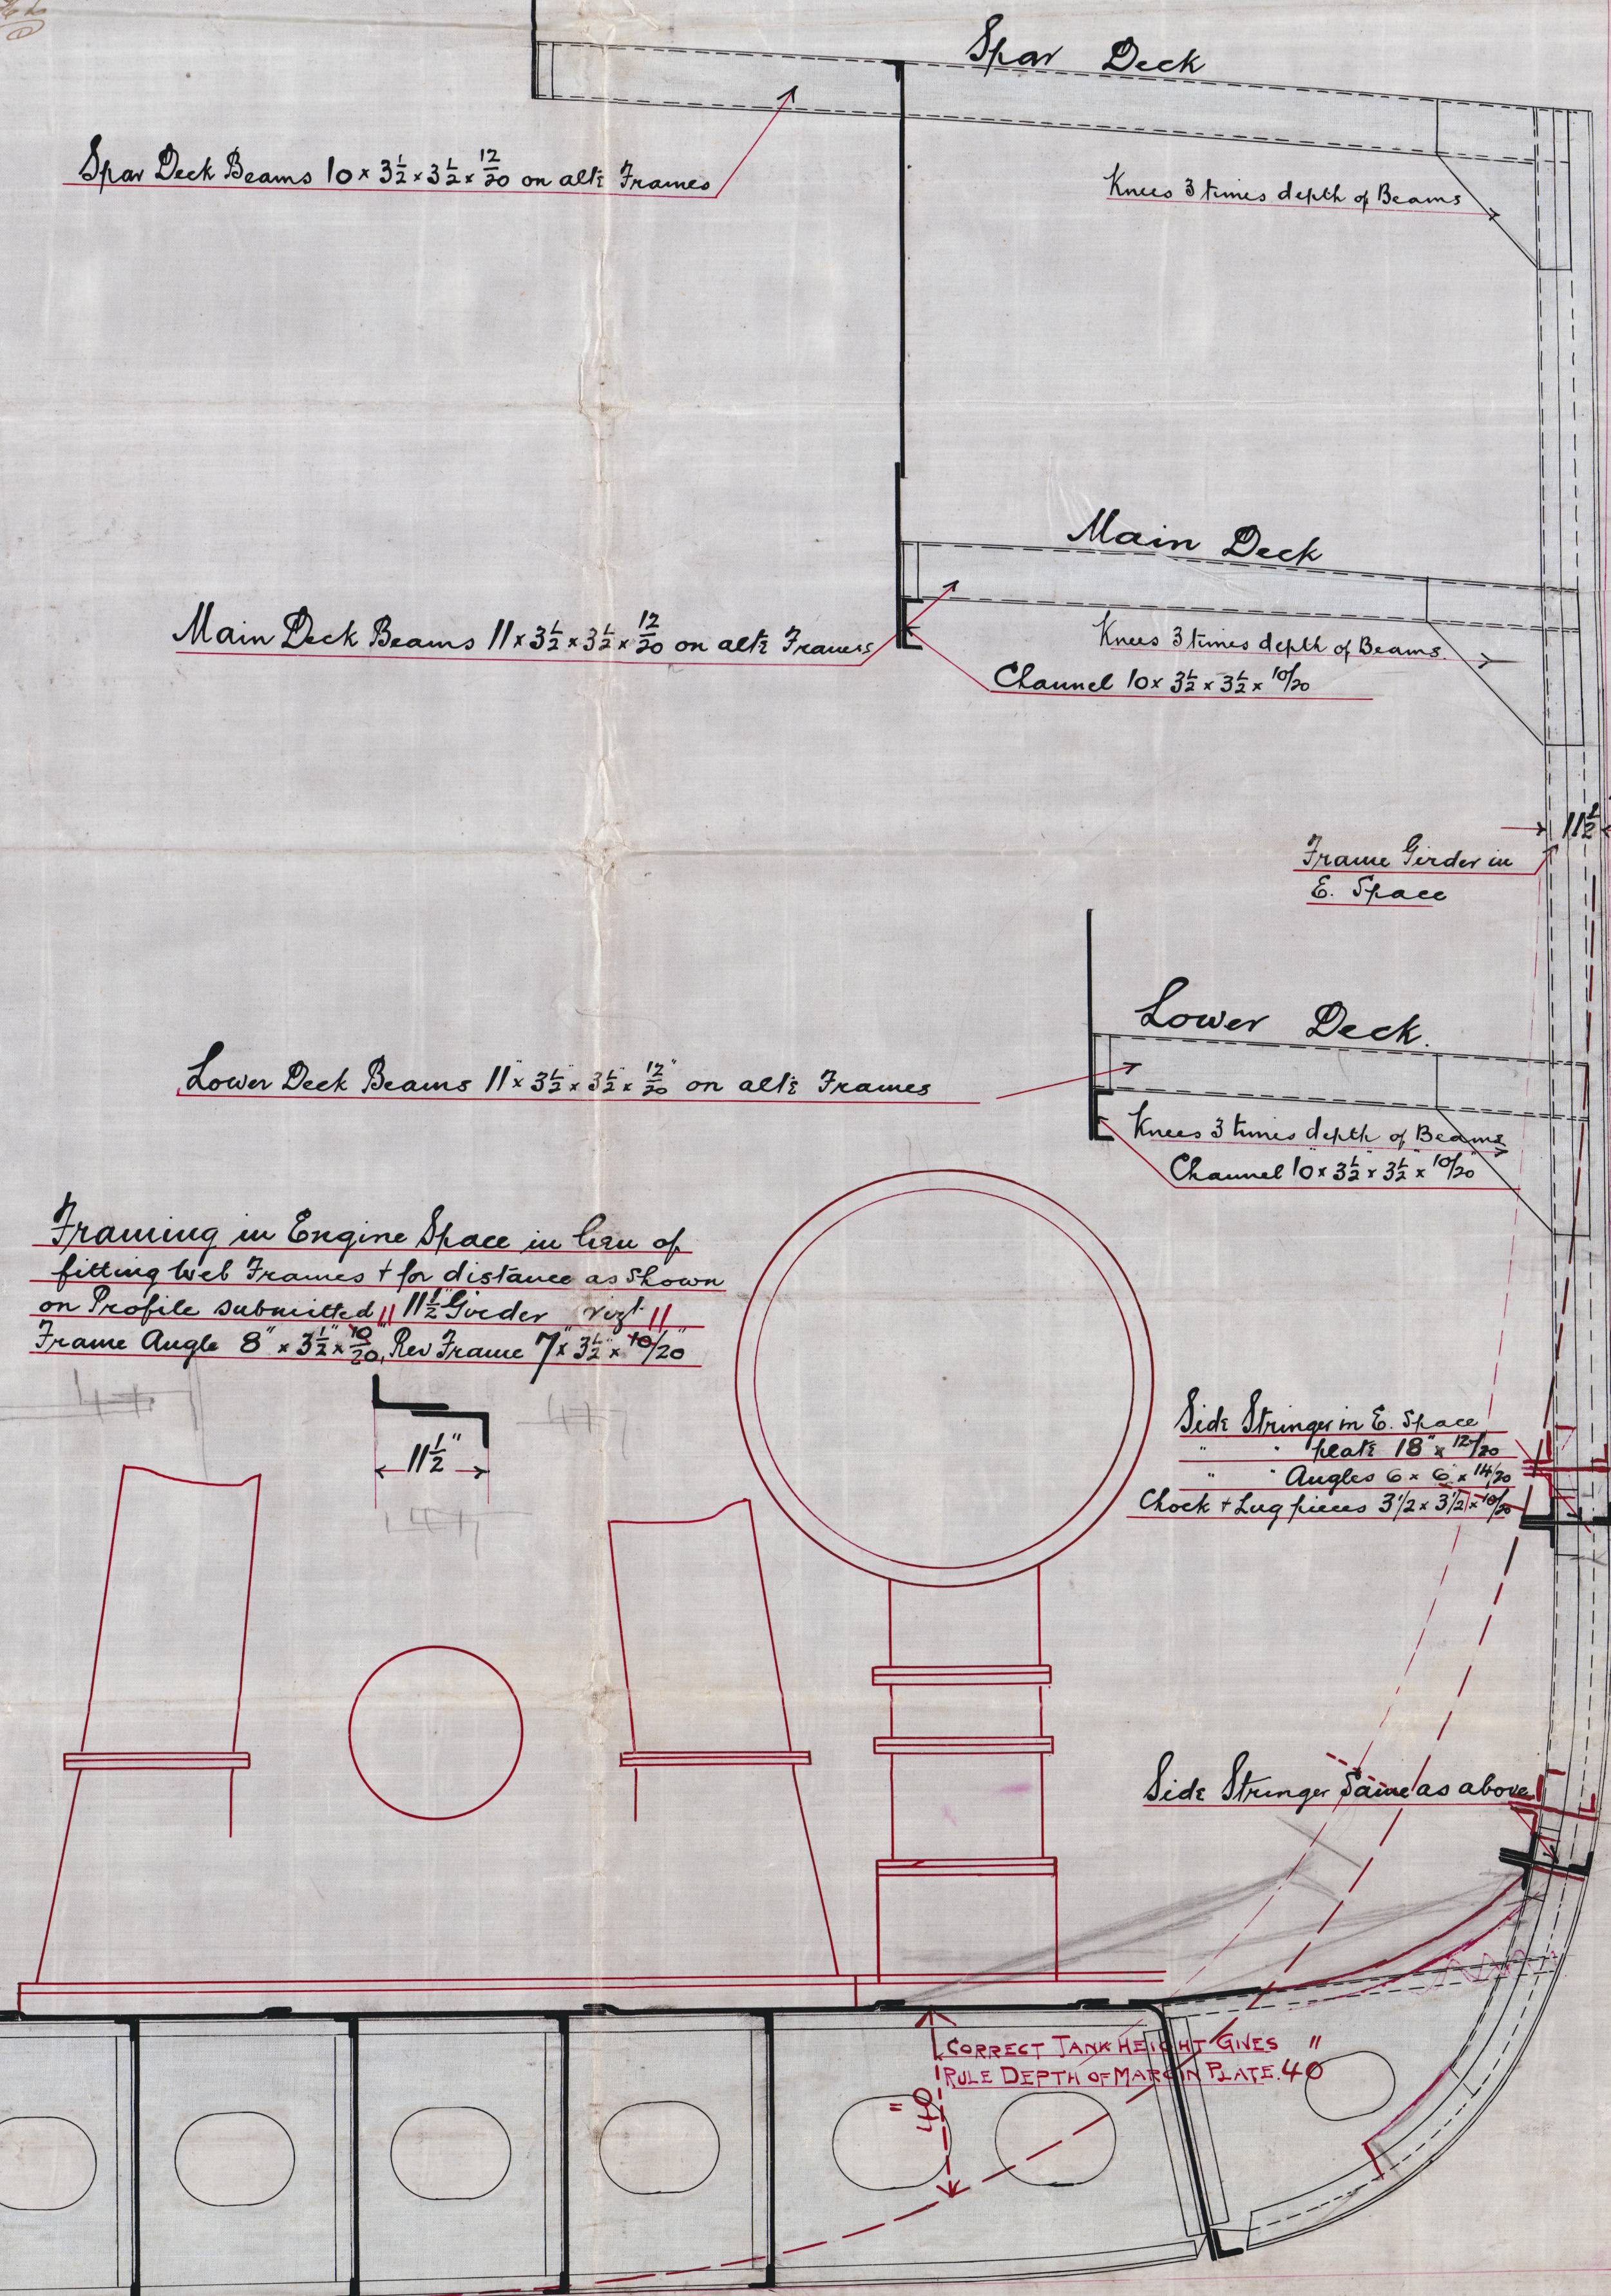

Dotted Red Line is a Section of Ship at Frame No 62.
Double Bottom has been made to suit Machinery in E & B Spaces
not increased in depth over Rule requirements

a. Stephen & Son

T. S. N^o 403.

457.96 x 55.24 x 29.12.

Section in Supine
Space & Boilers Space.

Port Kingston

Gls report No 21986.



© 2021

Lloyd's Register
Foundation