

8/6/07

TO PASS LLOYDS SURVEY.

180 LBS WORKING PRESSURE 360 LBS TEST PRESSURE.



PARTICULARS OF MATERIAL

MASSOLL & POLLUCK LTD.
SOUND RECORD
DRAWING
DRAWN BY
CHECKED BY
TITLED BY *A. Hall 17 June 07.*
CHECKED BY *J. H. P. 16 June 07.*

SHEWING STAYS IN SHELL

Enclosure from
MACCOLL & POLLOCK Ltd.,
To Messrs. Lloyd
W 611-0072 1/3

NOTE - BOILER TO BE HAND CAULKED ROUND CIRCUMFERENTIAL SEAMS
1) ROUND TURNACE MOUTHS.

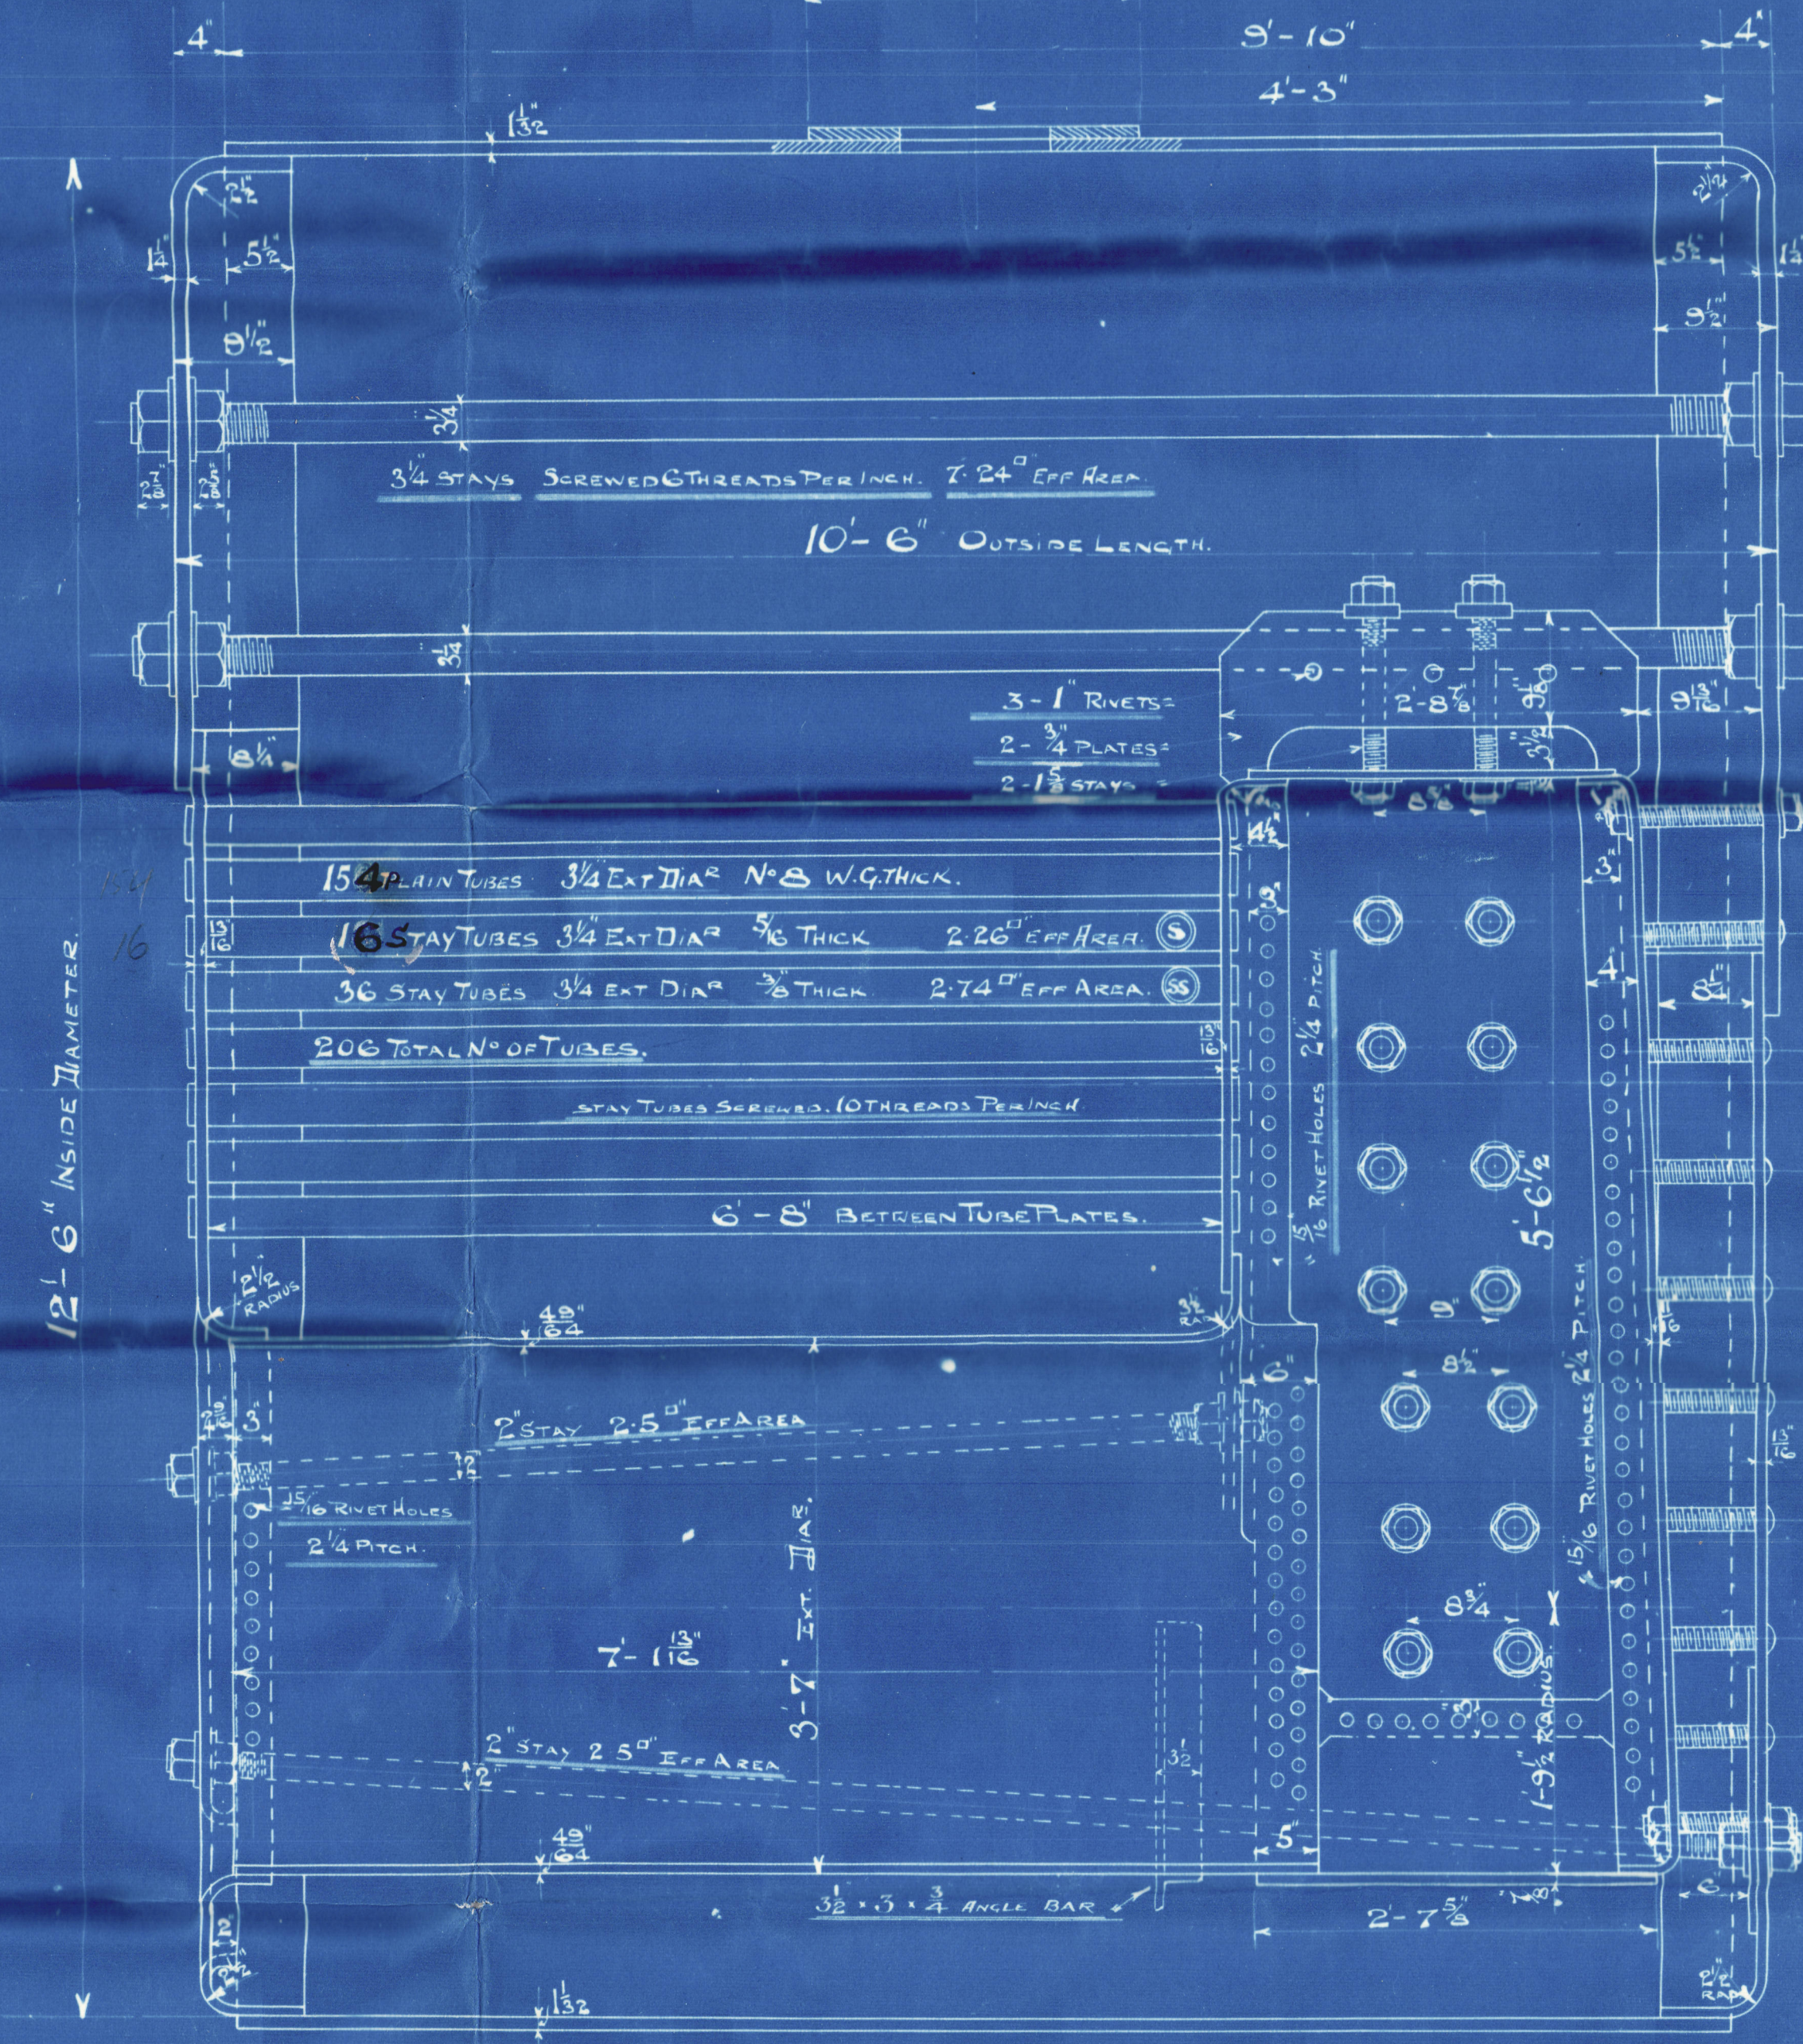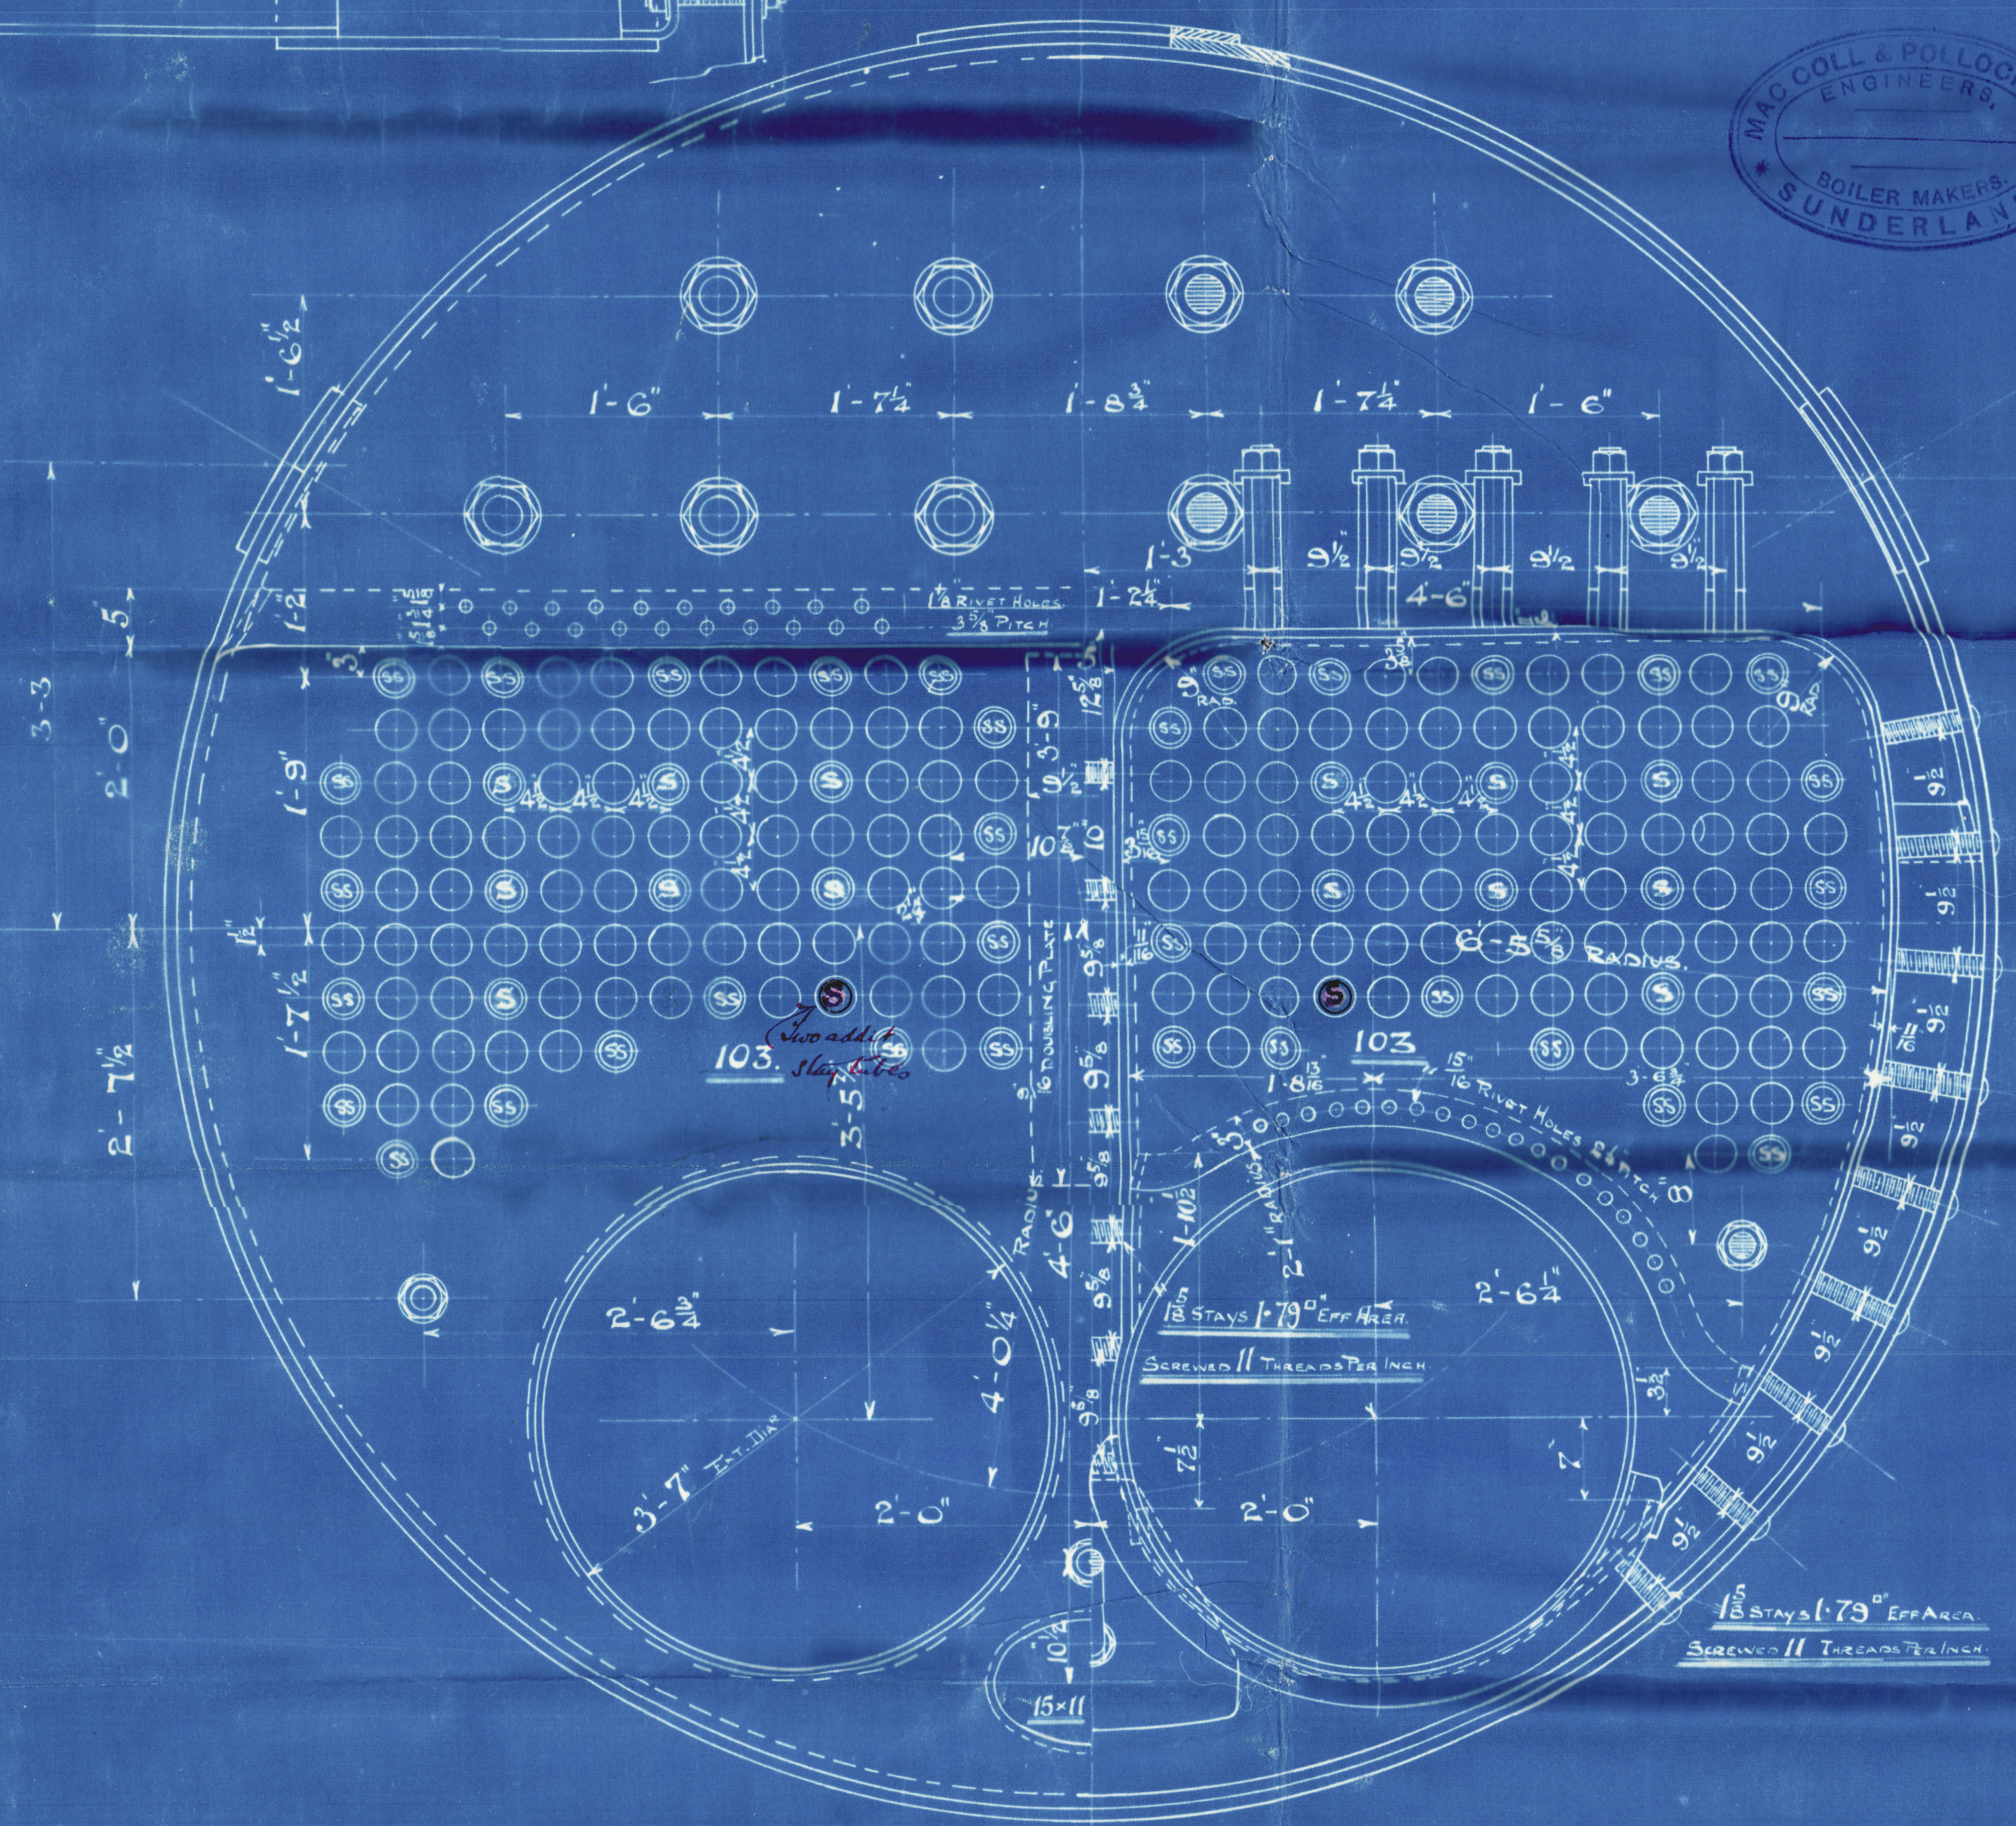

HEATING SURFACE.

<u>TUBES</u>	1168
<u>TURNAGES</u>	75
<u>BACK TUBE PLATES</u>	35
<u>FRONT TUBE PLATES</u>	23
<u>COMBUSTION CHAMBERS</u>	145

TOTAL 1446 SQFEET.

LLOYDS HEATING SURFACE -- 1423 SQ. FT.

GRATE SURFACE 5'-6" BAR = 38.04 SQFT RATIO $\frac{G^3}{H^3} = \frac{1}{38}$.

FIRE BAR IN TWO LENGTHS.

8/6/07

CONTRACT N° 186-7-

© 2021
Lloyd's Register
Foundation
W611-0072 1/3

180 LBS WORKING PRE

No.	Description
1	SHELL PLATES BUTT STR.
2	COMPENSATING PLATE
3	ALL OTHER PLATES
4	MAIN STAYS
5	SCREWED STAYS
6	RIVETS.
7	TUBES.

1 ROUND TURNACE MOUTHS.



Enclosure from

MACCOTT & POLLOCK Ltd.,

To

Messrs Lloyd

W 611-00072 1/3

S. S. "Saxon"

Sld. S. E. No 25460

S/S "Beatrice"

Sld Rpt. No 23514



~~To be returned to~~

~~Sunderland~~

Baler
180 P.S.I

Wreck Bery 665

RETAIN

W611-0072



© 2021

Lloyd's Register
Foundation

