

Drawn by J. J. J. & Co. No. 210

S.S. CARDIFF CITY.


SCALE 1/2 INCH = 1 FOOT

CLASSED 100 A1 AT LLOYDS AND BUILT UNDER SPECIAL SURVEY.

LENGTH, AS PER RULE	140.89 FT.
BREADTH	23.5 FT. - 5.5 B. IN L.
DEPTH	11.75 FT. - 11.9 D. IN L.
FORECASTLE	22.0 FT. x 7.0 FT. ABOVE MAIN DECK.
BRIDGE	10.5 FT. x 7.0 FT.
RAISED QUARTER DECK	51.25 FT. x 4.0 FT.

NUMERALS

1/2 B	11.75
1/2 G	21.16
D	11.75
44.66 x 140.89	= 6292.14

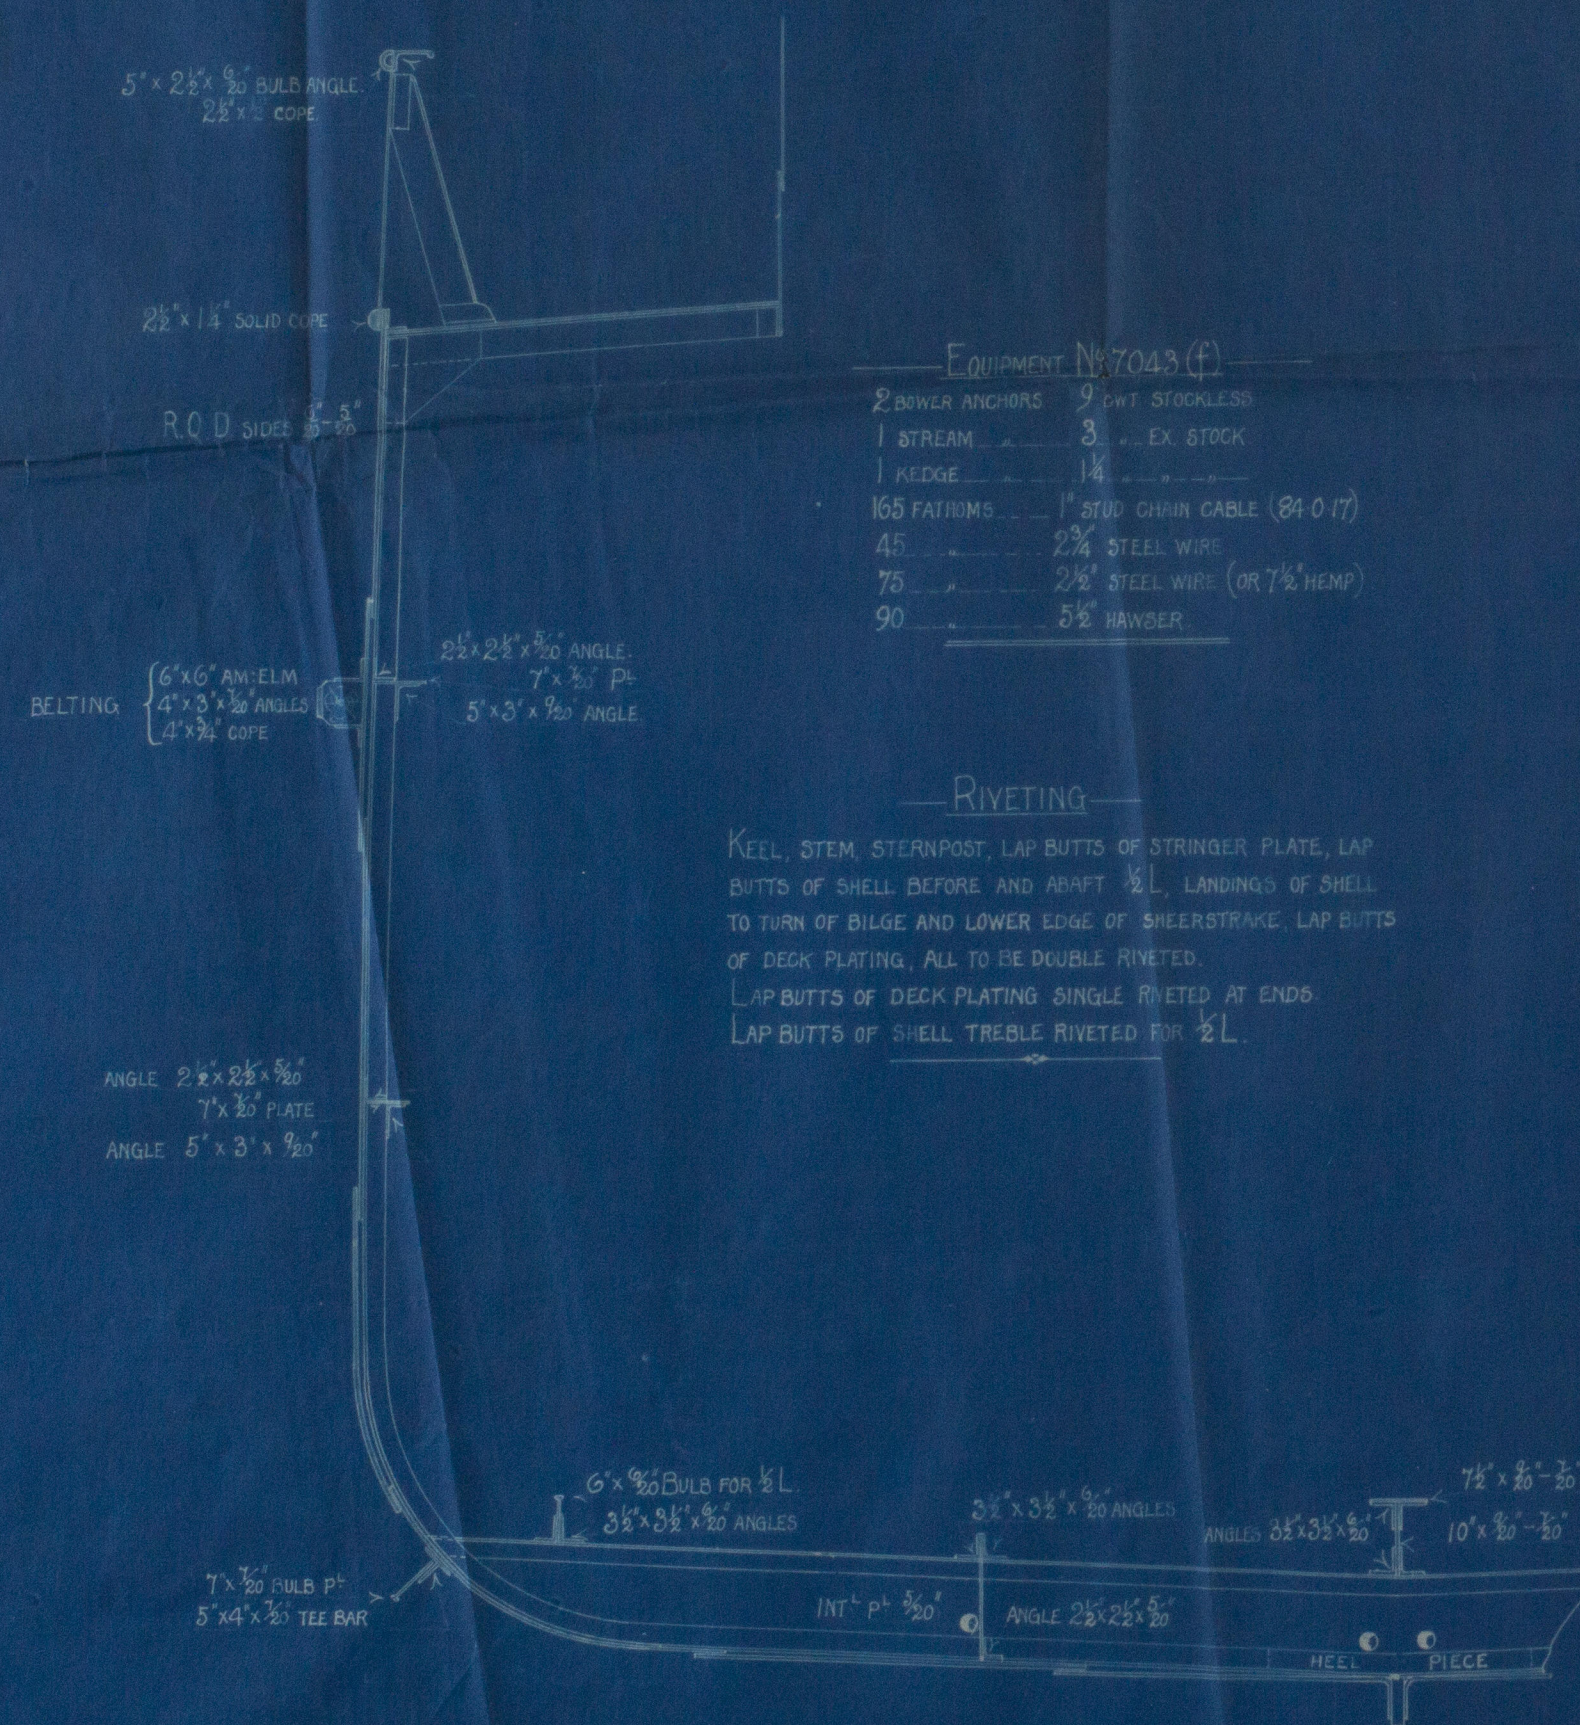


EQUIPMENT No. 7043 (f)

2 BOWER ANCHORS	9 CWT STOCKLESS
1 STREAM	3" EX. STOCK
1 KEDGE	1 1/2"
165 FATHOMS	1" STUD CHAIN CABLE (84 0 17)
45	2 3/4" STEEL WIRE
75	2 1/2" STEEL WIRE (OR 7 1/2" HEMP)
90	5 1/2" HAWSER

RIVETING

KEEL, STEM, STERNPOST, LAP BUTTS OF STRINGER PLATE, LAP BUTTS OF SHELL BEFORE AND AFT 1/2 L. LANDINGS OF SHELL TO TURN OF BILGE AND LOWER EDGE OF SHEERSTRAKE, LAP BUTTS OF DECK PLATING, ALL TO BE DOUBLE RIVETED.
LAP BUTTS OF DECK PLATING SINGLE RIVETED AT ENDS.
LAP BUTTS OF SHELL TREBLE RIVETED FOR 1/2 L.

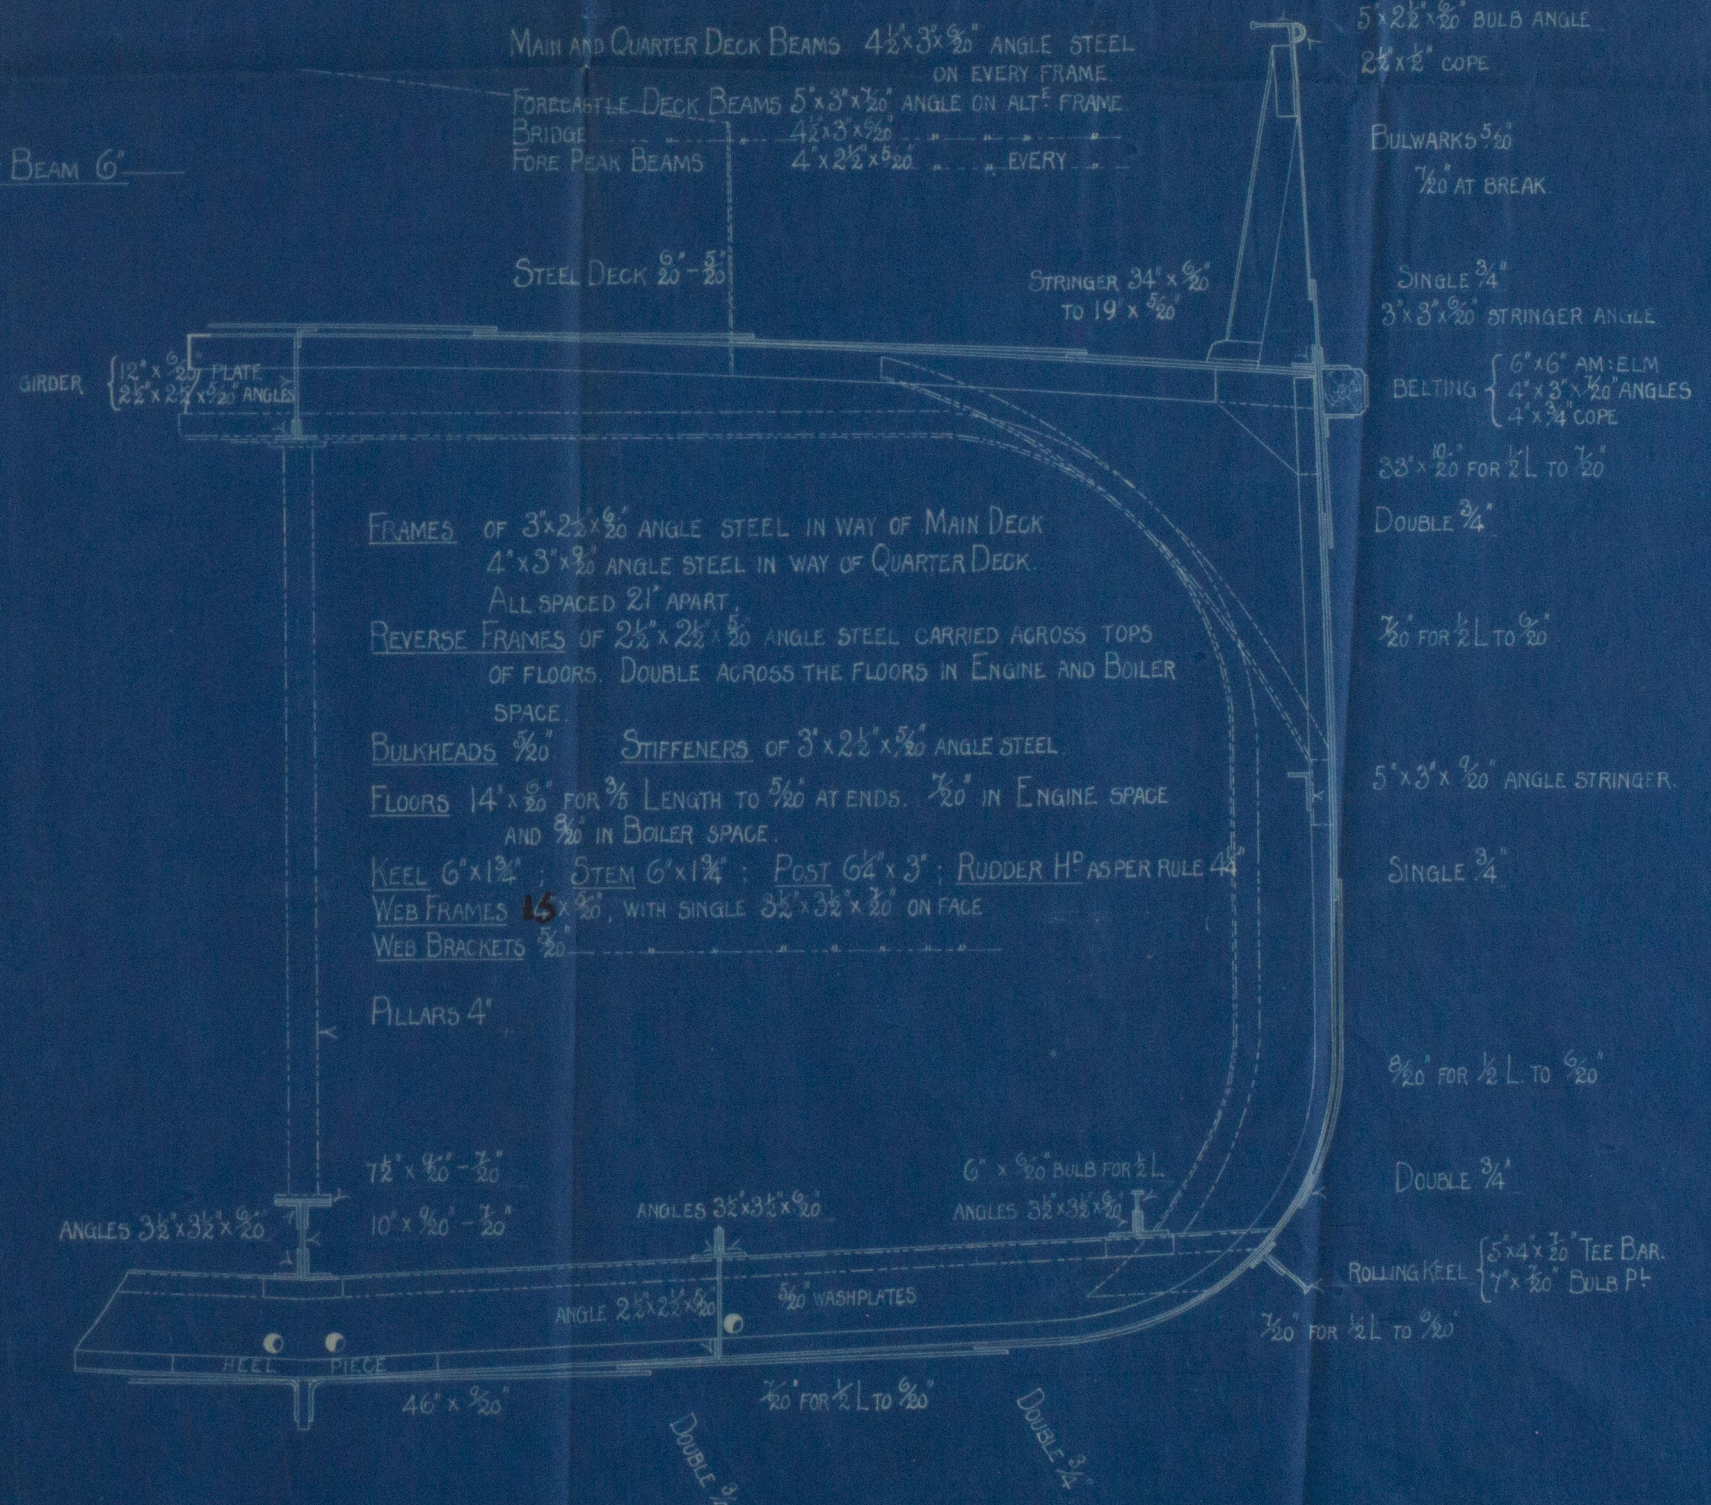


machines Section
as built

Messrs J Fullerton & Co

No 210

s.s. "Cardiff City"
Glasgow Report
N^o 24449

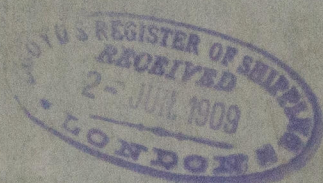

RECEIVED



© 2020

Lloyd's Register
Foundation

W621-0059