


3.12.08

See midship Section as Built

# SECTIONS FOR \$ \$ N° 210

SCALE 1/2 INCH = ONE FOOT

TO CLASS 100 A.I. AT LLOYDS + BE BUILT UNDER SPECIAL SURVEY  
LENGTH AS PER RULE 140.89 FT  
BREADTH 23.5 FT = 5.5 B IN L.  
DEPTH 11.45 FT = 11.9 D IN L.  
FORECASTLE 22'0" x 4'0" ABOVE MAIN DECK  
BRIDGE 10'6" x 4'0"  
RAISED QUARTER DECK 51.25 x 4'0"

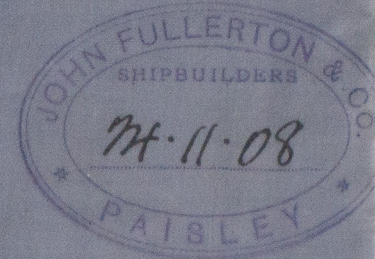

NUMERALS  
28 11.45  
21 16  
D 11.45  
44.66 x 140.89 = 6292.14

ROUND OF BEAM 6"

## EQUIPMENT N° 4043 (f)



2 BOWER ANCHORS 9 CNT. STOCKLESS  
1 STREAM 3 EX STOCK  
1 KEDGE 14  
165 FATHOMS 1" STUD CHAIN CABLE (84 0-14)  
45 2 1/2" STEEL WIRE  
45 2 1/2" (or 1 1/2" HEMP)  
90 5 1/2" HAWSER

## RIVETING

KEEL, STEM, STERNPOST, LAP BUTTS OF STRINGER  
P+ LAP BUTTS OF SHELL BEFORE + ABAFT  
2L LANDINGS OF SHELL TO TURN OF BILGE  
+ LOWER EDGE OF SHEERSTRAKE, LAP BUTTS  
OF DECK PLATING ALL TO BE DOUBLE RIVETED  
LAP BUTTS OF DECK PLATING SINGLE RIVETED  
AT ENDS  
LAP BUTTS OF SHELL TREBLE RIVETED FOR 2L

Frames in way of R.Q. dk.  
4 x 3 x 1/20 angle  
Rev. frames in way of raised  
quarter deck = 2 1/2 x 2 1/2 x 1/20  
top of floors.  
with 2 intercostal side  
stringers + no web frames.

R.Q.D. SIDES  
5/20 - 5/20

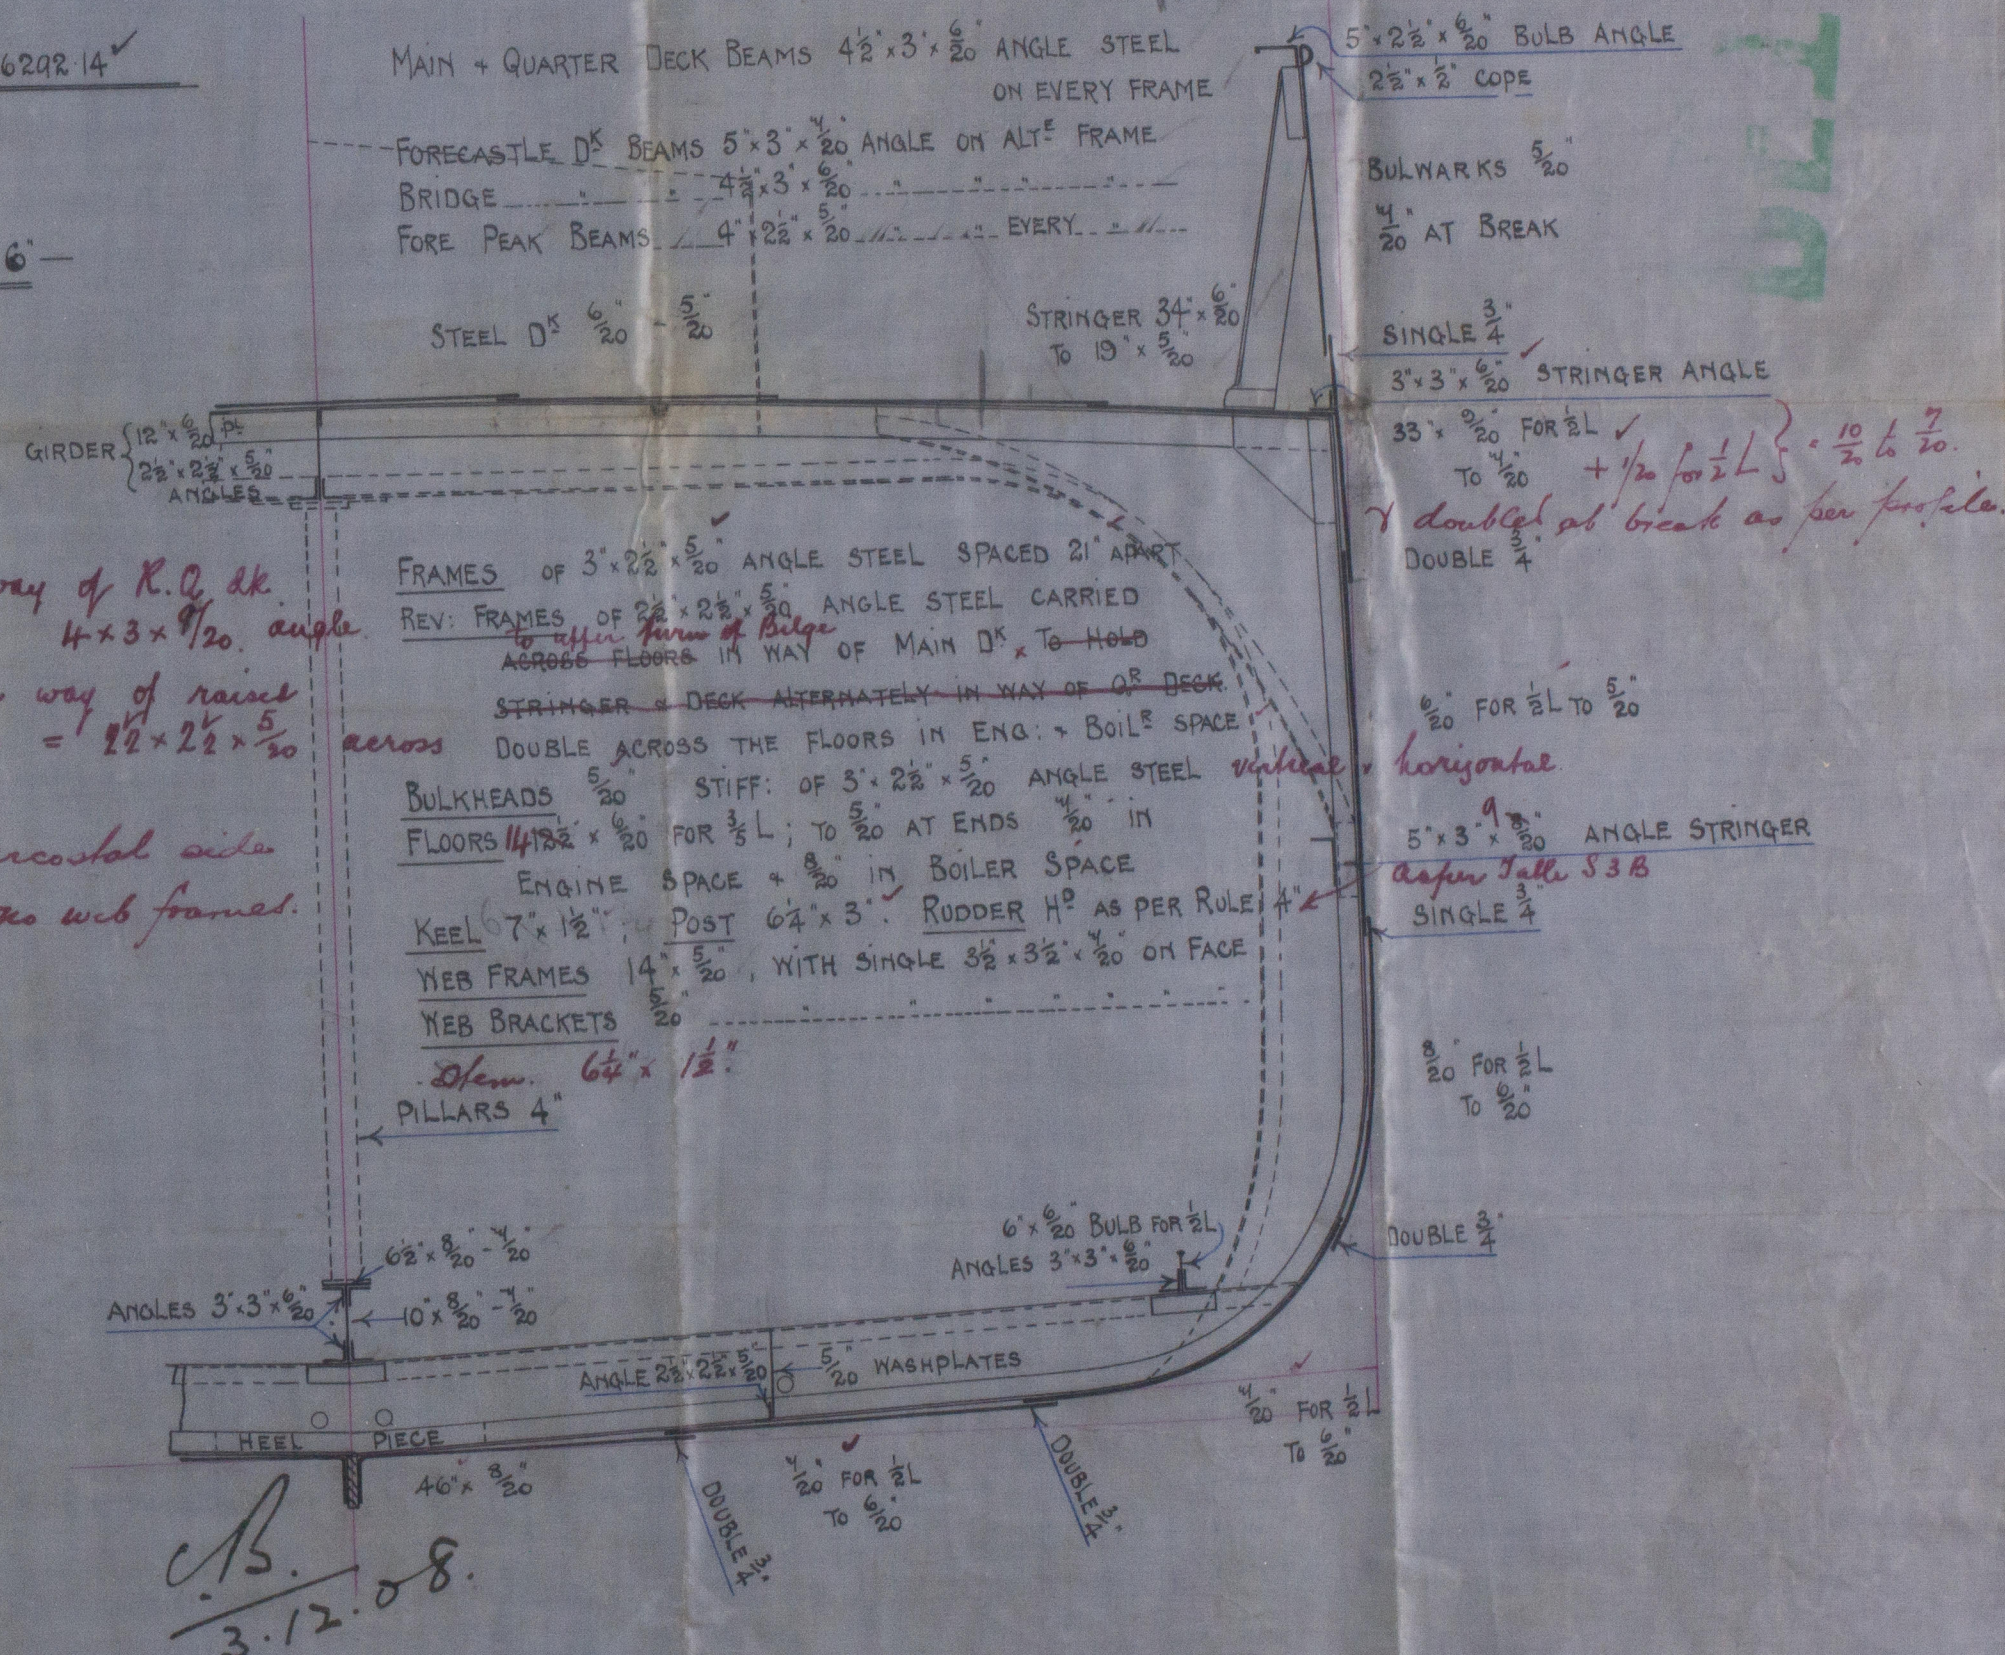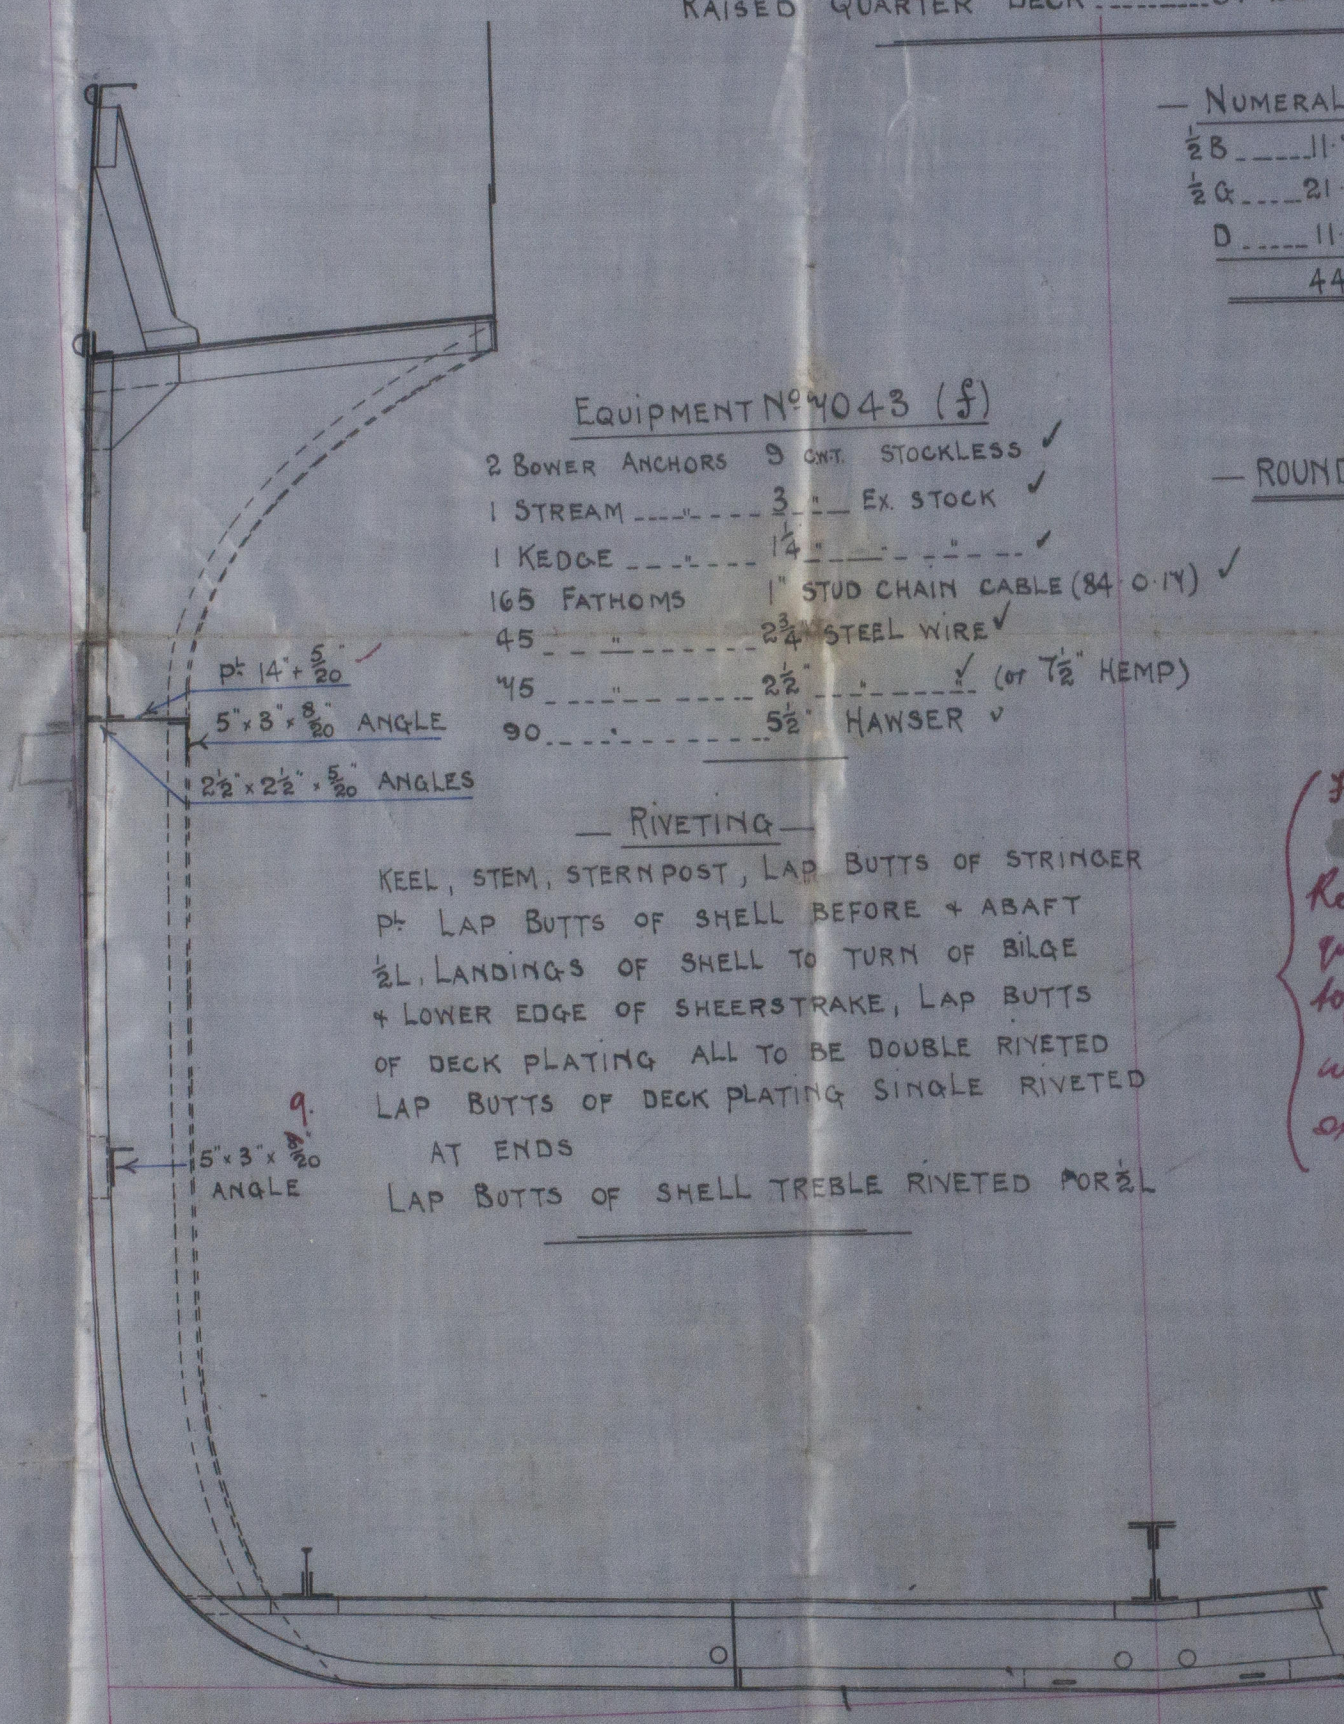

C.B.  
3.12.08



S.S. "Landolt City"  
Ylaagow Report  
No. 27449.

Midship Section

Messrs J Fullerton & Co.  
S. S. No 210

See Midship Section  
as Built

© 2020

Lloyd's Register  
Foundation

W621-0062