


N° 929 PROFILE DECK PLANS & TRANSVERSE FRAMING IN POOP BRIDGE & FORECASTLE DIMENSIONS: LENGTH BP 340'0 BREADTH EX. 52'8 1/2 DEPTH MLD 24'3

SCALE 3/4" = 1' FOOT
 LAMERWOOD SYSTEM (PATENT)



N° 929

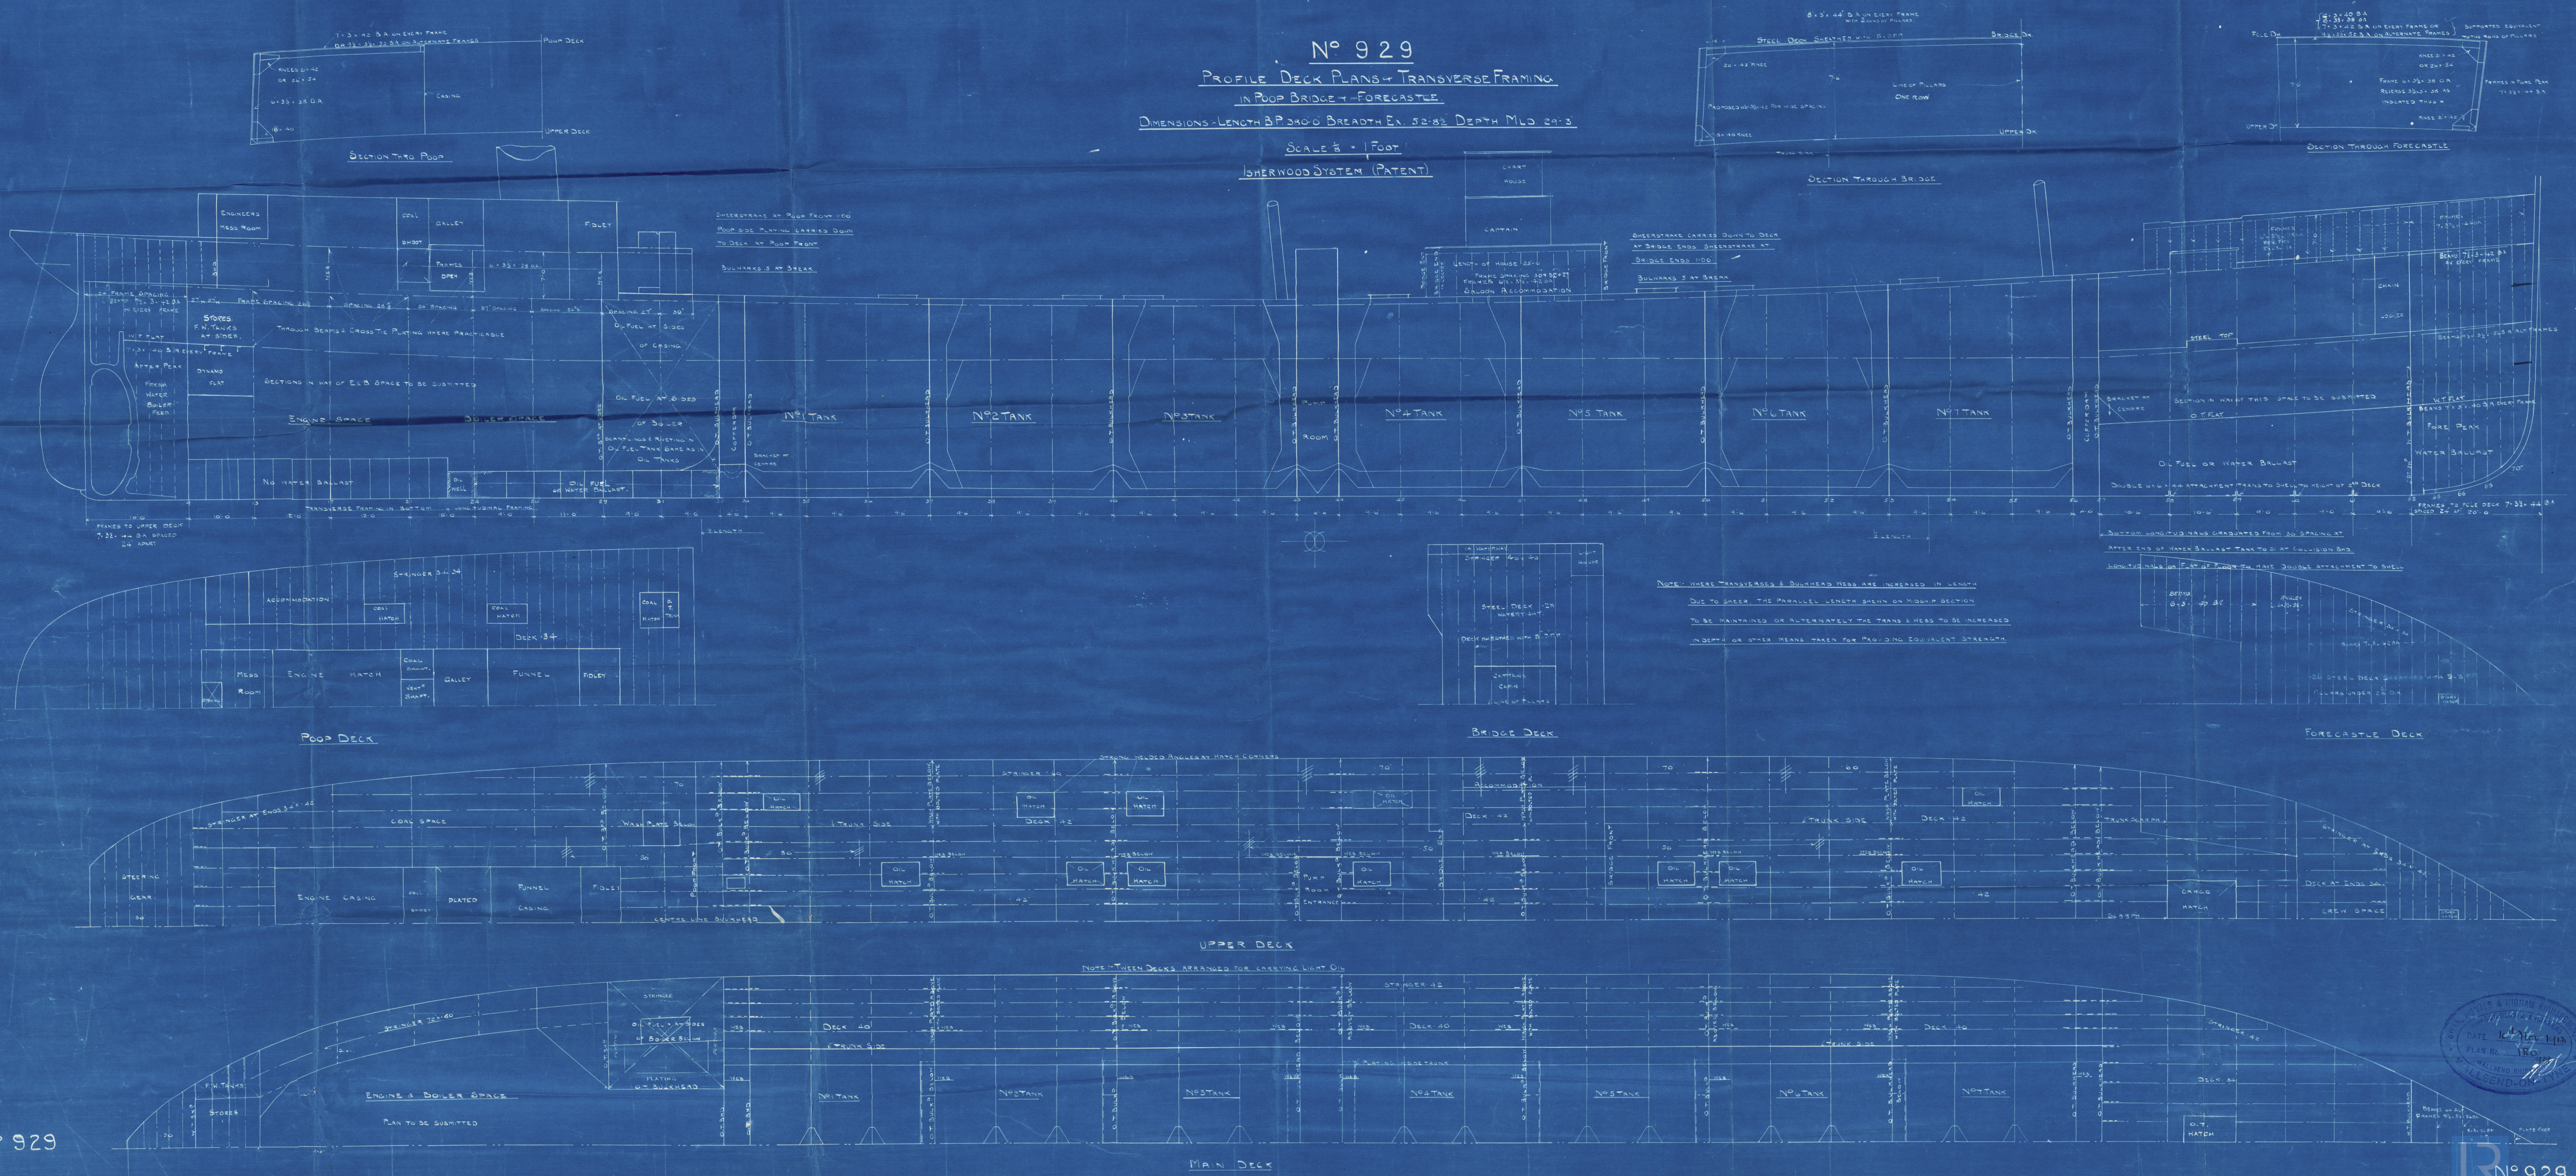

N° 929
 W686-0273

Swan, Hunter Wigham Richardson Ltd

S.S. 929


Profile and Deck Plan

As built.

S.S. "EBURNA"

NEWCASTLE-ON-TYNE

Report 4065145

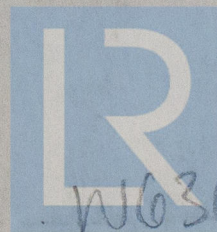

© 2020

Lloyd's Register
Foundation

W036

0273