

A. S. ANNIE M. MILLER

# MIDSHIP SECTION.

S.S. No 355.

SCALE 1/2" = ONE FOOT.

EQUIPMENT			
2 BOWER ANCHORS	14 1/2 CWTs	Stockless	
1 " "	12 1/4 " "	" "	
1 STREAM	4 1/2 " "	Ex Stock	
195 FATHOMS	1 1/2 " "	STUD CHAIN CABLE	
60 " "	3 " "	STEEL WIRE STREAM	
75 " "	2 3/4 " "	" "	Ton Line
1 AT 90 " "	2 1/4 " "	" "	HAWSER


LENGTH B.P.	160.2
BREADTH MLO	30'-10 1/2"
BREADTH E.M.	31'-0"
DEPTH MLO TO UPPER DECK	14'-0"
DEPTH MLO TO QUARTER DECK	17'-6"
TO CLASS	100 A.1. LLOYDS

NUMERALS			
L x B + D	160.2 x (30.87 + 14.0)	=	7188
L x D	160.2 x 14	=	2242
D		=	14
L/D	160.2 ÷ 14	=	11.44 To Upper D's
L/D	160.2 ÷ 17.5	=	9.15 To Quarter D's
d		=	11.54 To Upper D's
d		=	15.04 To Quarter D's

## EQUIPMENT NUMERAL

$L \times (B+D)$	=	7188
FOR'CLE $27 \times 7.5 \times 7.5$	=	152
DECK HOUSES $46 \times 7.5 \times 7.5$	=	258
QUARTER D's $55 \times 3.5$	=	192
		7790

REQUIREMENTS OF OWNERS OVER LLOYDS			
MAIN FRs	5 x 2 1/2 x 30 B.A.	10% THICKER	= .33
TANK FRs	5 x 3 x 28 O.A.	" "	= .31
REV. FRs	5 x 3 x 28 O.A.	" "	= .31
FLOORS	.28	" "	= .31
INTERCOSTALS	.28	" "	= .31
TANK TOP PLATING	.24 THICKER		

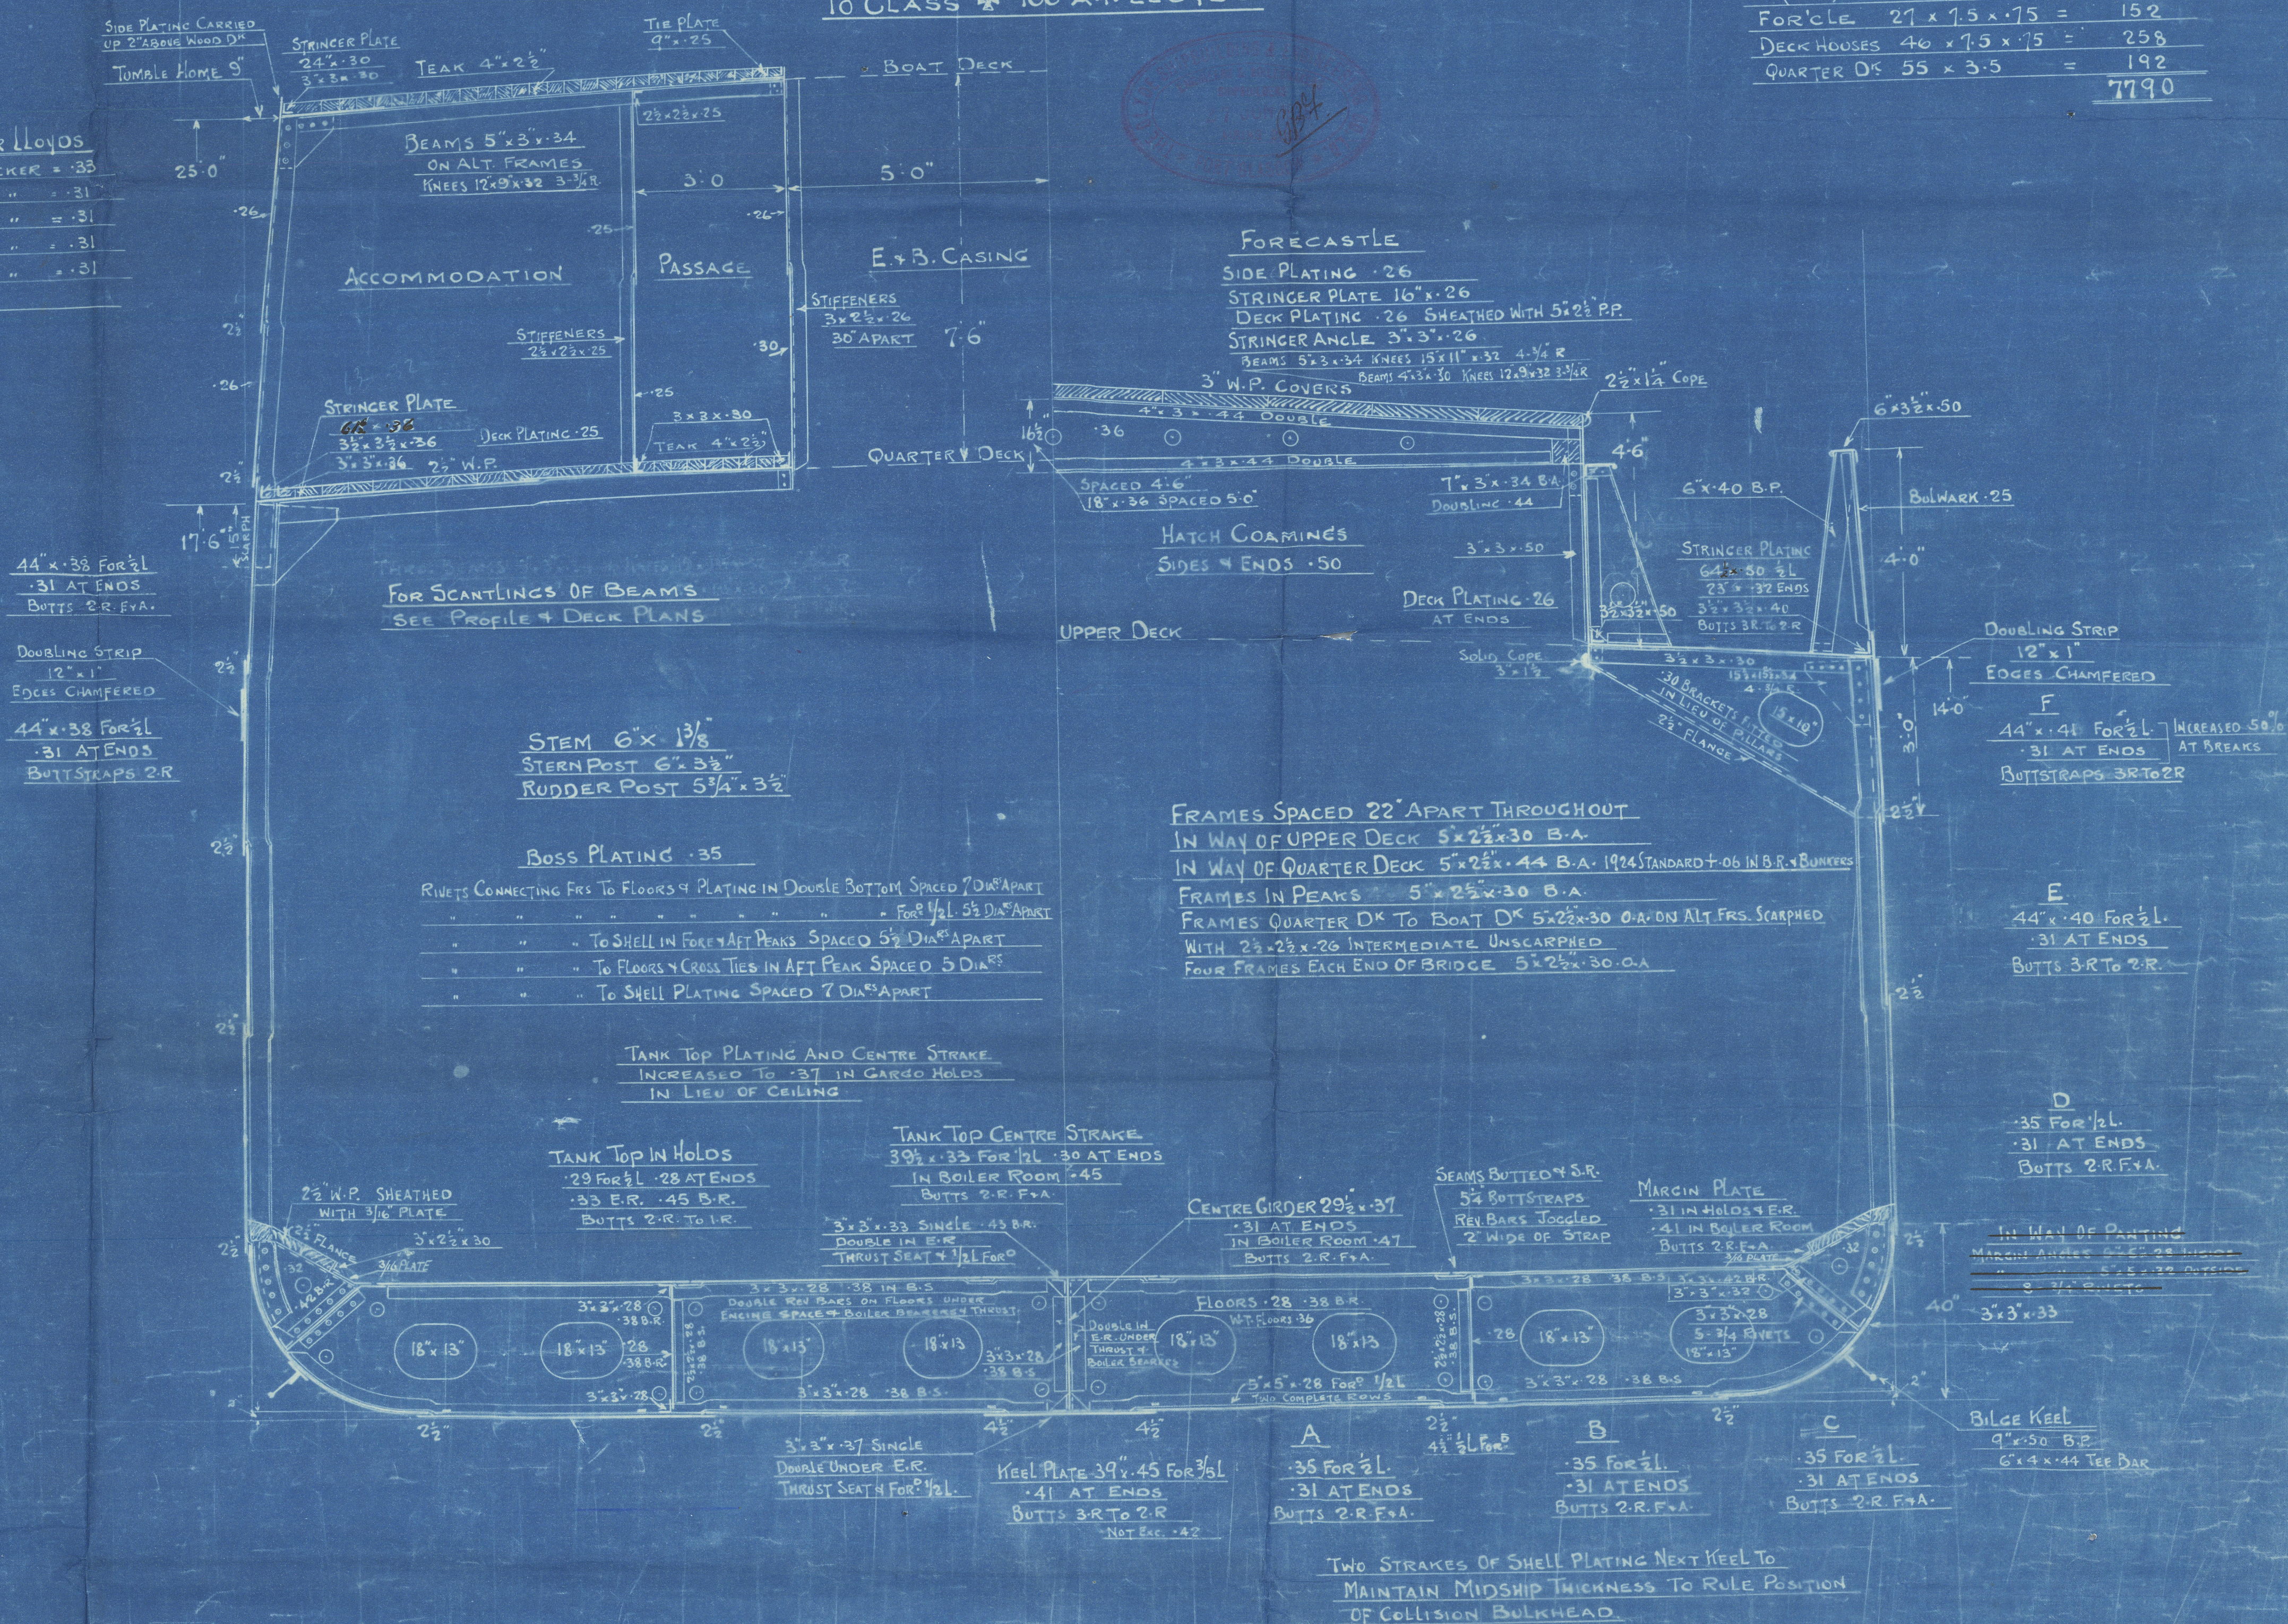



The Clyde S.B. & C. Co. L<sup>td</sup>

S. S. "ANNIE M. MILLER."

N<sup>o</sup> 355.

Midship Section.

as Built.

Gen. Report N<sup>o</sup> 18942

