

MIDSHIP SECTION

S. S. "MICHAEL."

300'-0" x 45'-0" x 28'-0"


SCALE 1/2" = 1 FOOT

Equipment		
Numerals		21000
Boiler	33	
Bridge	75	
2'le	87	
		870
		22770

Equipment including
Lloyd's Rules and
Supplied by Owners


Numerals	
Breadth	45
Depth	28
Length	300
	21900

Proportions 10.71

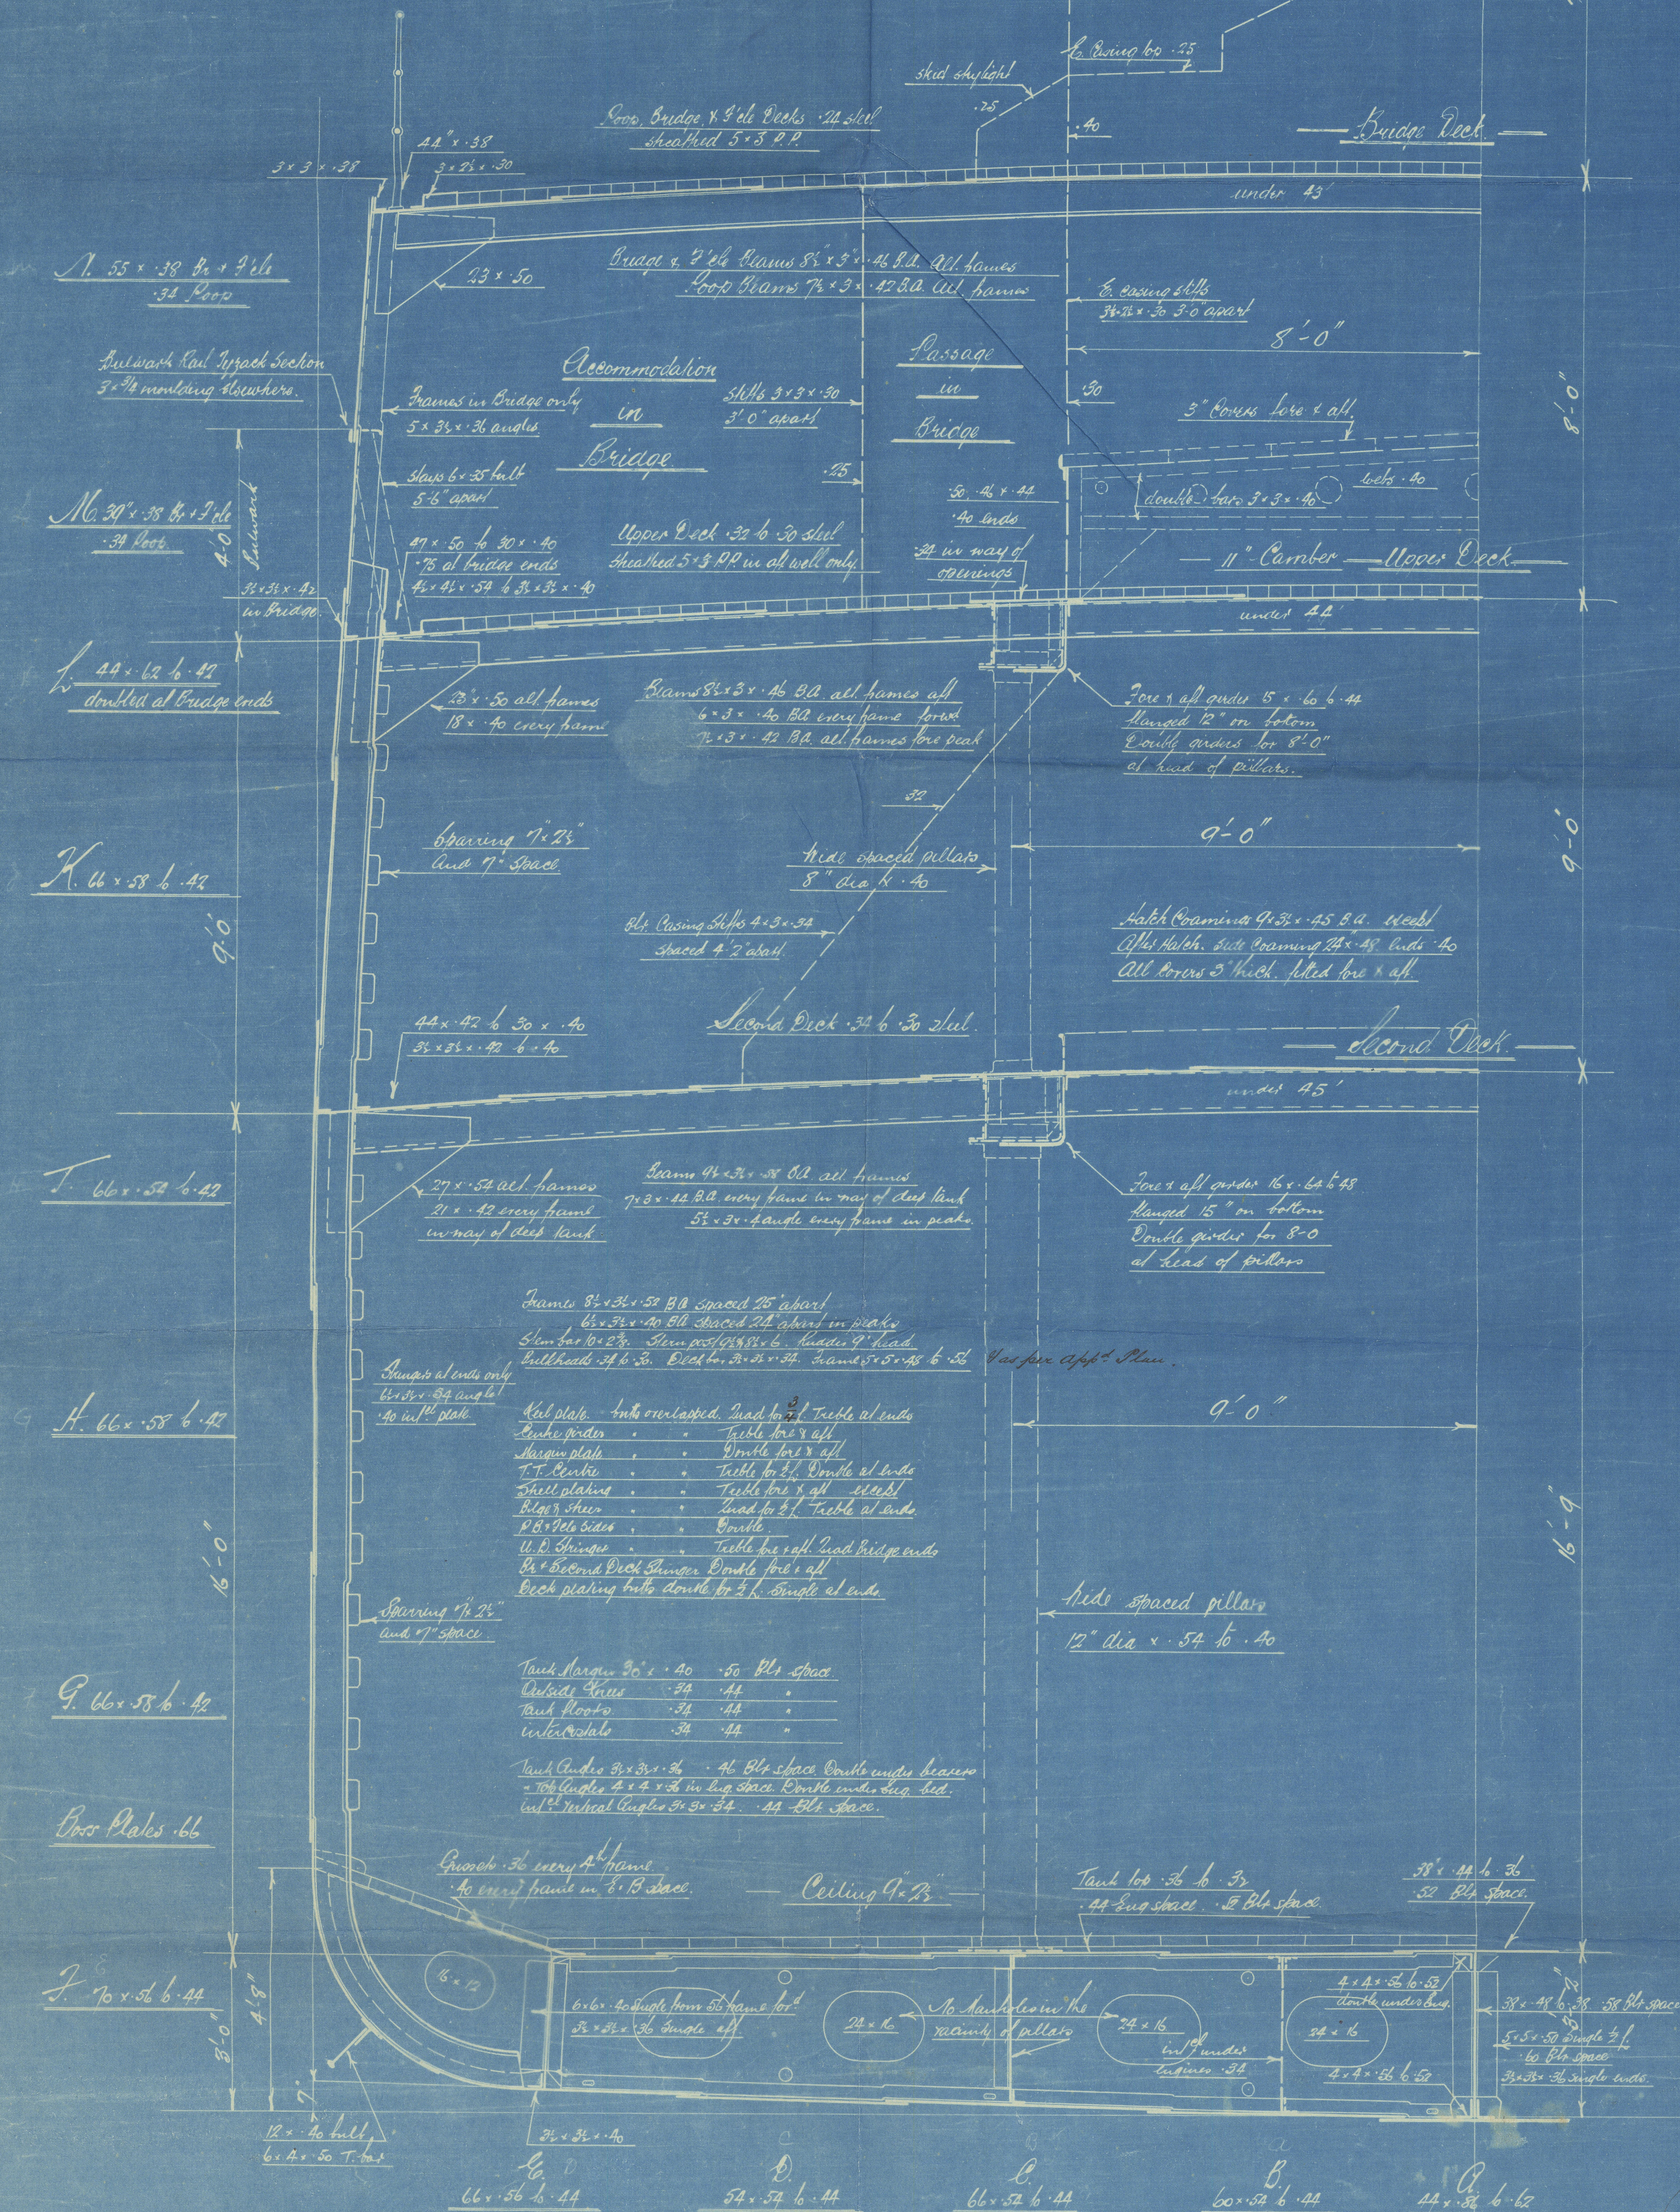

Nº 586.

Midship thickness on flat of bottom carried forward to Coll. Bulkhead
extra plates laid and frame bottom doubled forward of 7/8"

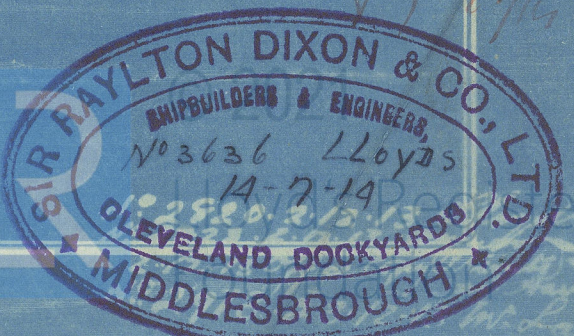

W638-01223

Six Raylton Dixon & Co.

Midship Section

No. 586

S/S 'Michael'


As Built-

S.S. Michael

MIDDLESBRO' 8582.



REVIEW

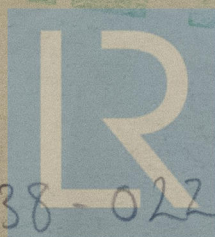

© 2021

W638-0223

Lloyd's Register
Foundation