


— SCREW STEAMER N^o 187. —

— SCALE $\frac{1}{2}$ = 1 FOOT. —



— BARTRAM & SONS —
— SHIPBUILDERS —
— SOUTH DOCK —
— SUNDERLAND. —

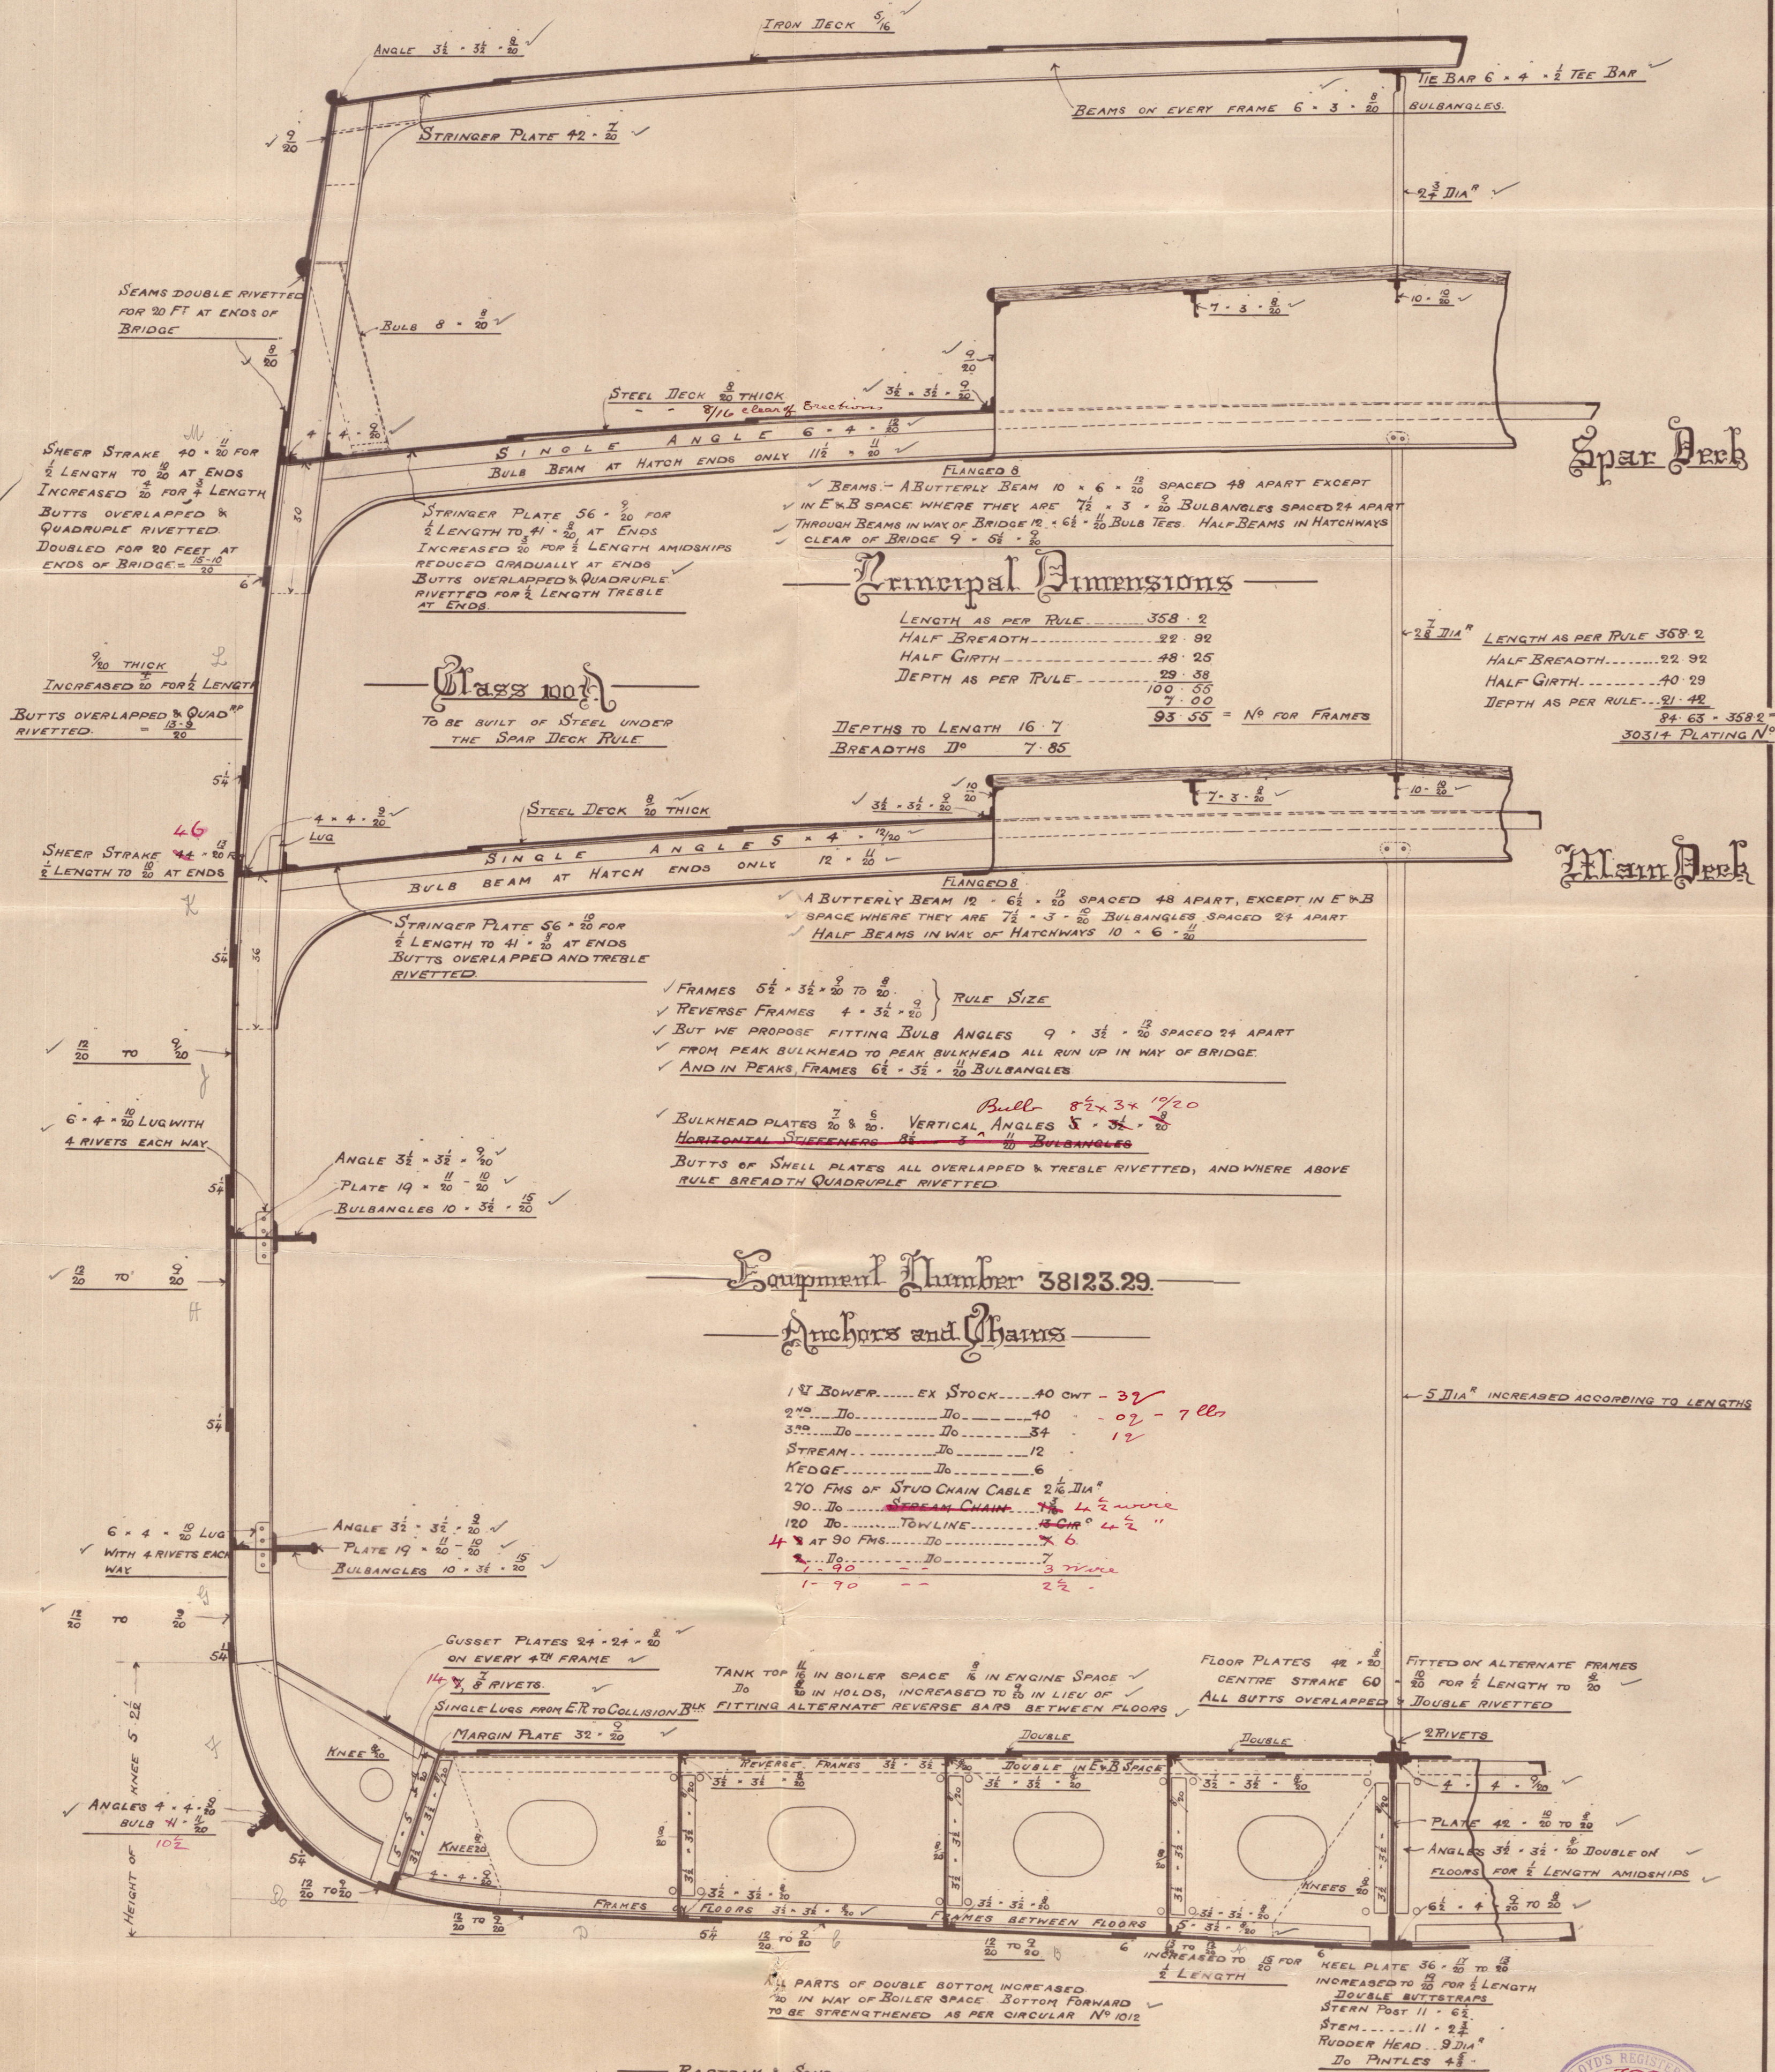



Barbarn & Son

No 187

cc
SS Benarby

Midship Section
as built

Sunderland No. 21030

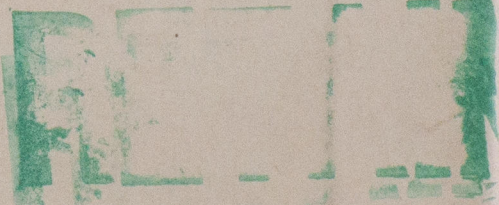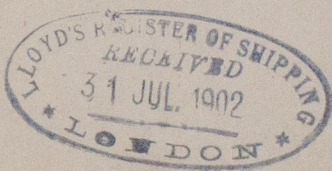

© 2020

Lloyd's Register
Foundation

W654-0128