


3/8" KAMLOOPS & 3/8" LETHBRIDGE. TWEEN DECK. PACKAGE FREIGHTER PROFILE & DECK PLANS.

DIMENSIONS. LENGTH B.P. 250'-0". BREADTH M² 42'-9". DEPTH M² 26'-6".

ISHERWOOD SYSTEM.

SCALE 1" = 1 FOOT.

LLOYDS + WITH FREEBOARD
TO CLASS 100. A.I. FOR SERVICE ON THE GREAT LAKES
AND RIVER ST. LAWRENCE.

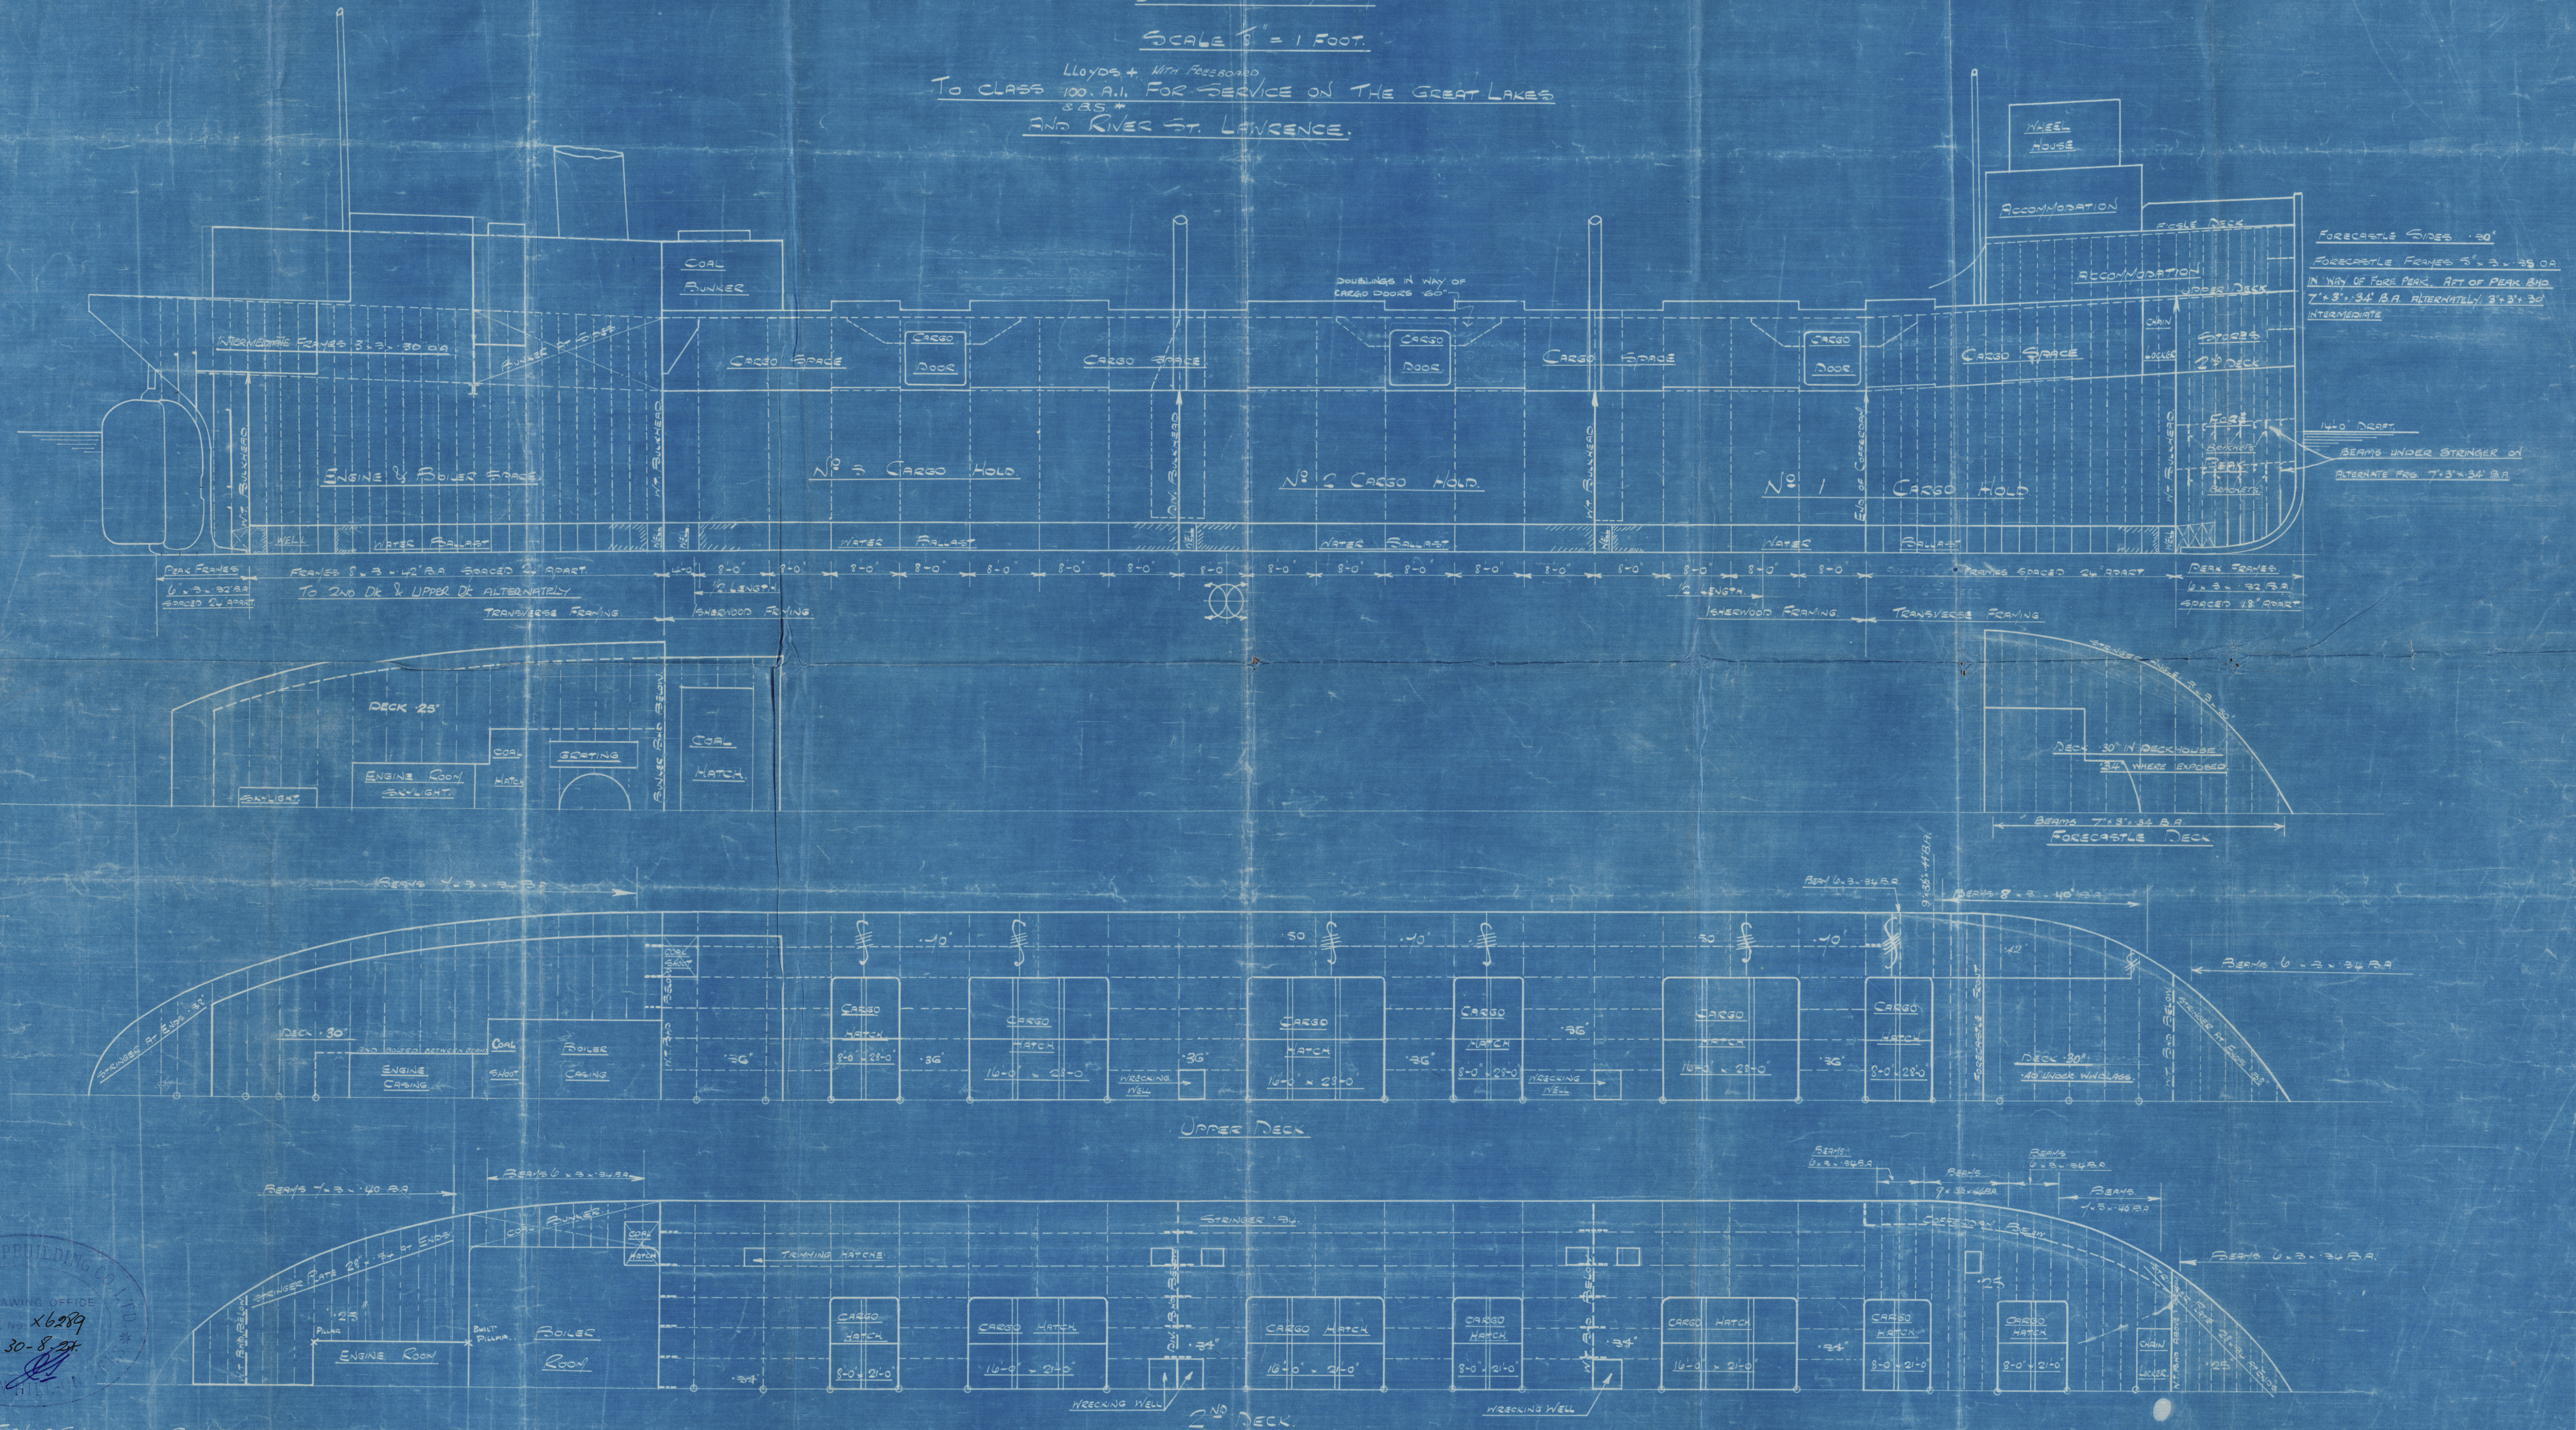

THE FURNESS SHIPBUILDING CO. LTD.
SHIP DRAWING OFFICE
ISSUE NO. X6289
DATE 30-8-27
HARTON HILL

THE FURNESS SHIPBUILDING CO. LTD.
HARTON - HULL ON - TEES.
PLAN NO 1886. I N 8 1650. 12.12.23

S.S. Kamloops


Turner Ship & Coy. No. 68

Profile & Decks
as Built

S.S. Kamloops
MDB. RPT. No. 11981.

(See label)

RECEIVED

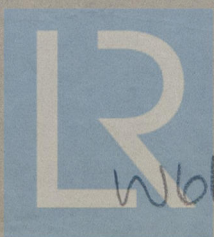

© 2020

Lloyd's Register
Foundation

W666-0105