
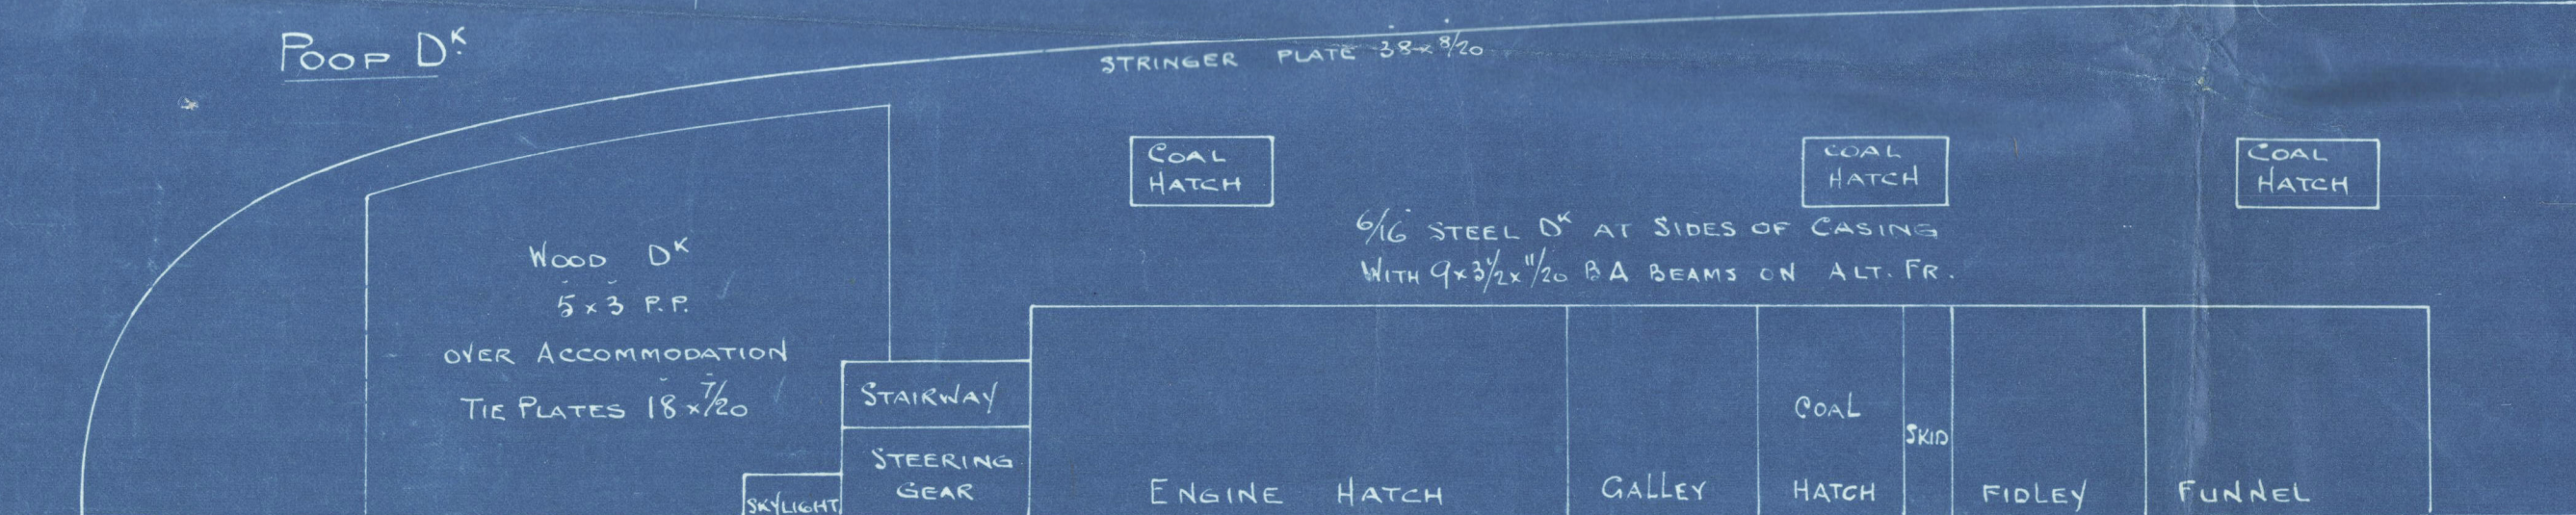






PROFILE & DECK PLANS S.S. NO 833

LLOYDS' DIMENSIONS 388.08 x 50.29 x 33.00

SCALE 1/8" ONE FOOT

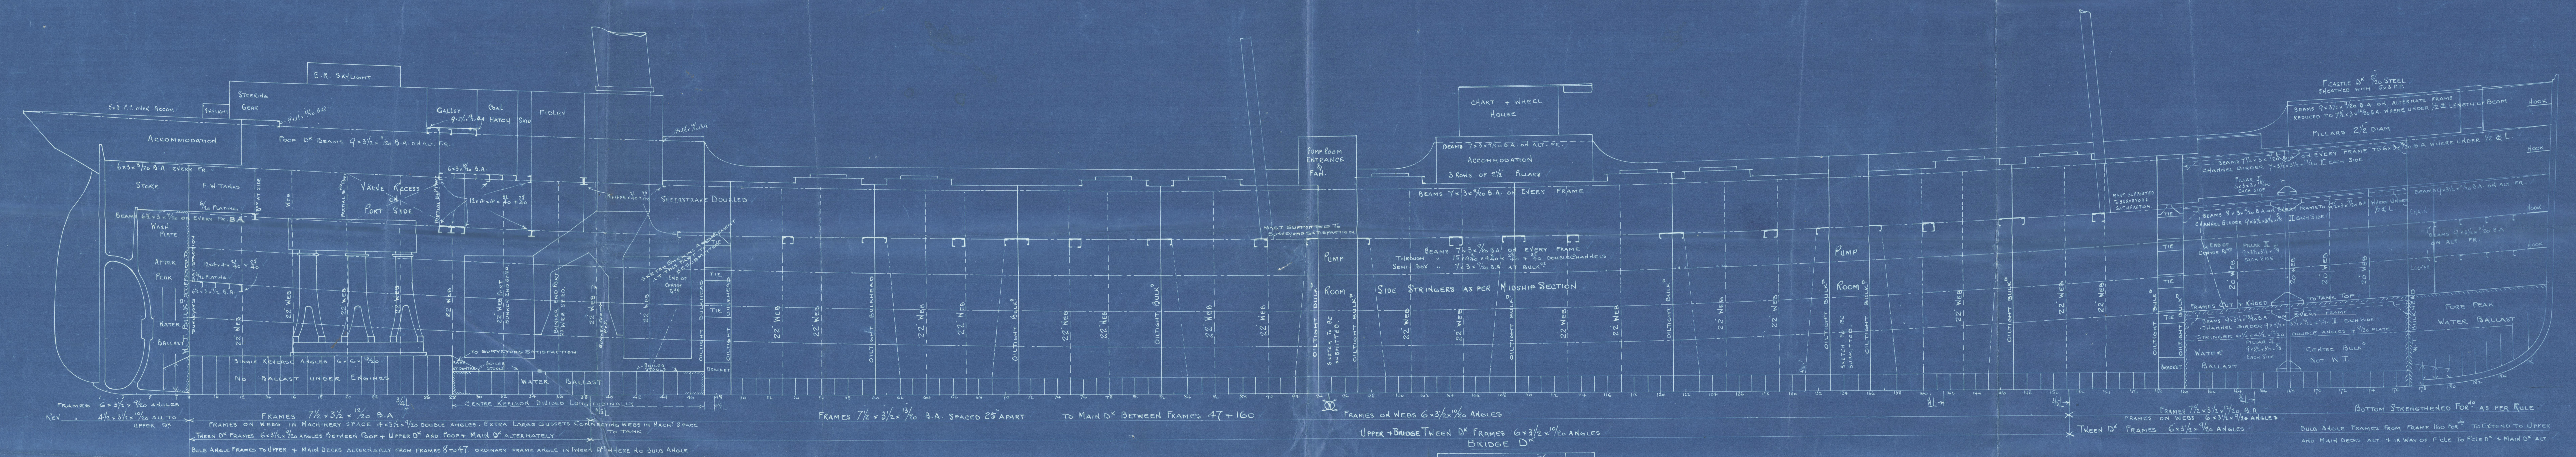


NOTE
FLOORS UNDER ENGINES 1/20 STEEL. UNDER BOILERS 1/20 IRON
TANK TOP IN ENGINE SPACE 1/20 STEEL. UNDER BOILERS RILE 1 1/2 x 3/4 x 1/20
MARGIN PLATE 1/20. 1/20 IN BOILER SPACE. TANK MARGIN ANGLE 4 x 4 x 1/20
TANK CONNECTION BARS 3/4 x 3/4 x 1/20. CENTRE GIRDER 1/20 STEEL 1/20 UNDER BOILERS 4 x 4 DEEP
SIDE GIRDER 1/20 UNDER ENGINES 1/20 STEEL UNDER BOILERS
CENTRE GIRDER TOP ANGLE 4 x 4 x 1/20. BOTTOM ANGLE 4 1/4 x 4 1/4 x 1/20
AND OTHERWISE AS PER RULES

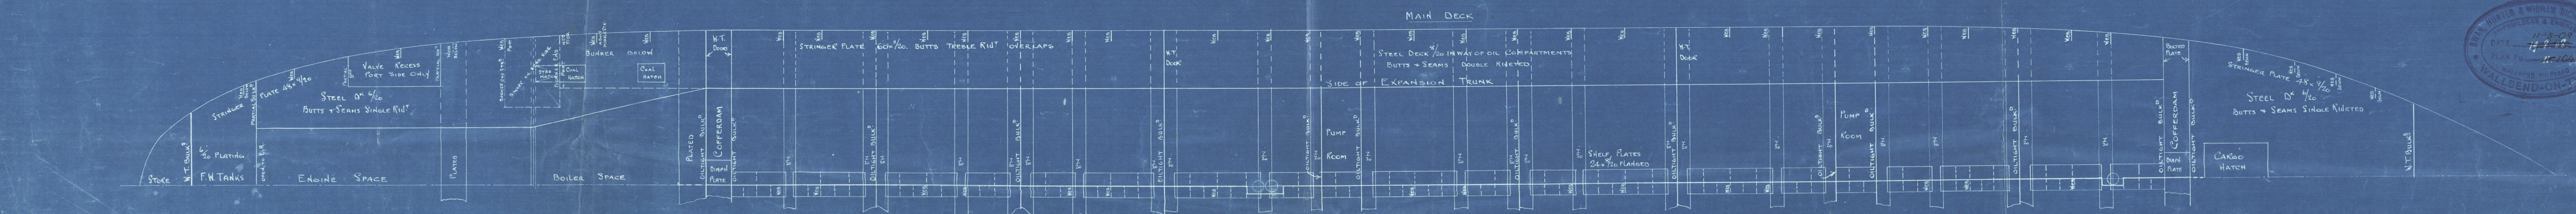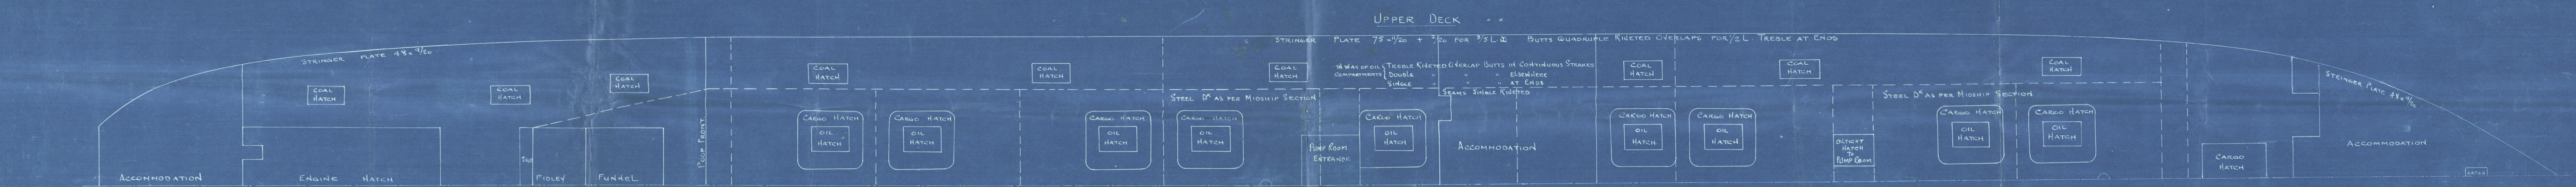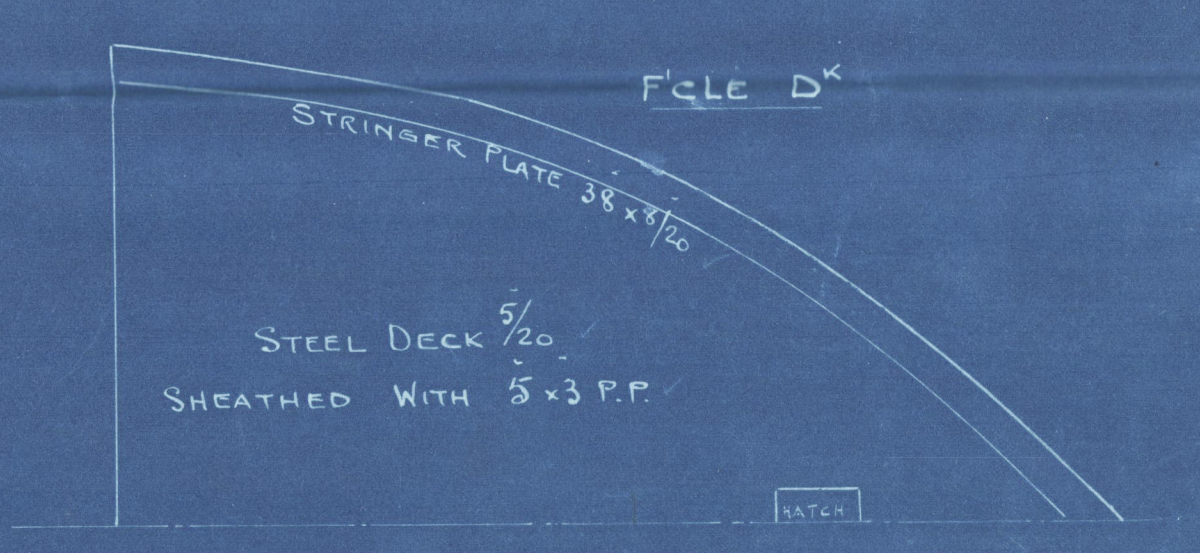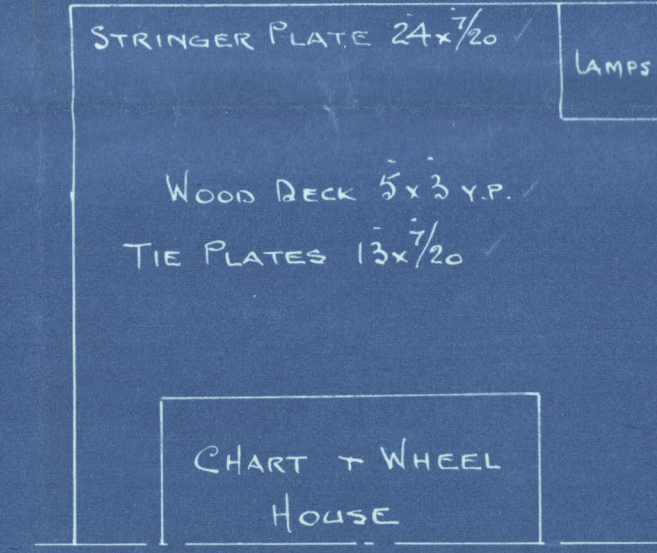

SWAN, HUNTER, & WIGHAM RICHARDSON LTD.

SHIPBUILDERS & ENGINEERS. WALLSEND SHIPYARD

WALLSEND ON TYNE

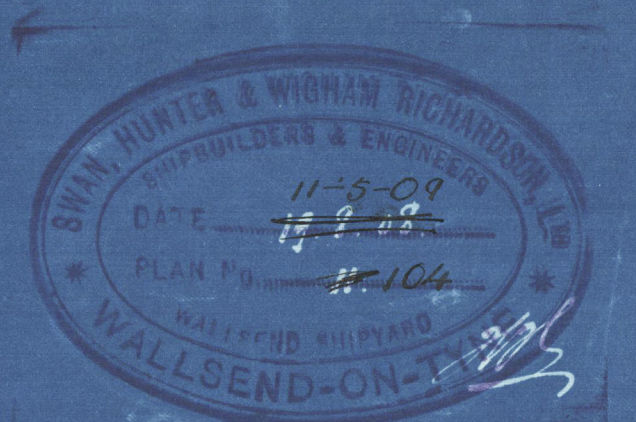

Corrected Profile
as Built

SHMR. 833

San Antonio

S. I. SAN ANTONIO

Newcastle Report

N^o 56733

W680-0040



© 2020

Lloyd's Register
Foundation