



Nº 74.

PROFILE & DECK PLAN.

DIMENSIONS: LENGTH B.P. 248'-0" BREADTH MLD 38'-6" DEPTH MLD 17'-6" UPPER DK. 21'-3" R.Q. DK.

SCALE 1/8" = 1 FOOT.

MILLAR SYSTEM PTD. TO CLASS 100 AT LLOYDS.

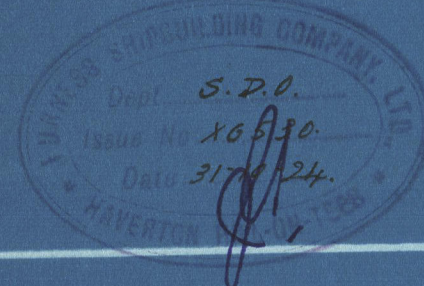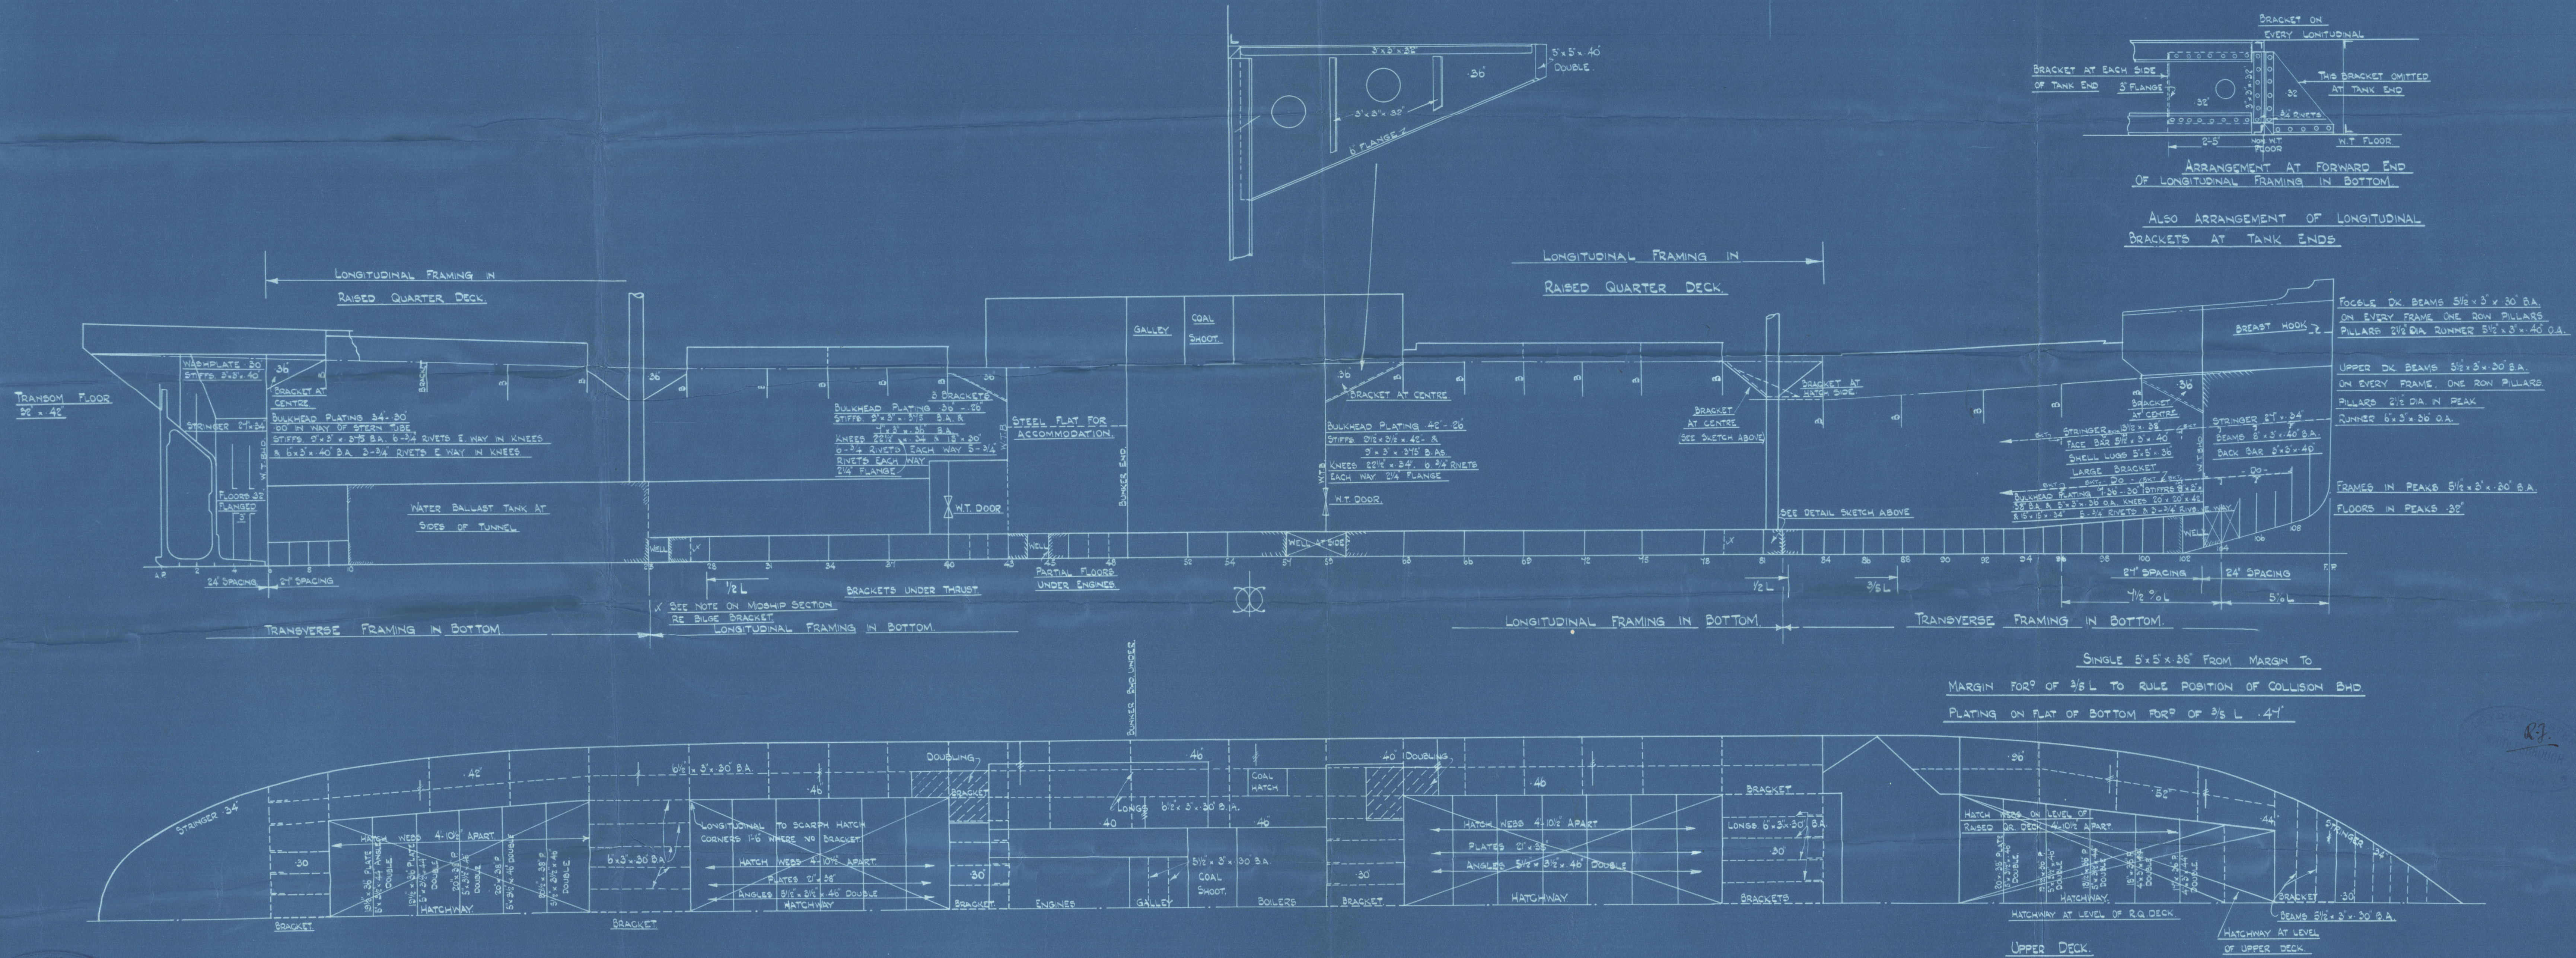


S.S. "John Harrison"

Tumen Shik & Co. 110, 74

Profile & Decks
(as Built)

S.S. John Harrison
MDB. RPT. No. 12128-
(A.E.).

RETAIN

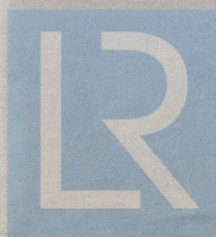

© 2020

Lloyd's Register
Foundation

W687-0161