


# MIDSHIP SECTION, NO 225 T.S.S.

TO CLASS 100 A.1.


AT LLOYD'S.

SCALE  $\frac{1}{2}$ " = 1 FOOT.

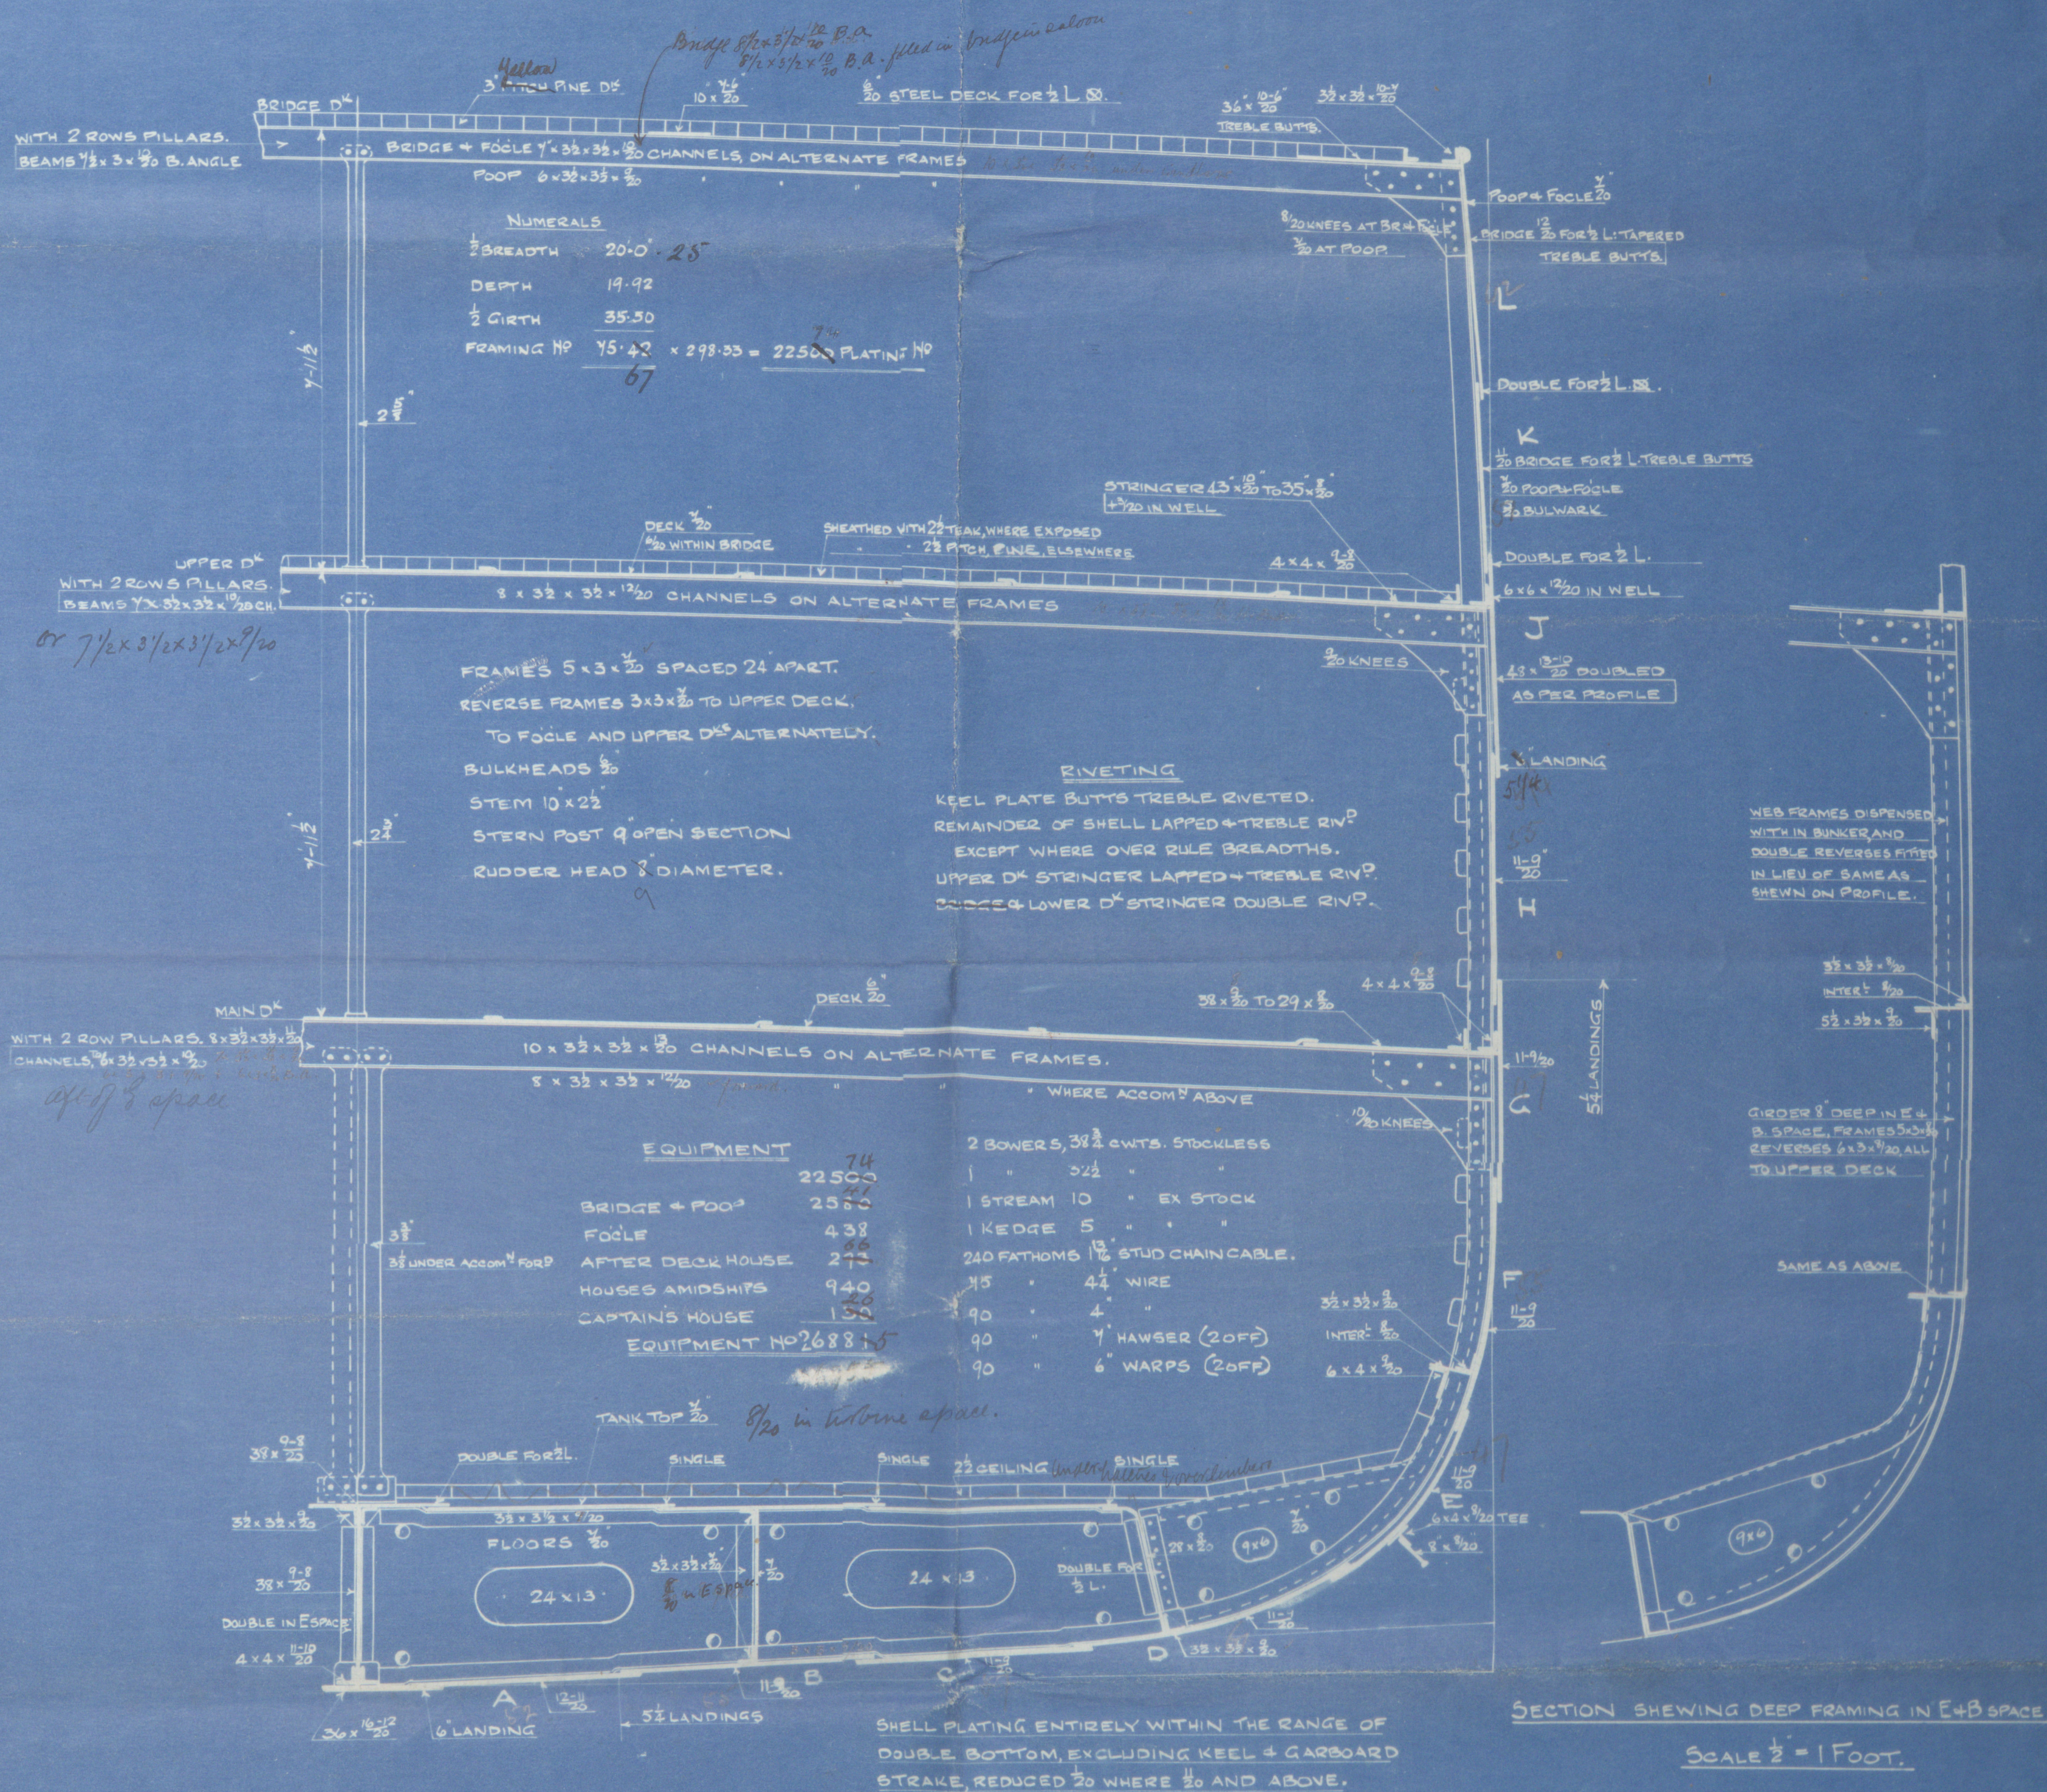

## SECTION THRU BOILER ROOM.

$\frac{1}{2}$ " = 1 FOOT.

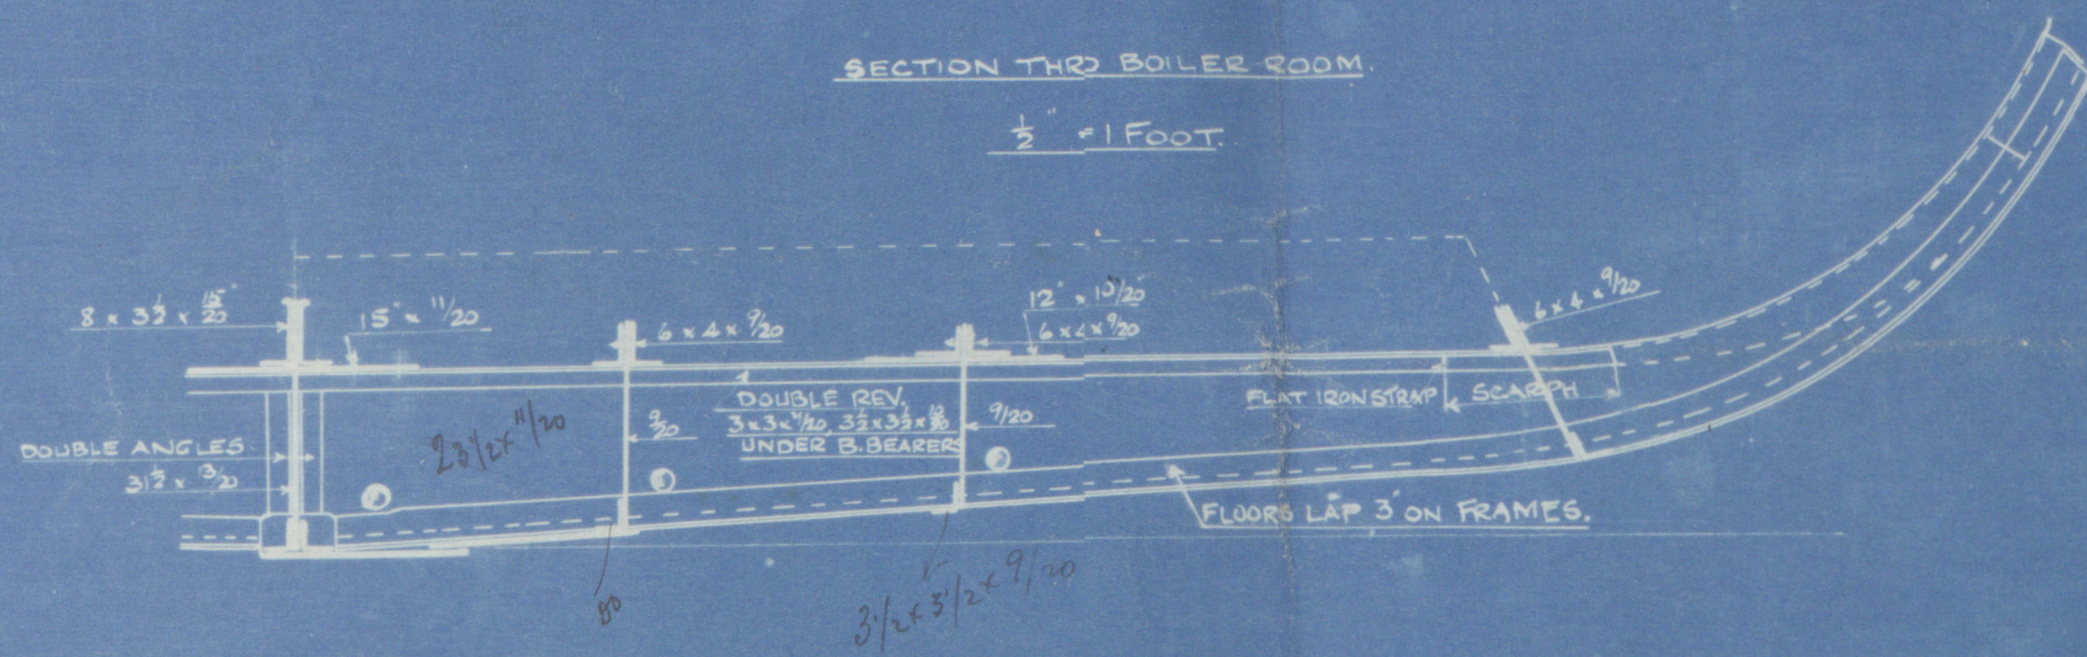



William Clark 9<sup>th</sup>


Carton S.S.

225

Friendship Station

as built


225  
1875  
1876  
1877  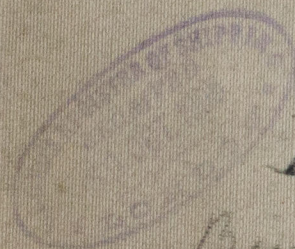
BINGERA

Bingera

Est 6001

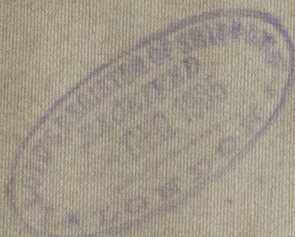

© 2021

Lloyd's Register  
Foundation

W707-0207





© 2021

Lloyd's Register  
Foundation