

# Profile To Class 100 A.I. of Lloyds


Length B.P. 268'0. Breadth Mld 37'8. Depth Mld 19'9

Scale 1/8" = 1 Foot

S.S. "LIGHTFOOT" No 159

Nos 158-9 & 160.

2/11/16

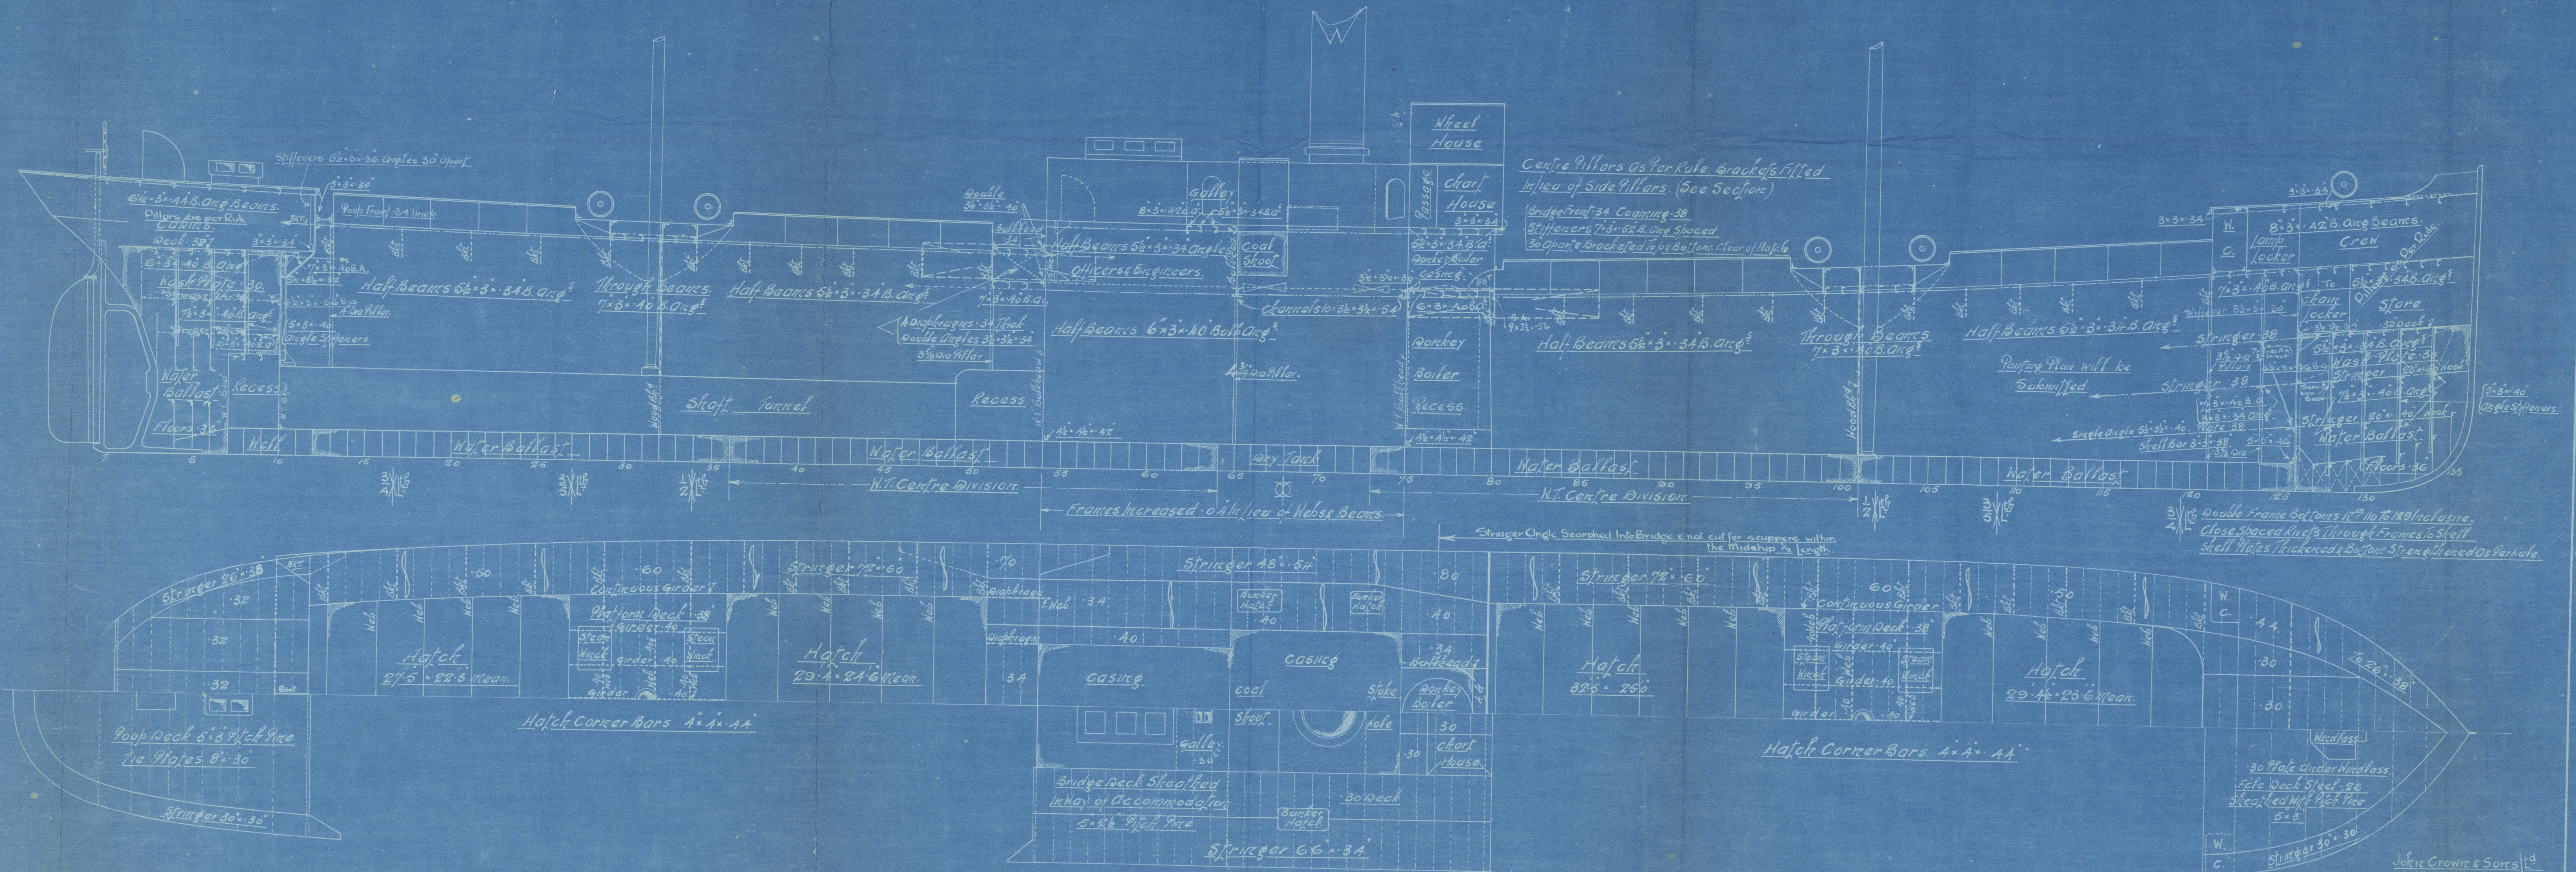

John Crowe & Sons Ltd  
Shipbuilders  
Sunderland  
Jan 11th 1916



RETAIN



© 2020

Lloyd's Register  
Foundation



Profile + Deck plans,  
S.S. "Lightfoot"  
as built

Messrs J. Crown + Sons  
No. 159

SUNDERLAND RPT. NO. 26835



© 2020

Lloyd's Register  
Foundation

W724-0180