


# 1/2 ROYSTON. MIDSHIP SECTION

No. 844

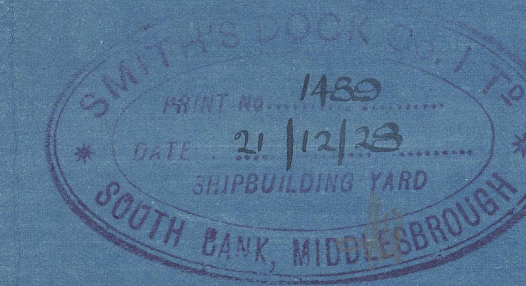

As built.


LENGTH 305'-0" BP BREADTH 45'-3 1/2" MLD DEPTH 23'-6" MLD

SCALE - 1/2" = 1 FOOT

NEW B.S. SECTION ADOPTED EXCEPT WHERE OTHERWISE

MARKED

TO CLASS 100 A.I. AT LLOYDS

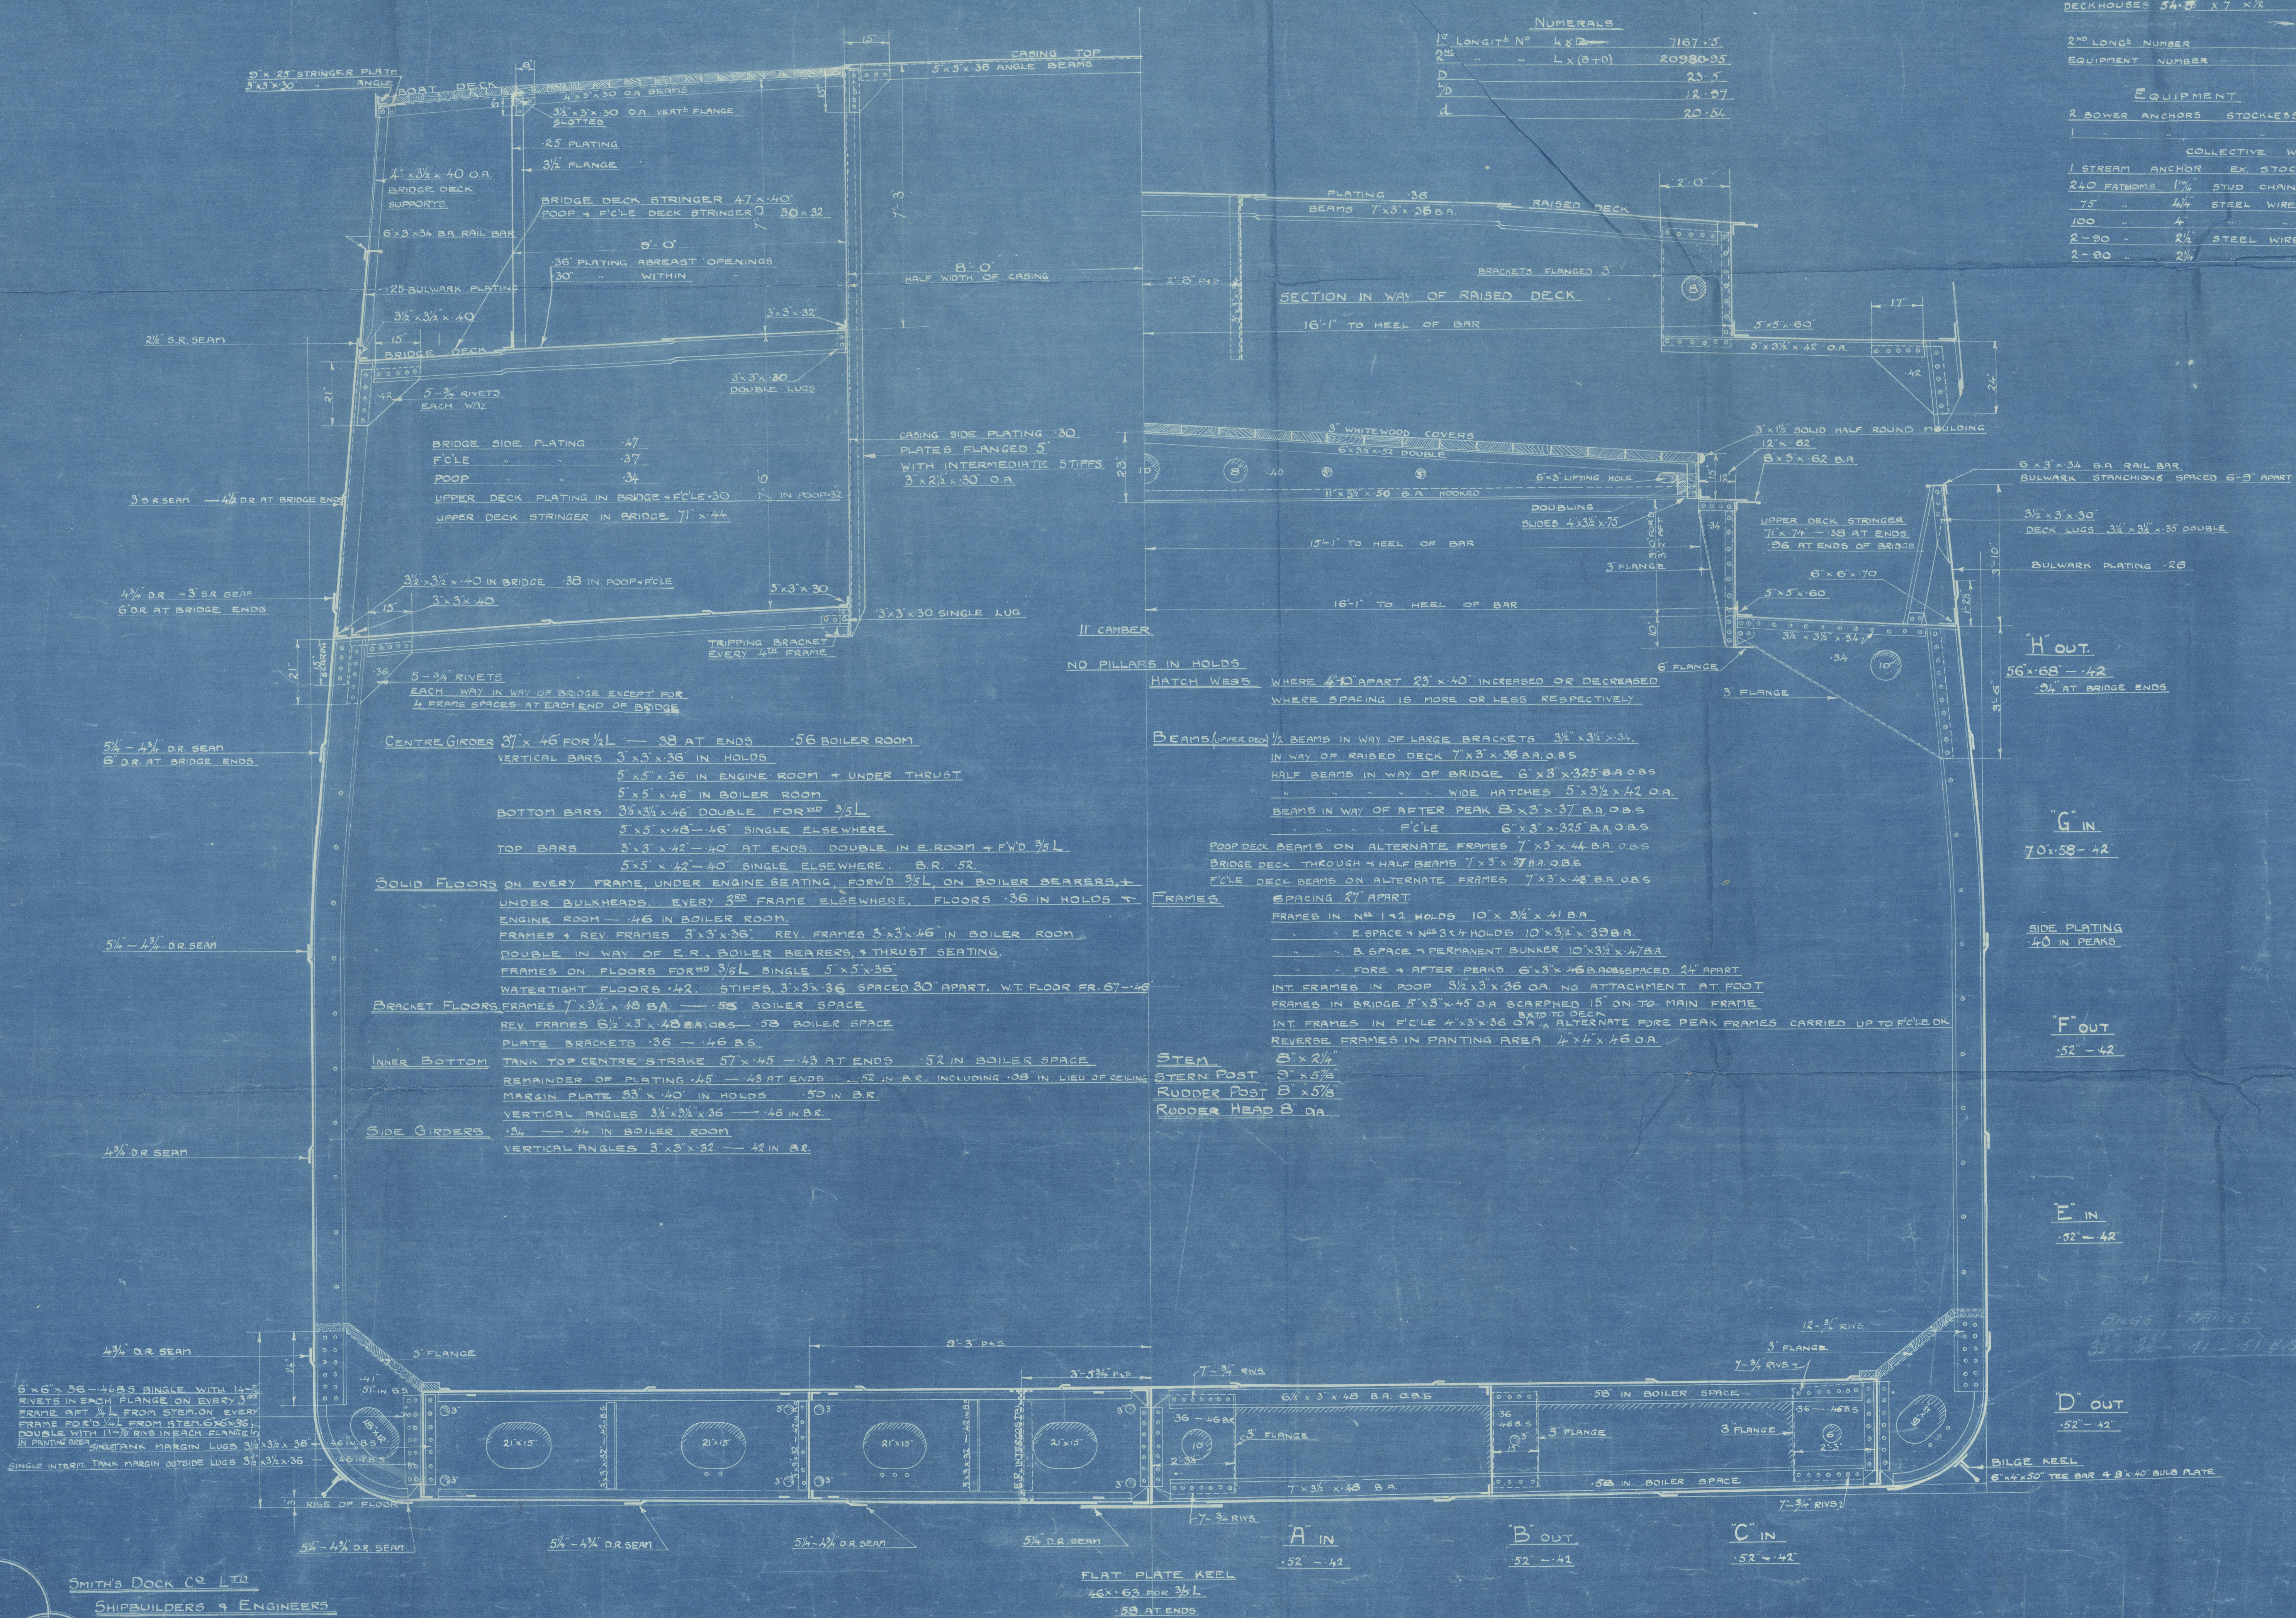

NUMERALS		
1 <sup>st</sup> LONGIT. NO.	482	7167.5
2 <sup>nd</sup> " "	L X (B+0)	20980.95
D		23.5
70		12.07
d		20.54

EQUIPMENT NO.		
POOP	2525 x 7.5 x 3/4	142
BRIDGE	5725 x 7.5 x 3/4	288
FORECASTLE	2775 x 7.5 x 3/4	156
DECKHOUSES	54.8 x 7 x 1/2	190.75
		810.75
2 <sup>nd</sup> LONG NUMBER		20980.95
EQUIPMENT NUMBER		71741.70

EQUIPMENT		
2 BOWER ANCHORS	STOCKLESS	42 CWT. EACH
1 " "		35 1/2 " "
COLLECTIVE WEIGHT 118 1/2 " "		
1 STREAM ANCHOR	EX. STOCK	11 " "
240 FATHOMS	1 1/2" STOD CHAIN CABLE	
75 " "	4 1/2" STEEL WIRE, STREAM	
100 " "	4 " " TOWLINE	
2-80 " "	2 1/2" STEEL WIRE, HAWSER	
2-80 " "	2 1/2" " " WARP	

H OUT.  
56' x 68' - 42  
3/4" AT BRIDGE ENDS

G IN  
70' x 58' - 42

SIDE PLATING  
40 IN PEAKS

F OUT  
52' - 42

E IN  
52' - 42

D OUT  
52' - 42

SMITH'S DOCK CO. LTD.  
SHIPBUILDERS & ENGINEERS  
SOUTH BANK - ON - TEES  
ENGLAND

FLAT PLATE KEEL  
46' x 63' FOR 3/16"  
38 AT ENDS



<sup>mess.</sup>  
Smiths. Dock Co. Ltd.

S. S. "Royston"

No 844.

Midship Section

As built.

**S.S. Royston**  
**MDB. RPT. No. 13527**

W76-0217



© 2020

Lloyd's Register  
Foundation