



S.S. N^o 102
 LONGITUDINAL SECTION
 SCALE $\frac{1}{8}" = 1'.$



W. T. B. H. D.
 19 APR 1904
 SHIPBUILDERS
 TOWNHART ON TUES

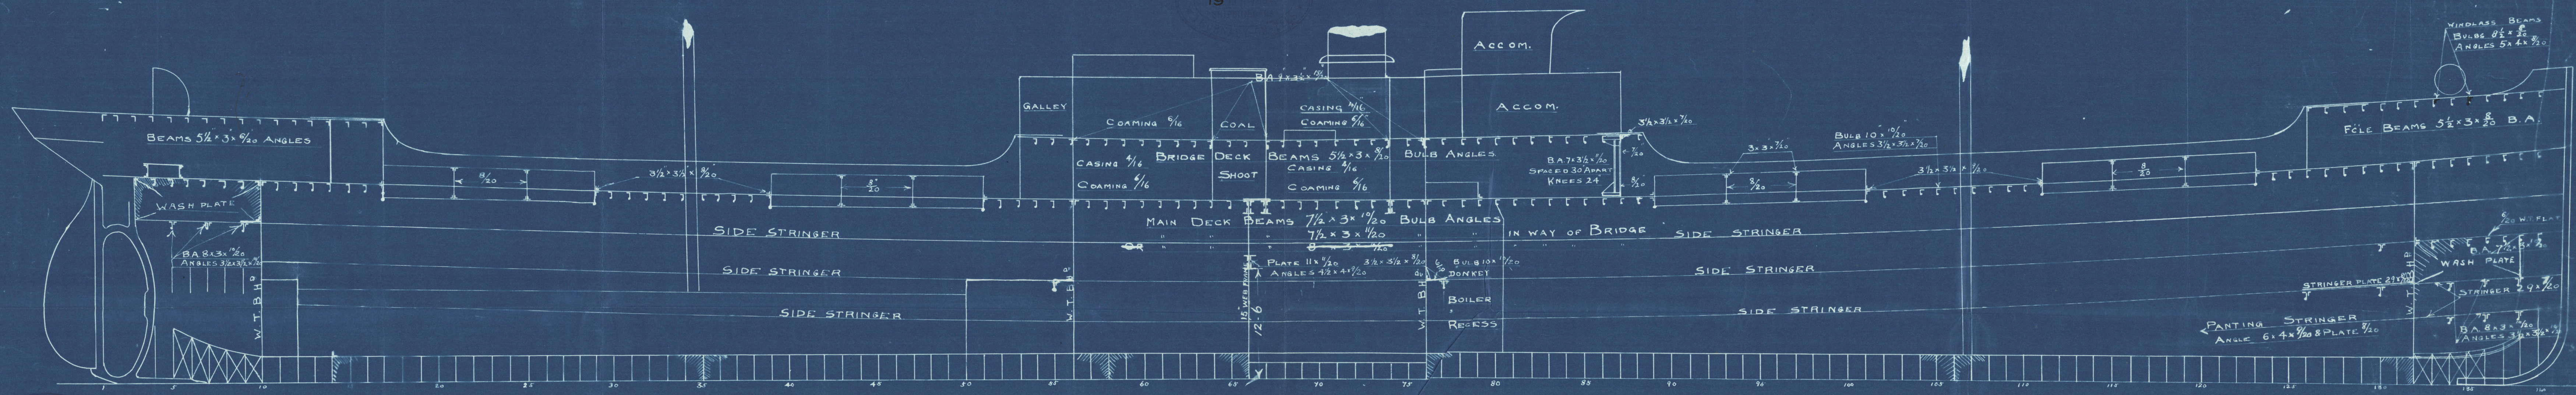

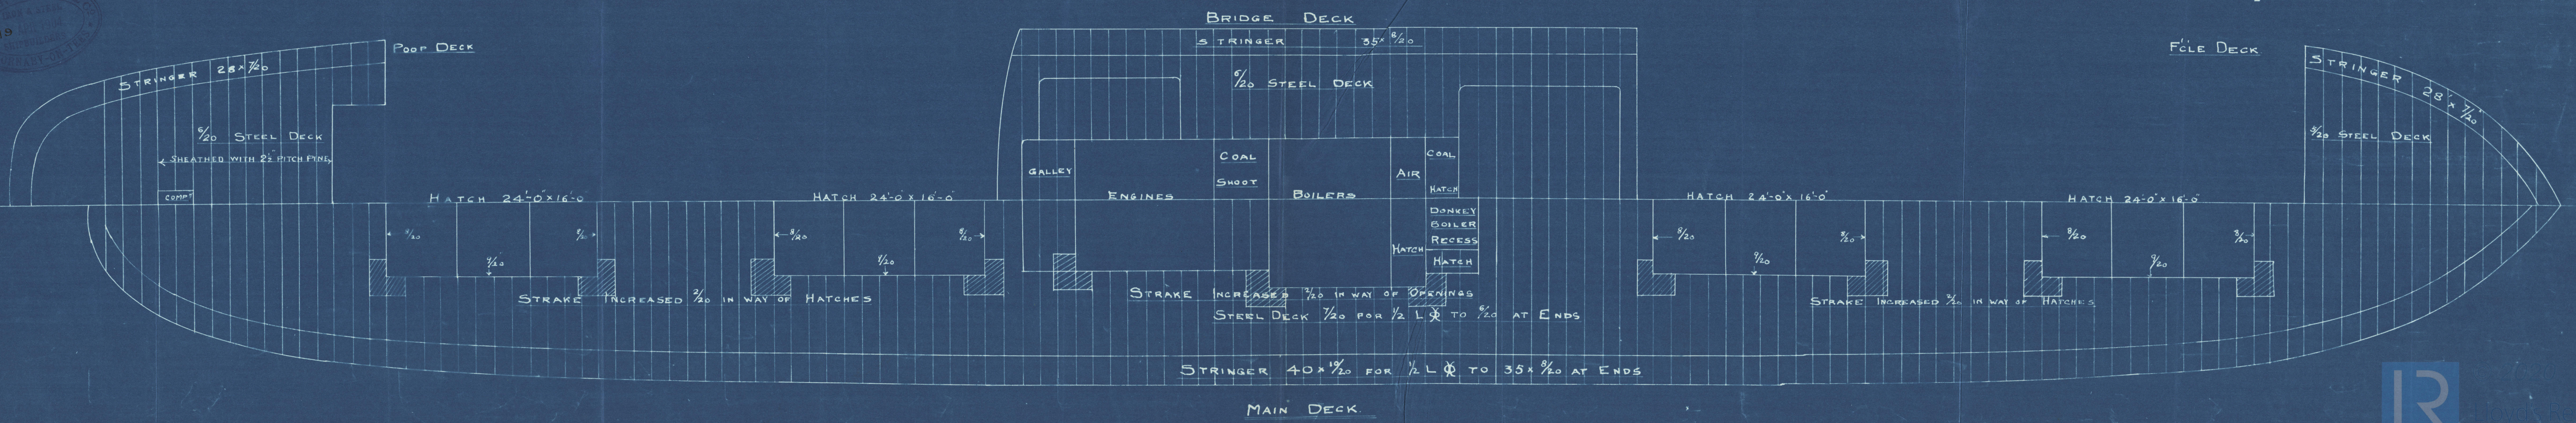

1393

Craig Taylor & Co
No 102
~~Profile & Deck plan~~
~~Midship section~~
as Built
"White Sea"
Mod Report No 3848

RETAIN

W766 -0094



© 2020
Lloyd's Register
Foundation