

6600-18M

13.7.36

PROPOSED MOTOR COASTER FOR J. FISHER & SONS, LTD.

YARD N° 726

MIDSHIP SECTIONS.

SCALE. $\frac{1}{2}$ INCH = ONE FOOT.

TO CLASS 100 A.I. FULL SCANTLING FOR R.Q. DECK.



LENGTH ON W.L. OVER CRUISER STERN 185'-3"
 LENGTH B.P. 180'-0"
 BREADTH MLD. 30'-0"
 DEPTH MLD. TO UPPER DECK 13'-8"
 DEPTH MLD. TO R.Q. DECK 17'-3"
 d. TO UPPER DECK 10'-11"
 d. TO R.Q. DECK (IN HOLD) 14'-6"

30'-1" as measured.

$\frac{L}{D_1}$ TO UPPER DECK = 13.2 $\frac{L}{D_2}$ TO R.Q. DECK = 10.4
 L x D = 2459 L x (B+D) = 7859
 7875 as built.

NOTE:- OWNERS INCREASES SHOWN IN BLUE.


EQUIPMENT.

L * (B+D) = 7859
 R.Q. DECK = 3.58 x 119.7 = 429
 DECKHOUSE = 17 x 7.5 x .5 = 64
 F'CLE. = 22 x 7 x .75 = 115
 2 BOWER ANCHOR STOCKLESS 16 3/4 CWTs.
 1 " " " 14 1/2 CWTs.
 1 STREAM ANCHOR EX. STOCK 4 3/4 CWTs.
 210 FATHOMS 1 1/16 S.L. CHAIN.
 60 FATHOMS 3" F.S. STREAM WIRE.
 75 FATHOMS 2 3/4" F.S.W. TONNAGE LINE.
 90 FATHOMS 6" HEMP HAWSER.
 90 FATHOMS 4" HEMP WARP.

as built
 7875
 429
 139
 115
 8558

SECTION IN WAY OF R.Q. DECK.

SECTION IN WAY OF UPPER DECK.

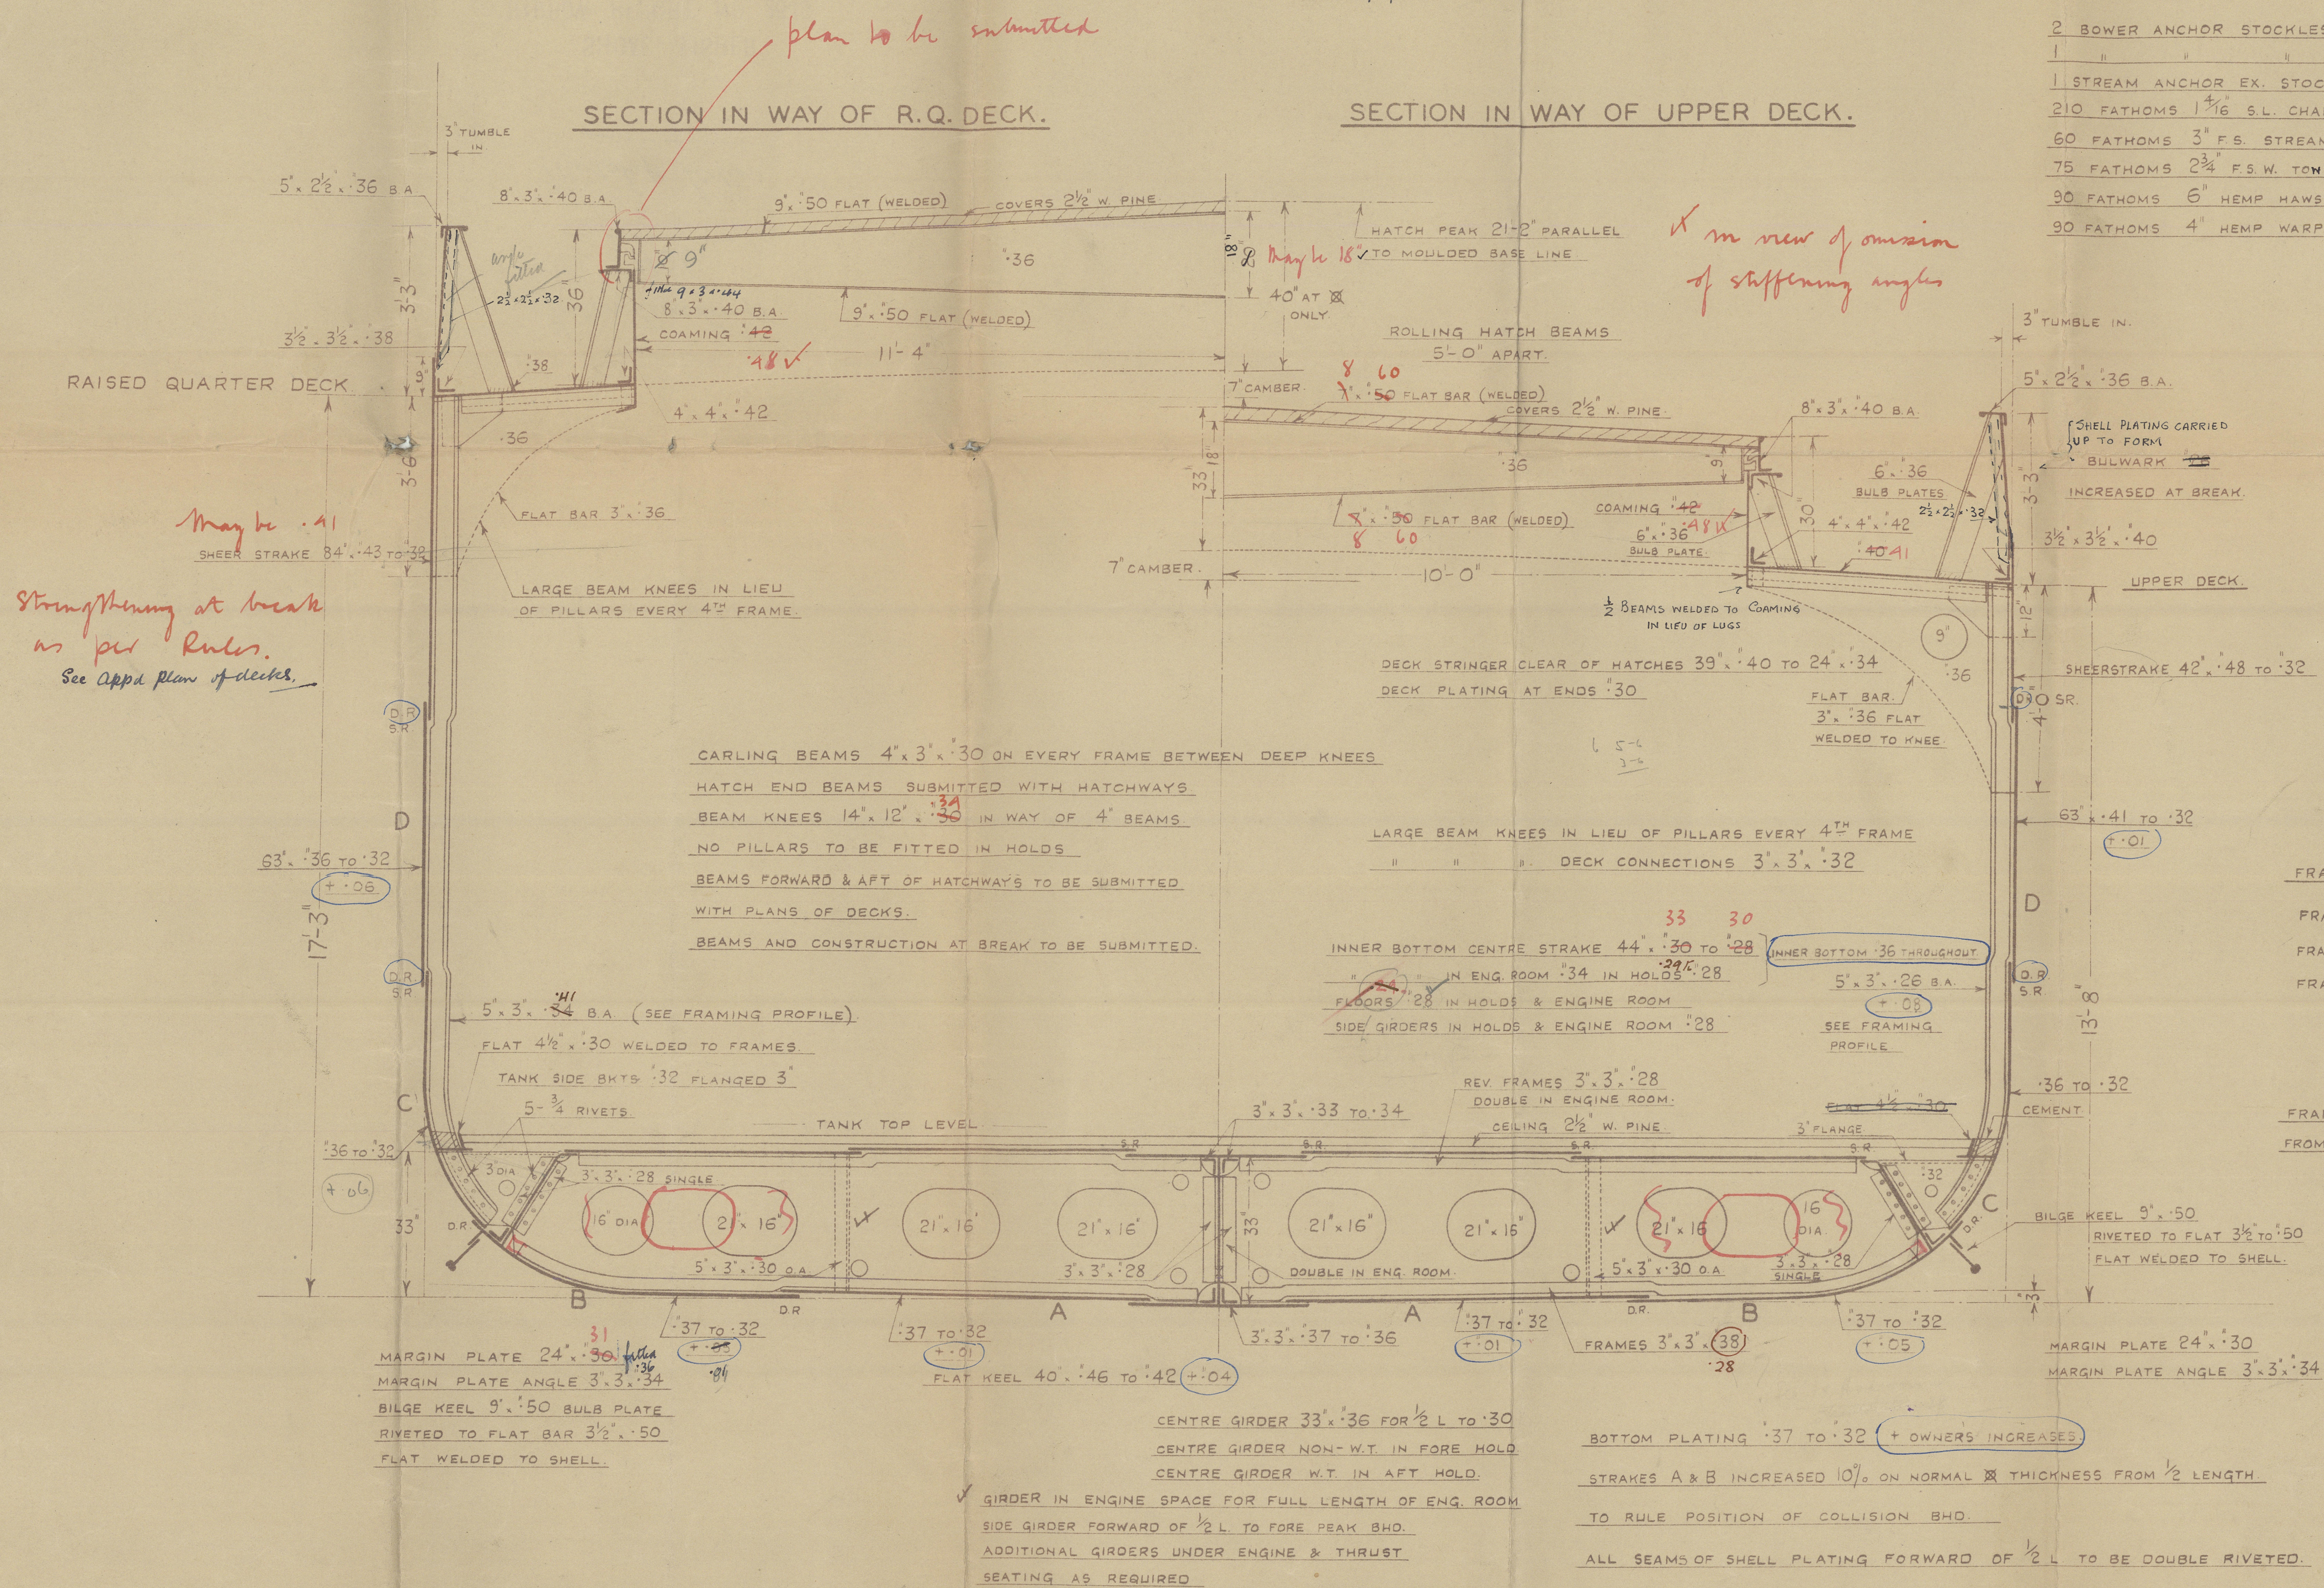

Vickers Armstrongs

426

Midship Section

SHOAL FISHER
BARROW REPORT NO 2645



© 2021

Lloyd's Register
Foundation

0099