


28-12-06  
6.3.07

PROFILE. As built  
L.B.P. 348'-6" B.E.X. 49'-9" D.M. 25'-3"  
SCALE 1/8" = 1 FOOT

As built  
30-10-17

W.T. BULKHEAD OMITTED IN AFTER HOLD, TO MAKE  
VESSEL SUITABLE FOR CARRYING TIMBER CARGOES

Welds and fore & aft  
in hatchways as per rule

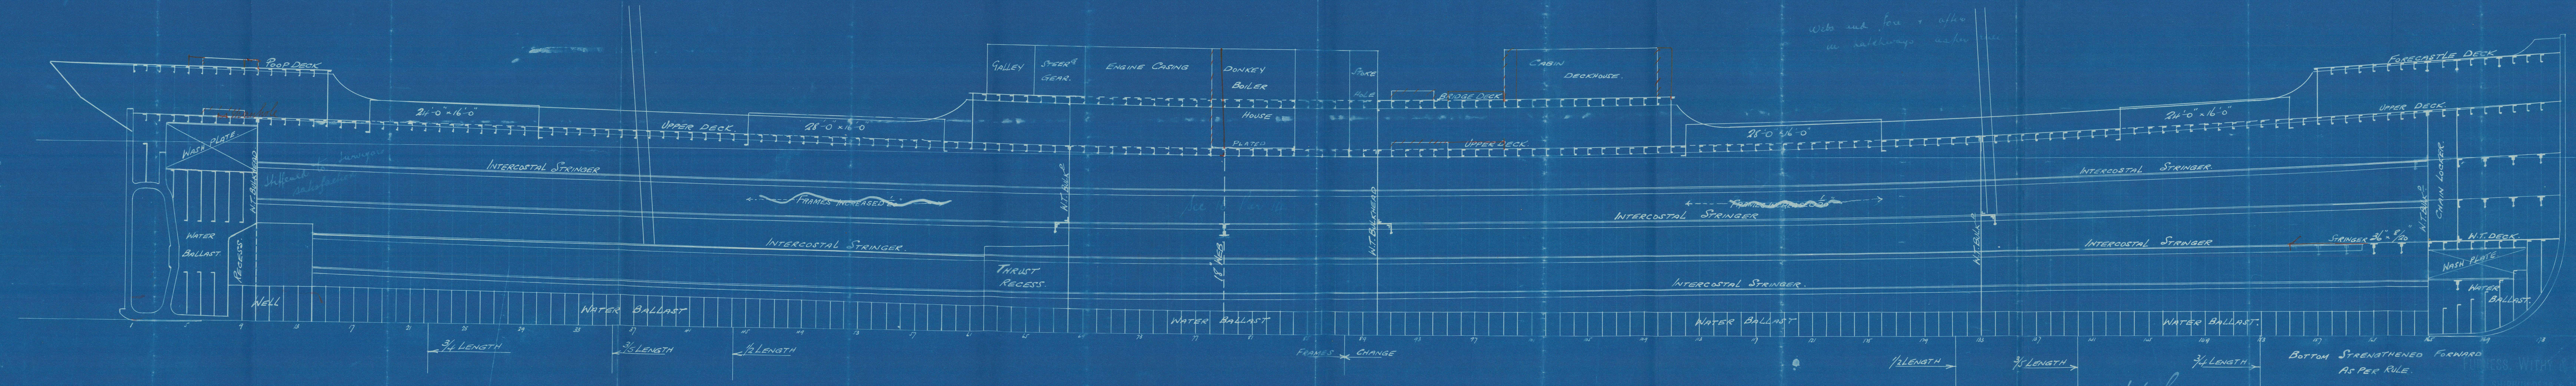

N<sup>o</sup>s 303, 304, 305, 306 S.S.

27/12/06

21.12.06

W812-0131ster  
Foundation




<sup>305</sup>  
Profile.

Furness, Withy & Co. Ltd.

No. 305.

ss. "balutta".

Upl. Report No.

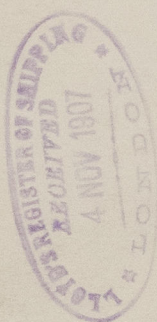

RETAIN



© 2021

Lloyd's Register  
Foundation

W812-0113