

# **Nº 20.** **PROFILE & DECK PLANS.**

DIMENSIONS: 450'0" BP - 57'9" BREADTH MO - 41'0" DEPTH MO TO SHELLING DE  
CLASS: LLOYDS 100 A1 SHELTER DECK WITH FREEBOARD  
SCALE: 1" = 10'0" ONE FOOT  
TRANSVERSE Nº 00 75 LONGITUDINAL Nº 40637

SHELTER DECK

UPPER DECK

LOWER DECK

TANK TOP

BRIDGE DECK

FORECASTLE DECK

SHELTER DECK

UPPER DECK

LOWER DECK

TANK TOP



© 2020



The Furness Shipbuilding Co's No 20


S. S. London Shipper

450 x 57'-9 x 41 Shells 8"

Profile & Decks  
(as Built.)

S.S. "London Shipper" (No 20)

MIDDLESBROUGH R/L No. 11683.

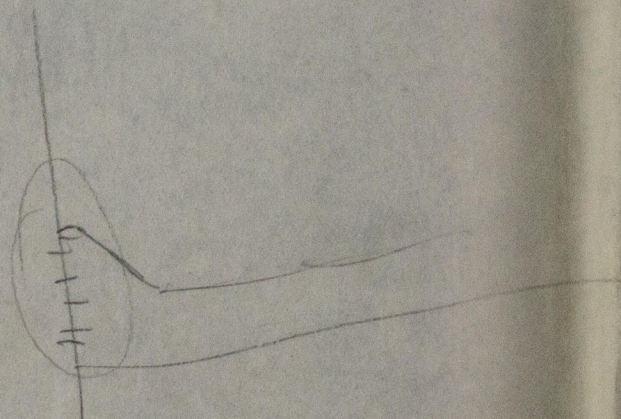

W85- 0120

W85- 0120



© 2020

Lloyd's Register  
Foundation