


*Profile of ship
as built
by Messrs. Schofield, Hagerup & Doughty, Ltd.
Great Grimsby*

— No 15 — S.S. KING GEORGE


— PROFILE OF —
STEEL STEAM TRAWLER.

LENGTH 104'-0" BREADTH 21'-0"
DEPTH OF HOLD 11'-7"
SCALE $\frac{1}{4}$ = ONE FOOT.

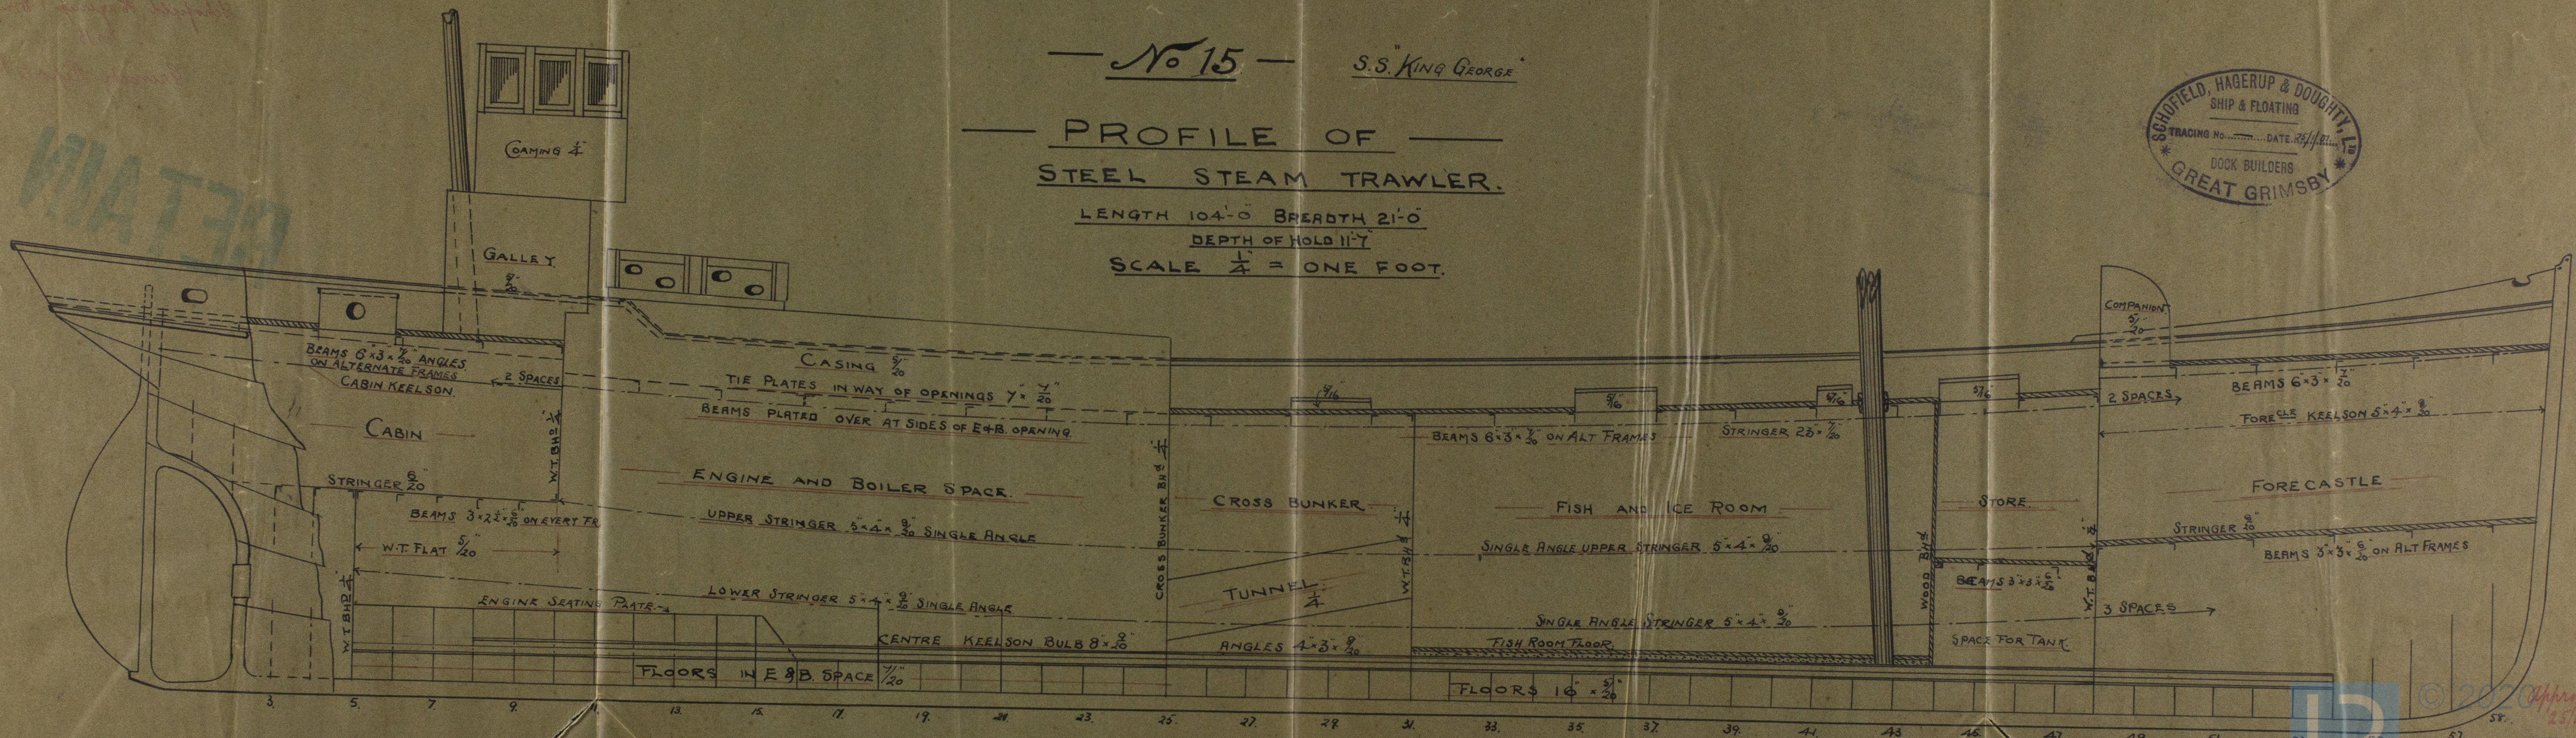

Profile
 s/s "King George"
 Schofield, Hagerup & Doughty & Co.
 1885

Grimsby Report No 989

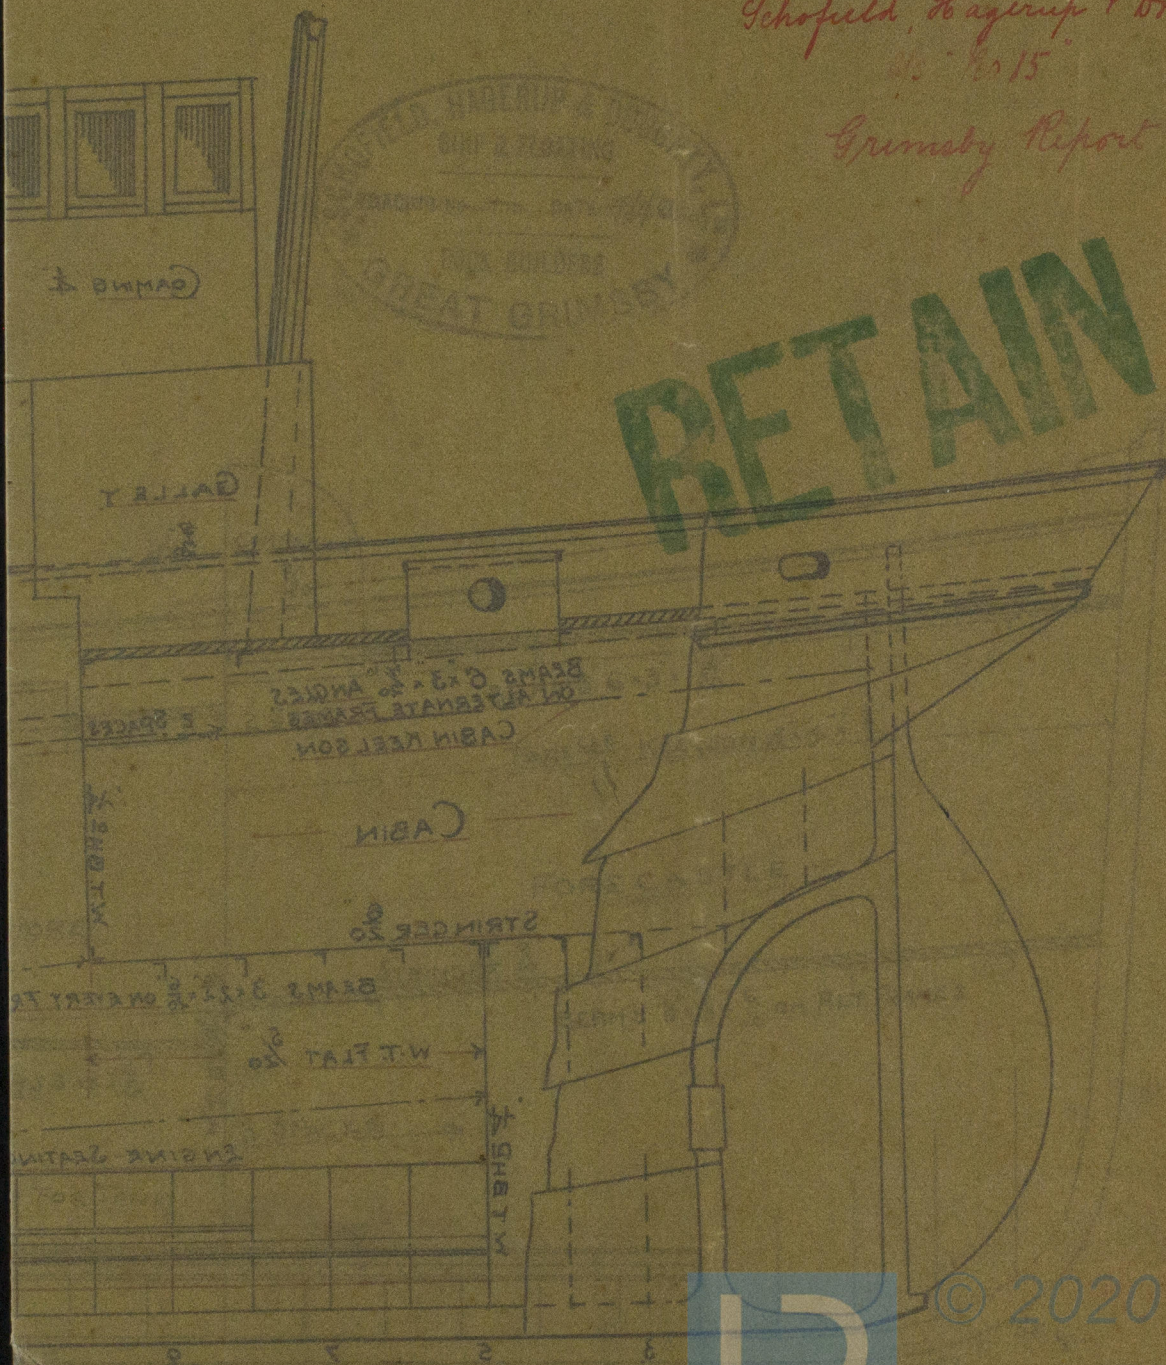

RETAIN



© 2020

Lloyd's Register
 Foundation

W869-0025