


*Wm Lloyd Garrison
to Child & Webb
22 Feb 60
New York*

SCALE $\frac{1}{8}" = 1 \text{ FOOT}$

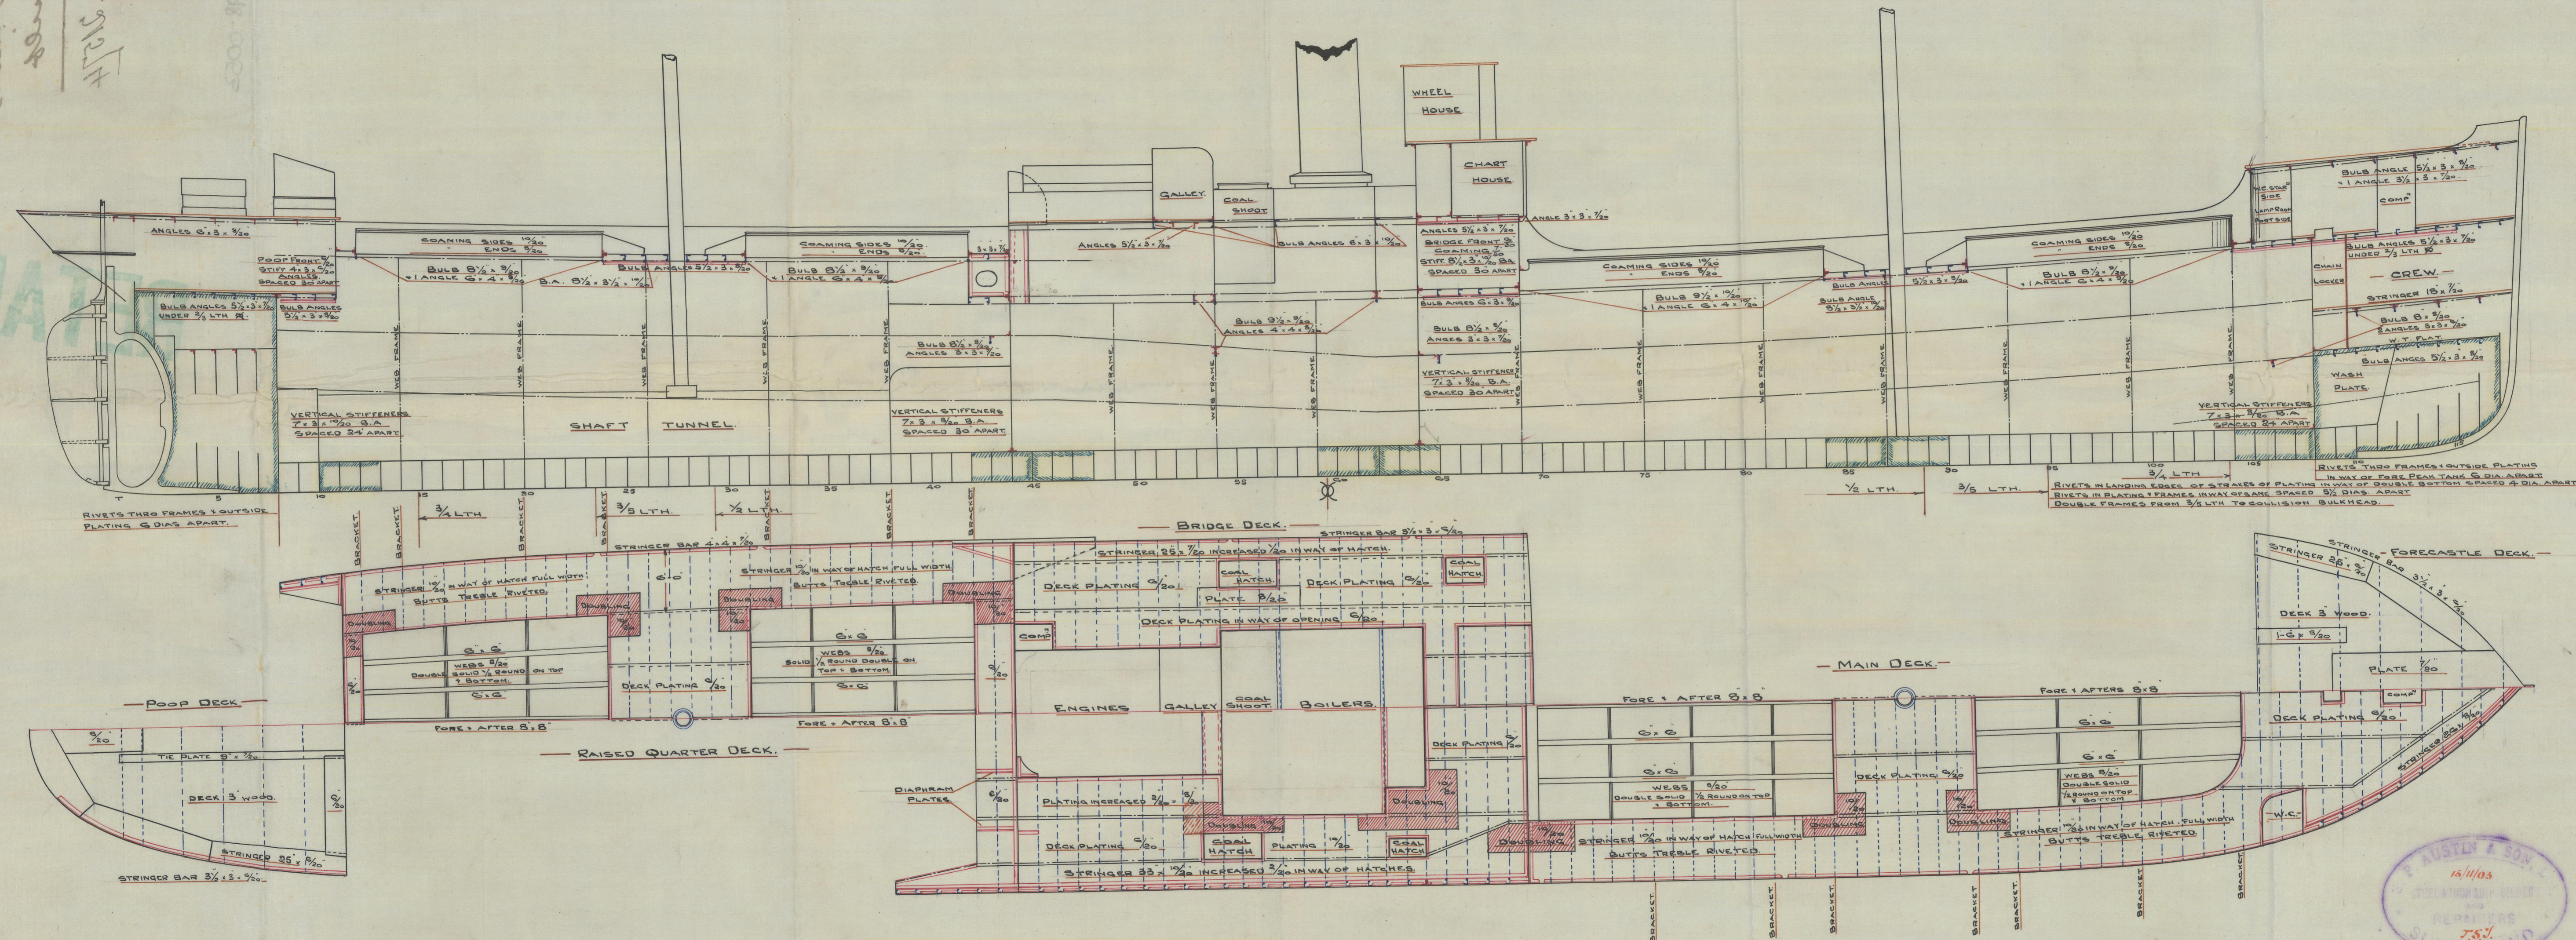


S. Austin
& Sons

No. 224

cc 22
SS Factor

Profile & decks
as built

Std. S.E. No. 21574

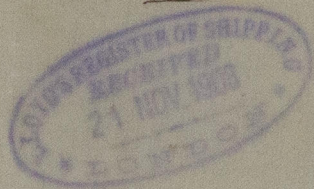

W898-0053



© 2020

Lloyd's Register
Foundation

MANUAL

