
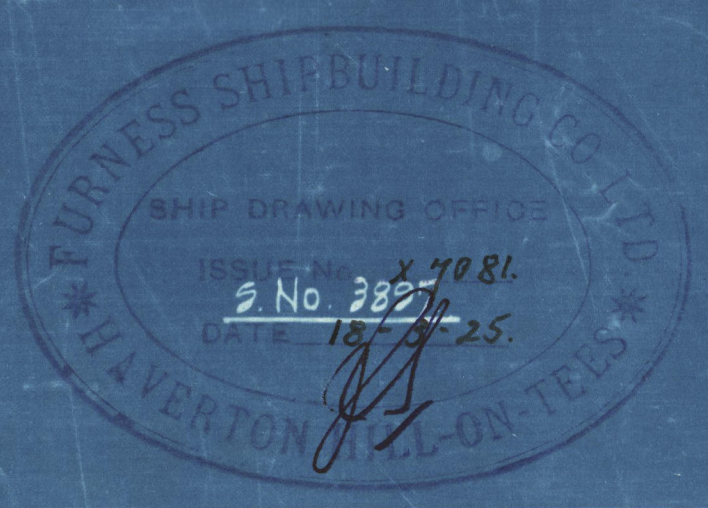


N^o 78. PROFILE & DECK PLANS.

DIMENSIONS 260'-0" B.P. x 58'-0" M.D. x 20'-0" U. DECK
TO CLASS ± 100 A.I. LLOYDS
SCALE 1/8" = 1 FOOT

SHELL ARRANGEMENT IN WAY OF BRIDGE
SCALE 1/8" = 1 FOOT

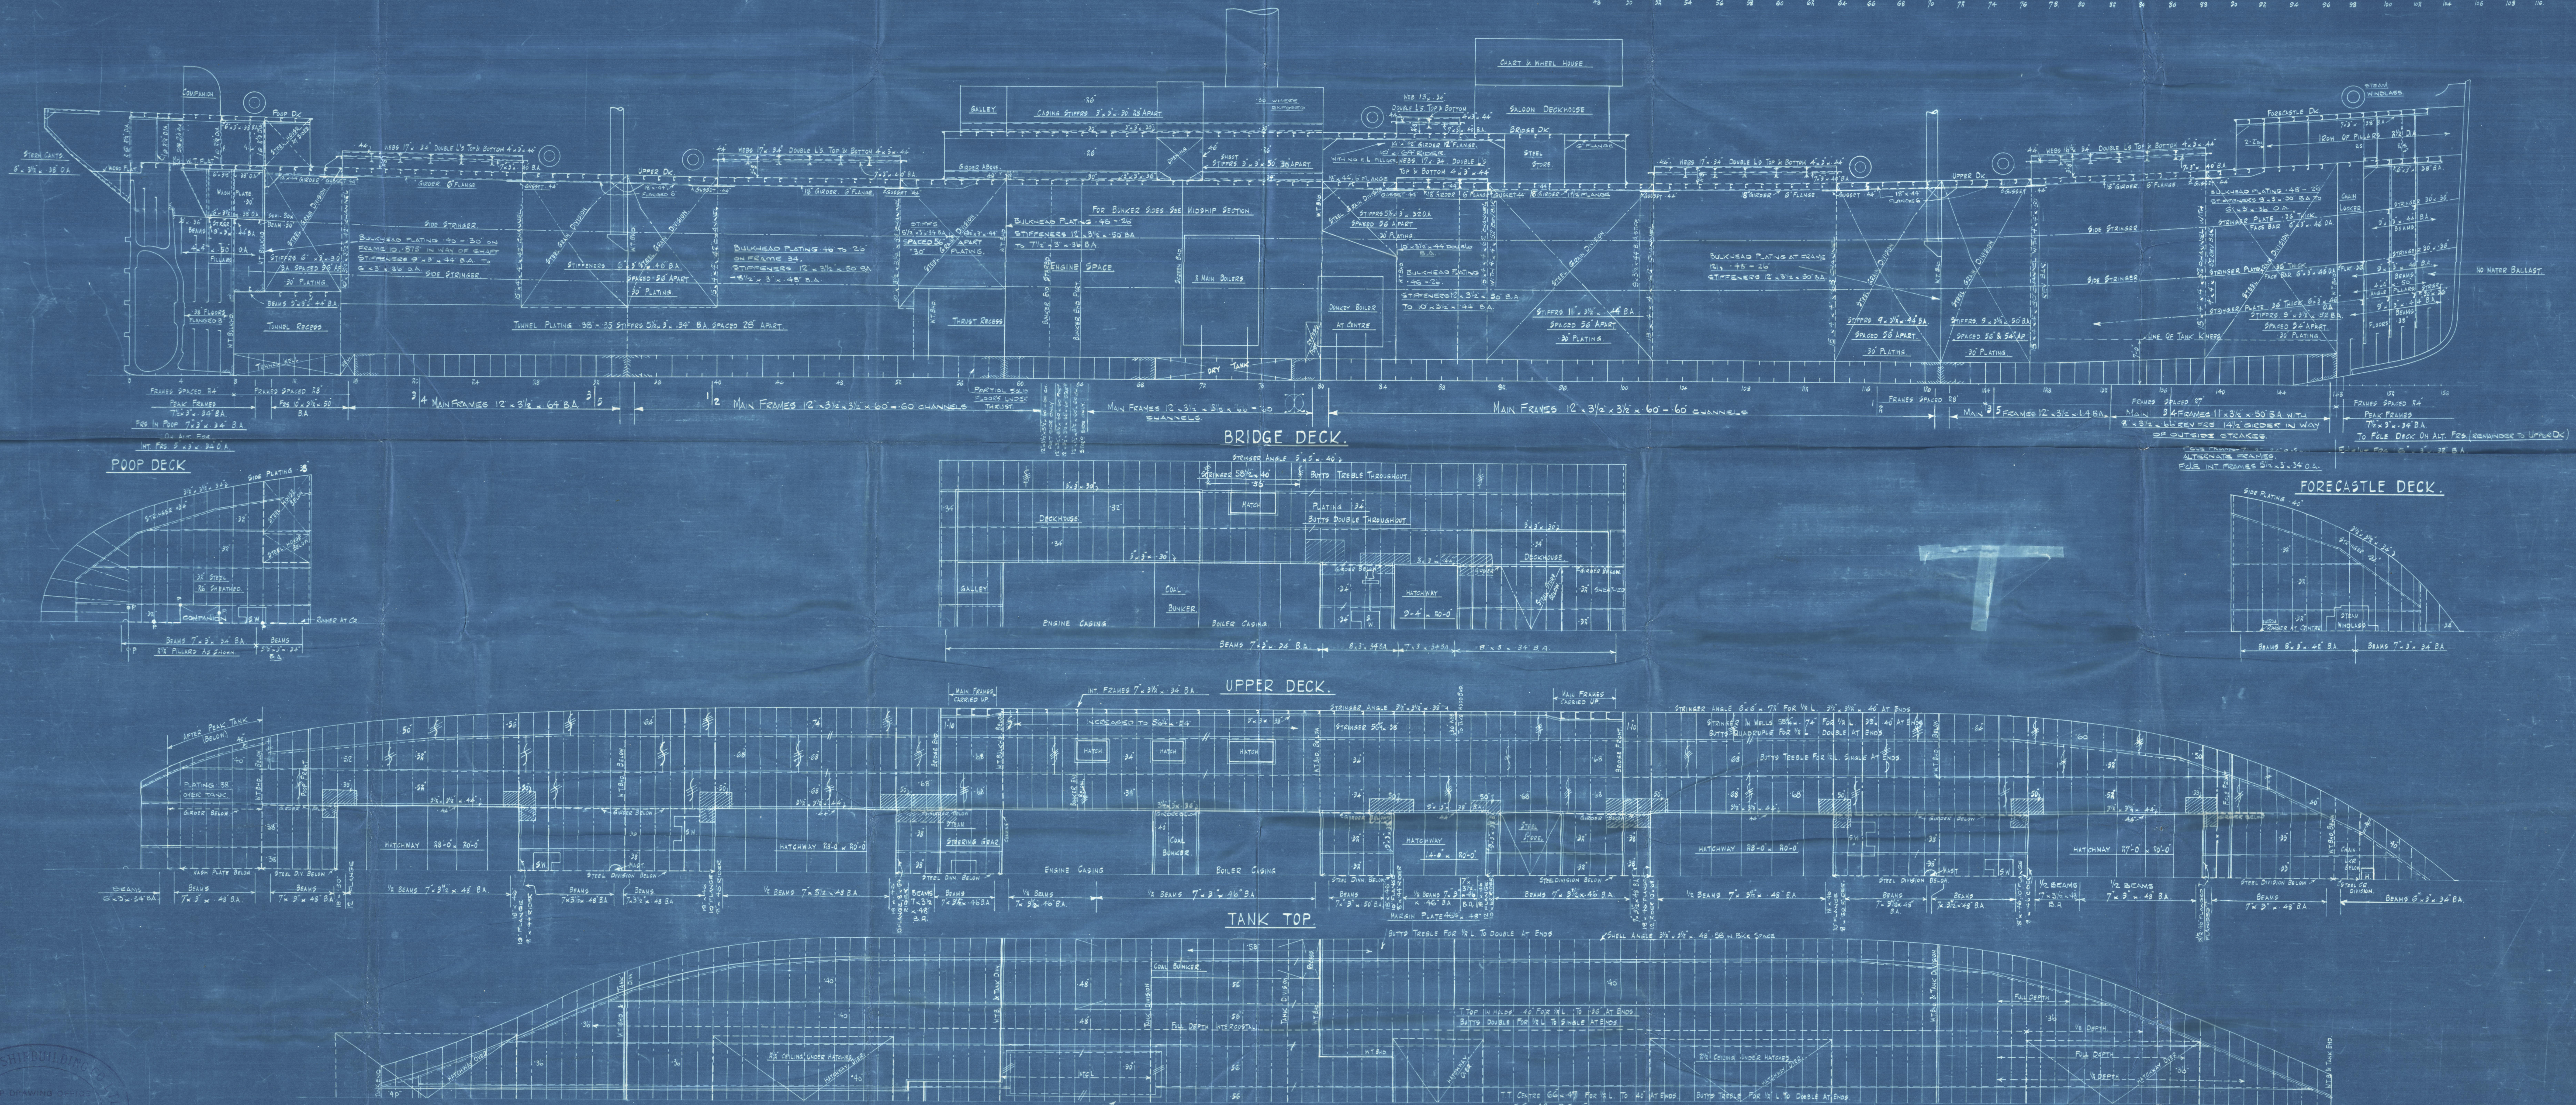

Furness Shipbuilding Coys N^o 78

S. S. "Tynebridge"

Profile and Decks
(as Built)

S.S. *Tynebridge*
MDB. RPT. No. 12291

W92-0095



© 2020

David Livingstone
Foundation