


B-252-24-A
B-249-24-A
B-247-24-A


B-252-24-A
B-249-24-A
B-247-24-A

3000
84 RPM

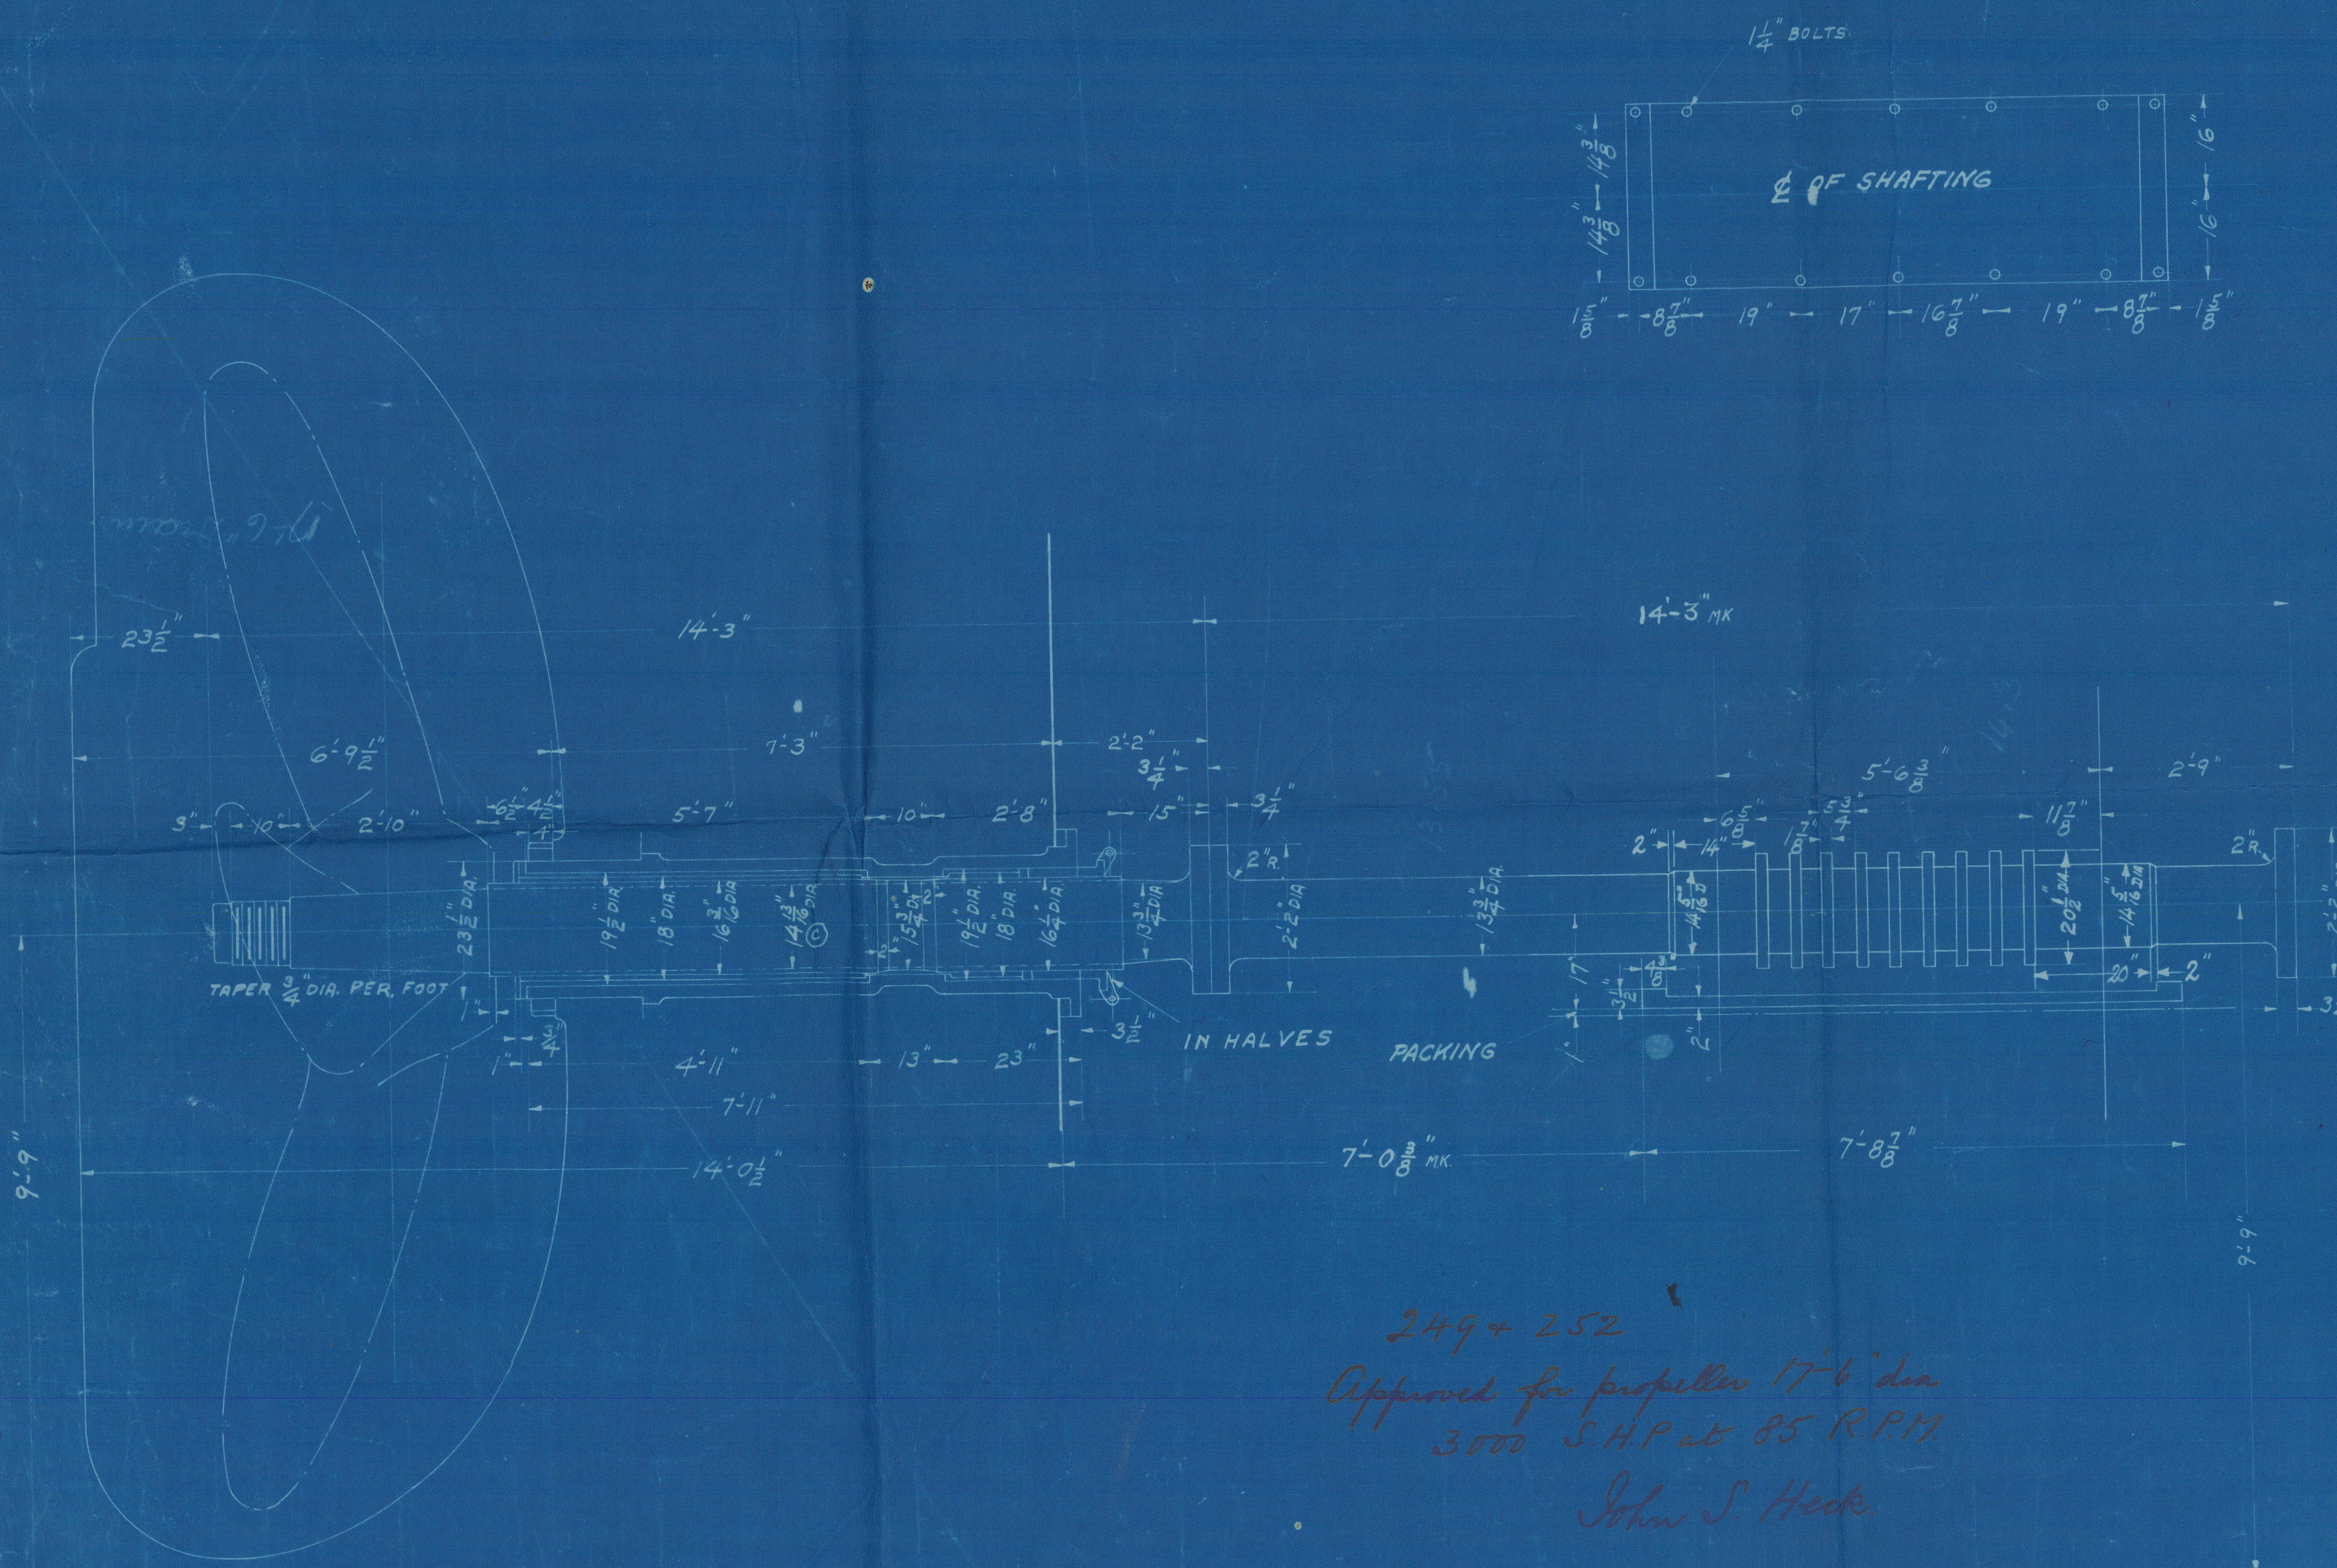

249 + 252
Approved for propeller 17' 6" dia
3000 S.H.P. at 85 RPM
John S. Hecke

247
Approved for propeller 18' 6" dia
John S. Hecke

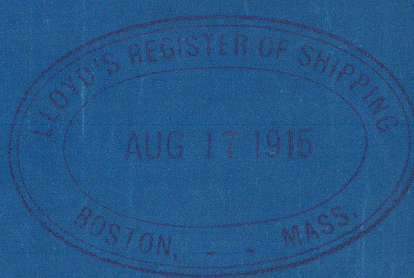

B-252-24-A
B-249-24-A
B-247-24-A

ARRANGEMENT AS SHOWN

ARRANGEMENT OF THRUST & PROPELLER SHAFTS

SCALE: 1/2" = 1 FT. DATE: 7-15-15

FORE RIVER SHIPBUILDING CORP.

QUINCY, MASS.
IN CHARGE: H.W. CHECKED BY: H.W. (MAY 21/15)
DRAWN BY: M.O.K. CHIEF DRAFTSMAN
TRACED BY: J.L.C. APPROVED: J.L.C.

ALTERATION	DATE	NOTED	APPROVED	DATE	B	D	I	M	N	P	V	C	A	W	R	E	C	S	R	A	E
SHAFTING CHANGED TO SUIT LLOYD'S INSPECTOR	6-4-15			4-16-15																	
CONTR. #249 ADDED	6-29-15			5-18-15																	
DIA. OF PROPELLER SHAFT CHANGED FROM 14 3/8" TO 14 1/2"	7-27-15			5-21-15																	
CONTR. #252 ADDED	8-7-15			7-6-15																	
				7-27-15																	
				7-27-15																	
				8-7-15																	

Lloyd's

B-252-24-A
B-249-24-A
B-247-24-A

Arrang^t of Shafing

247/~~49~~ + 252

~~F. R. S. B. Co.~~

FORE RIVER HULL 247.

S.S. "CLIBADIST", OF NEW YORK.

BOSTON REPORT NO. 252.



RETAIN



© 2021

Lloyd's Register
Foundation

W926-0116