


— Scale $\frac{1}{8}$ " = 1 Foot —

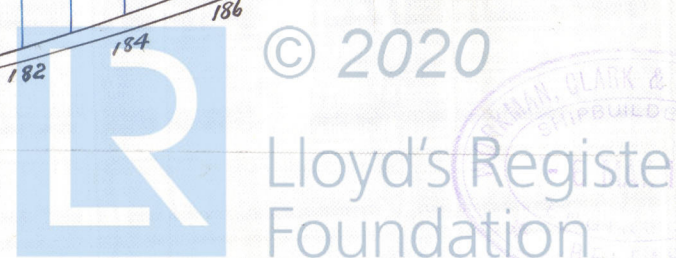

W94 / -0238 2/2

For Enclosure to

Messrs.

Lloyds Tureyos.

W941-0238 1/2

Wortman Clark & Co

SS 199

Profile Plan
as built.

S.S. Counsellor.

Bel 5593

RETAIR



Points through frames
Outside plating & dies apart



© 2020

Lloyd's Register
Foundation

W941-0238