

See Amended Plans.

S.S. No 213

PROFILE, STRINGER & DECK PLANS.

SCALE 1/2" = 1'

DIMENSIONS 380-0 B.P. x 50-6 EX x 28-0 3/4 TO UPPER DECK.

SHELTER DECK HATCH END BEAMS (5 1/2 x 3 x 1/20 O.A. 5 1/2 x 3 1/2 x 9/20 O.A. 7 x 3 1/2 x 9/20 O.A. 3 1/2 x 3 1/2 x 9/20 O.A.)

UPPER & MIDDLE DECKS HATCH END BEAMS.


5.6.07  
4.7.07  
11.7.07  
28.8.07  
2.9.07

ORDINARY FRAMING  
FRAMES 6 x 3/2 x 9/20 O.A.  
REVERSES 4 1/2 x 3 1/2 x 9/20 O.A.

SPAN	OF	SIZE	THICKNESS
25-0	OF	6 x 4 x 1/20	3/20
22-11	OF	6 x 4 x 13/20	3/20
18-9	OF	6 x 4 x 9/20	7/20
20-10	OF	6 x 4 x 11/20	9/20

SPAN	OF	SIZE	THICKNESS
25-0	OF	6 x 6 x 17/20	19/20
22-11	OF	6 x 6 x 13/20	19/20
18-9	OF	6 x 6 x 9/20	8/20
20-10	OF	6 x 6 x 11/20	9/20

SPAN	OF	SIZE	THICKNESS
25-0	OF	6 x 6 x 17/20	19/20
22-11	OF	6 x 6 x 13/20	19/20
18-9	OF	6 x 6 x 9/20	8/20
20-10	OF	6 x 6 x 11/20	9/20

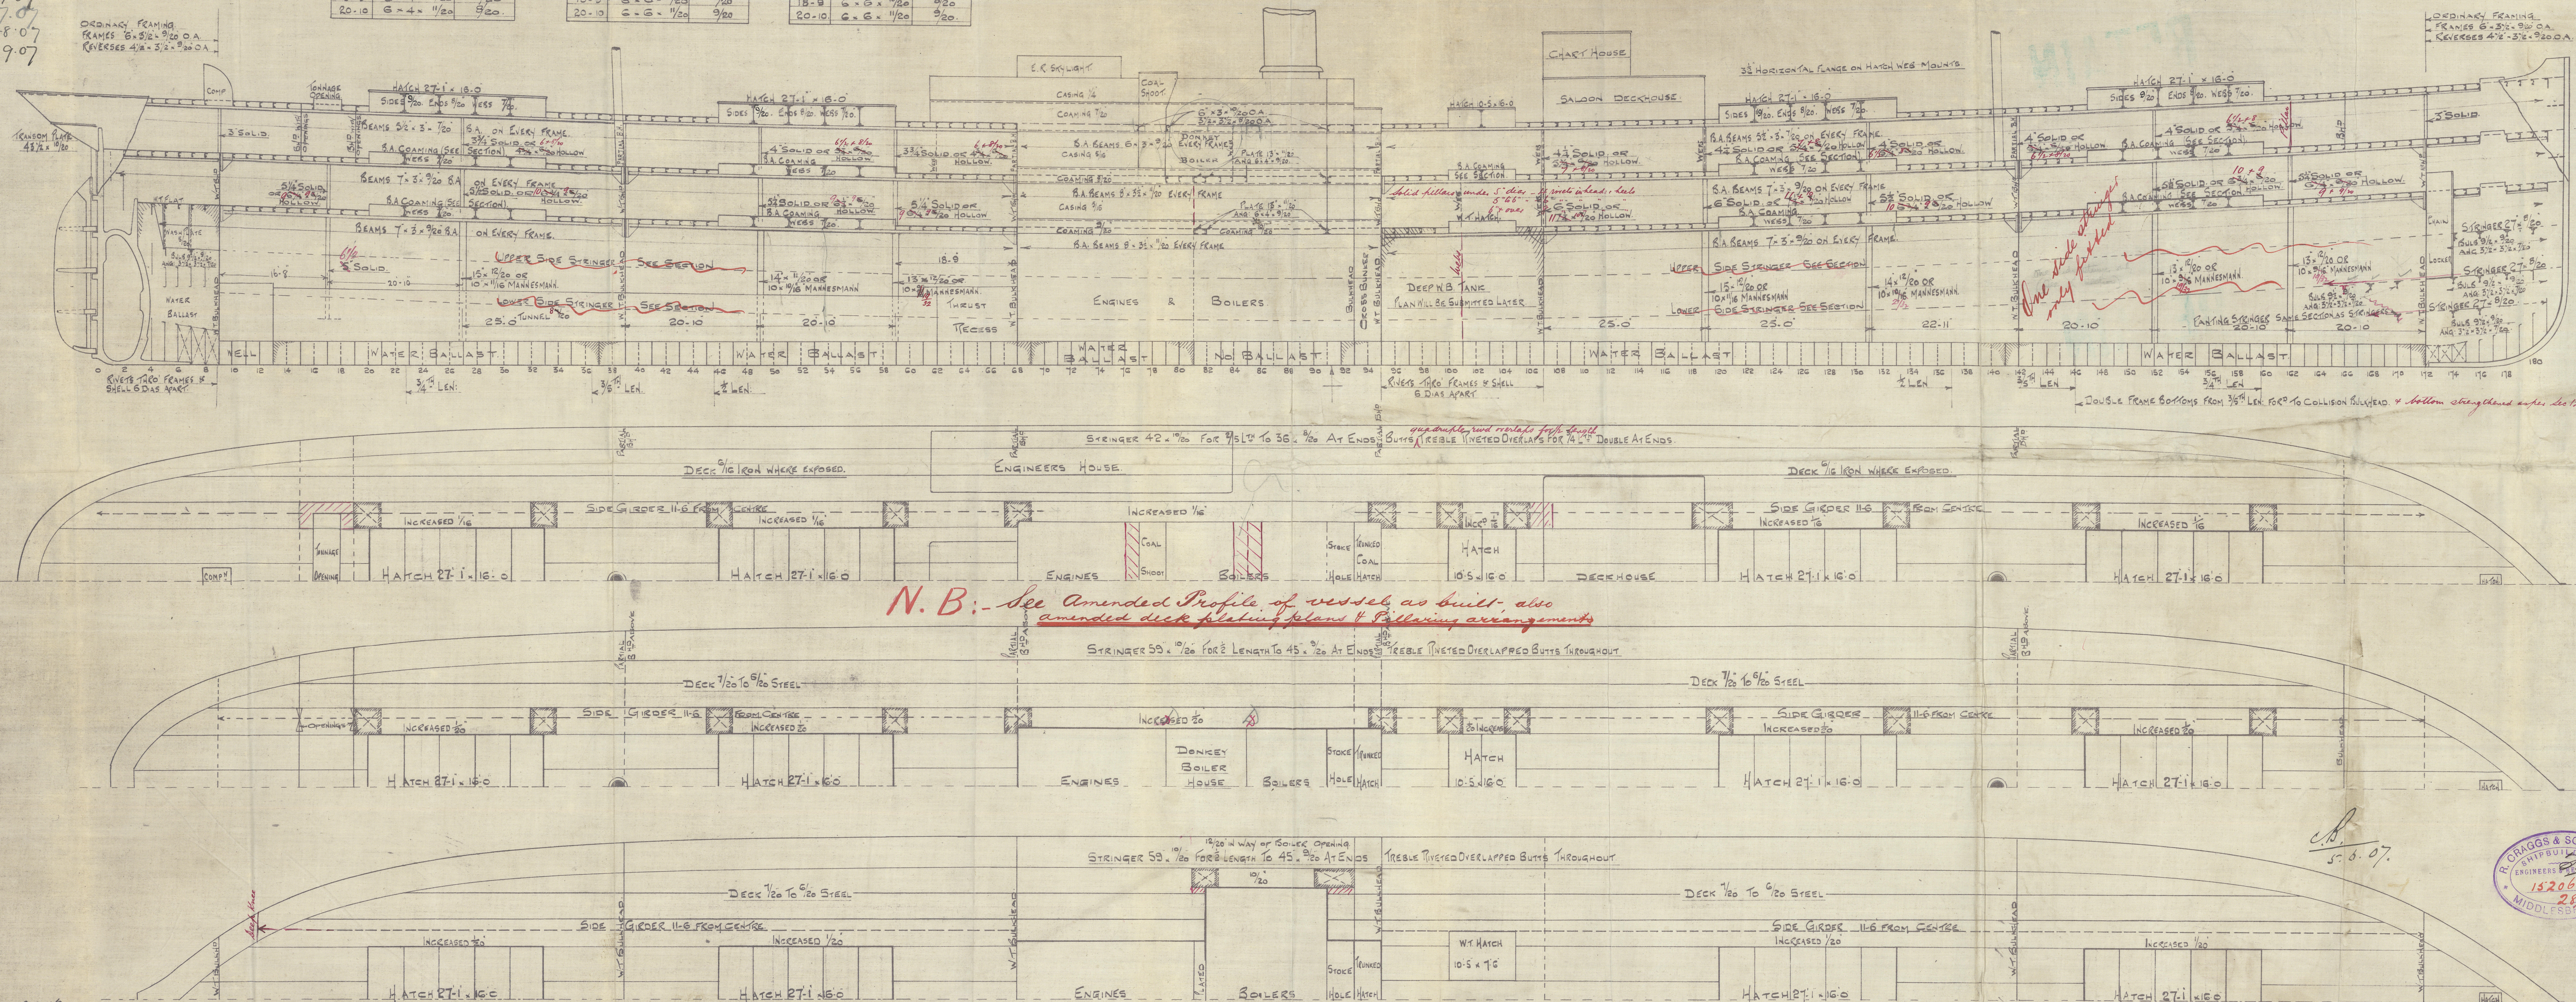

R. CRAGG & SONS LTD  
SHIPBUILDERS & REPAIRERS  
1885 DOCKYARD  
MIDDLERSBRO'

R. CRAGG & SONS LTD  
SHIPBUILDERS & REPAIRERS  
1885 DOCKYARD  
MIDDLERSBRO'







W959-0075

R. Crapp Sons  
No 213

Profile.  
(See Copy of Profile  
of vessel as built)

S.S. "Dacre Castle"  
Medb. Aft. No. 5383.

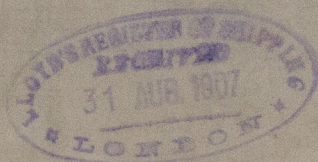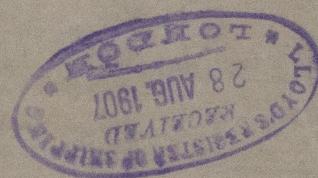

RETAIN

RETAIN



© 2020

Lloyd's Register  
Foundation