

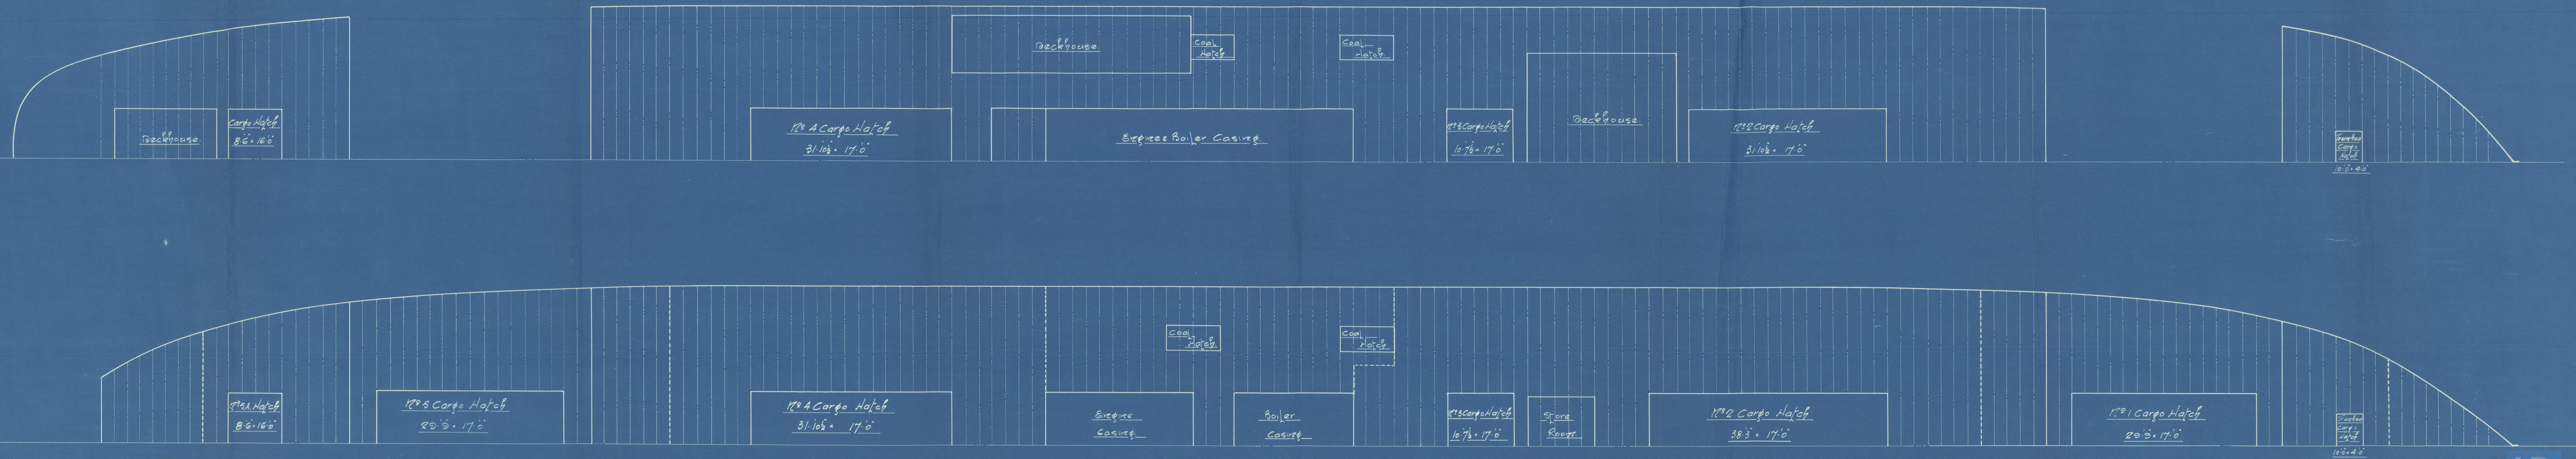


No 522 Ship.
 S/s "Hedgehope."
 Amended Profile & Deck Plans.
 Scale 1/8" = 1'-0"

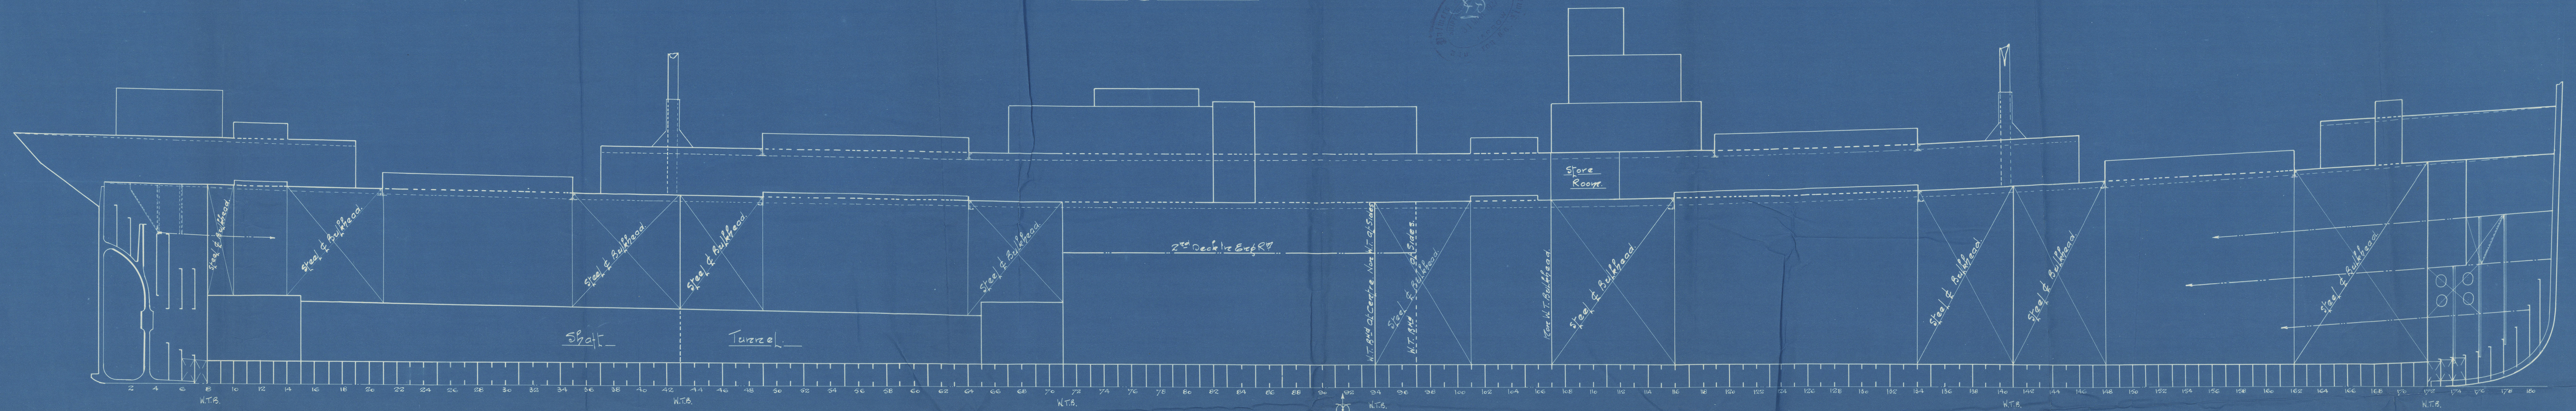

Palmer 922

2

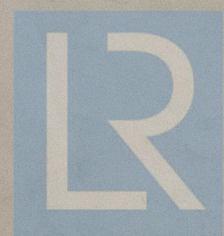

© 2020

Lloyd's Register
Foundation

Palmers

922

Profile + deck (as built)
"m Langlee-gorse"

S.S. "HEDGE HOPE"

NEWCASTLE ON TYNE.

Report No. 81191

RETAIN



© 2020

Lloyd's Register
Foundation

W982-0160