
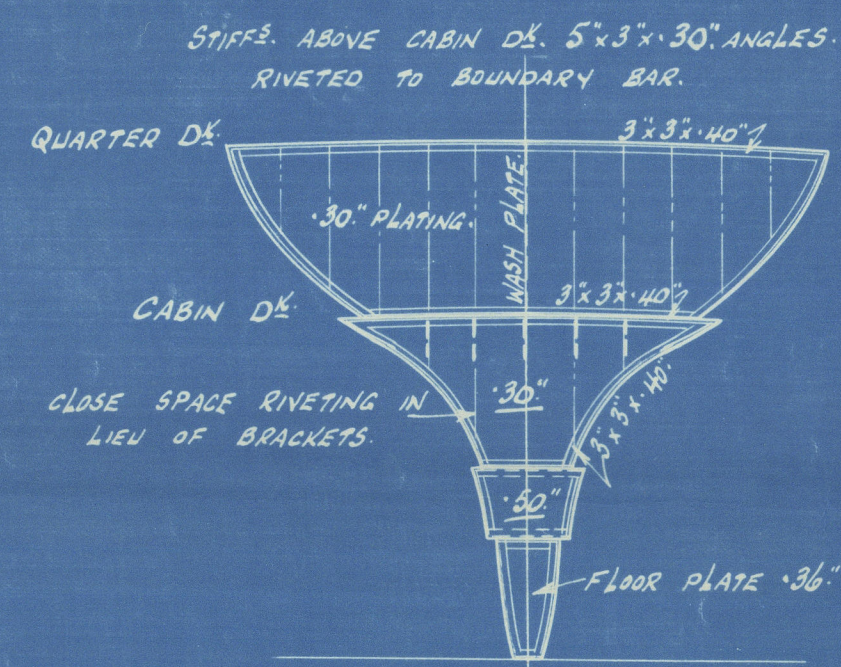
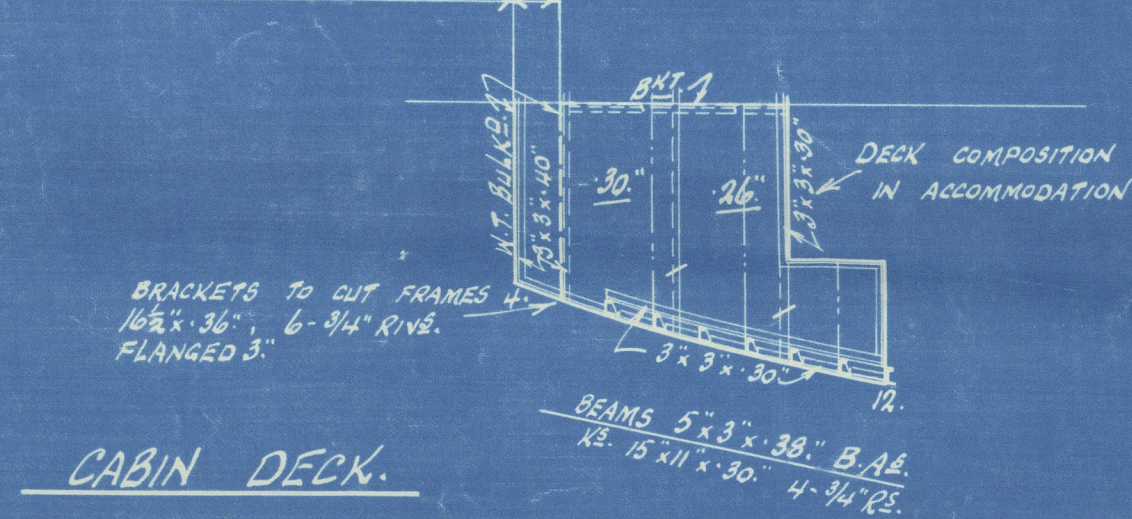
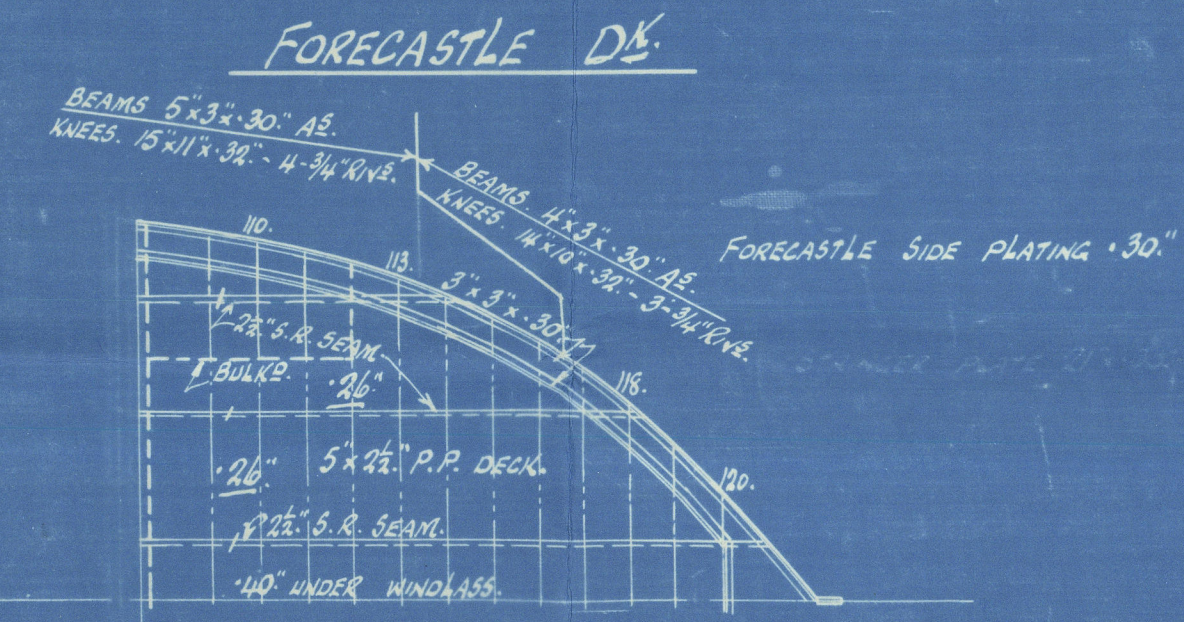
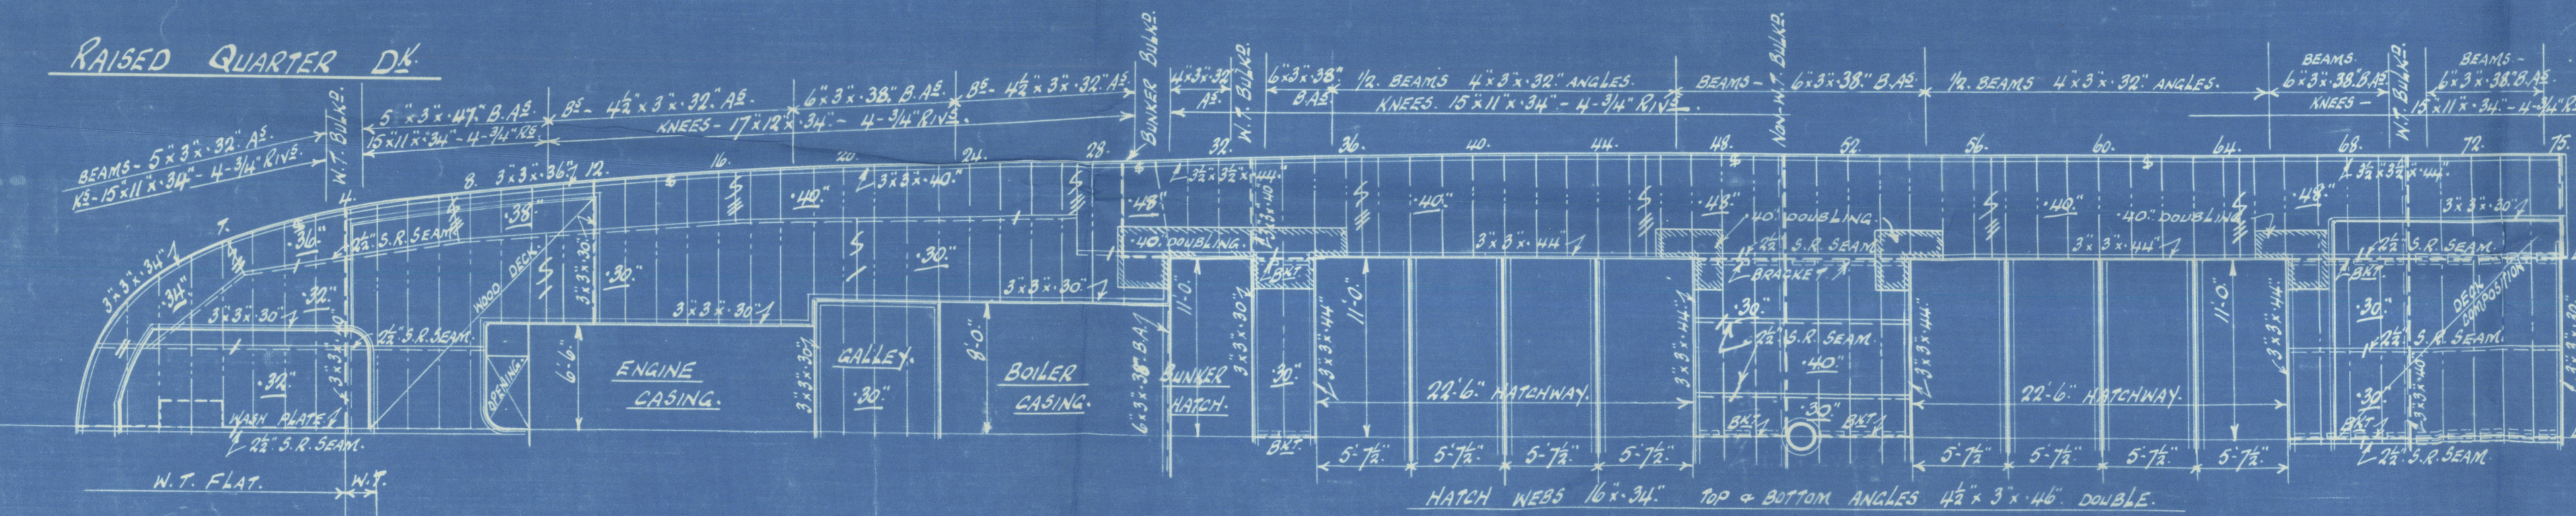




No. 344. PROFILE + DECKS.

SCALE  $\frac{1}{8}" = 1$  FOOT.

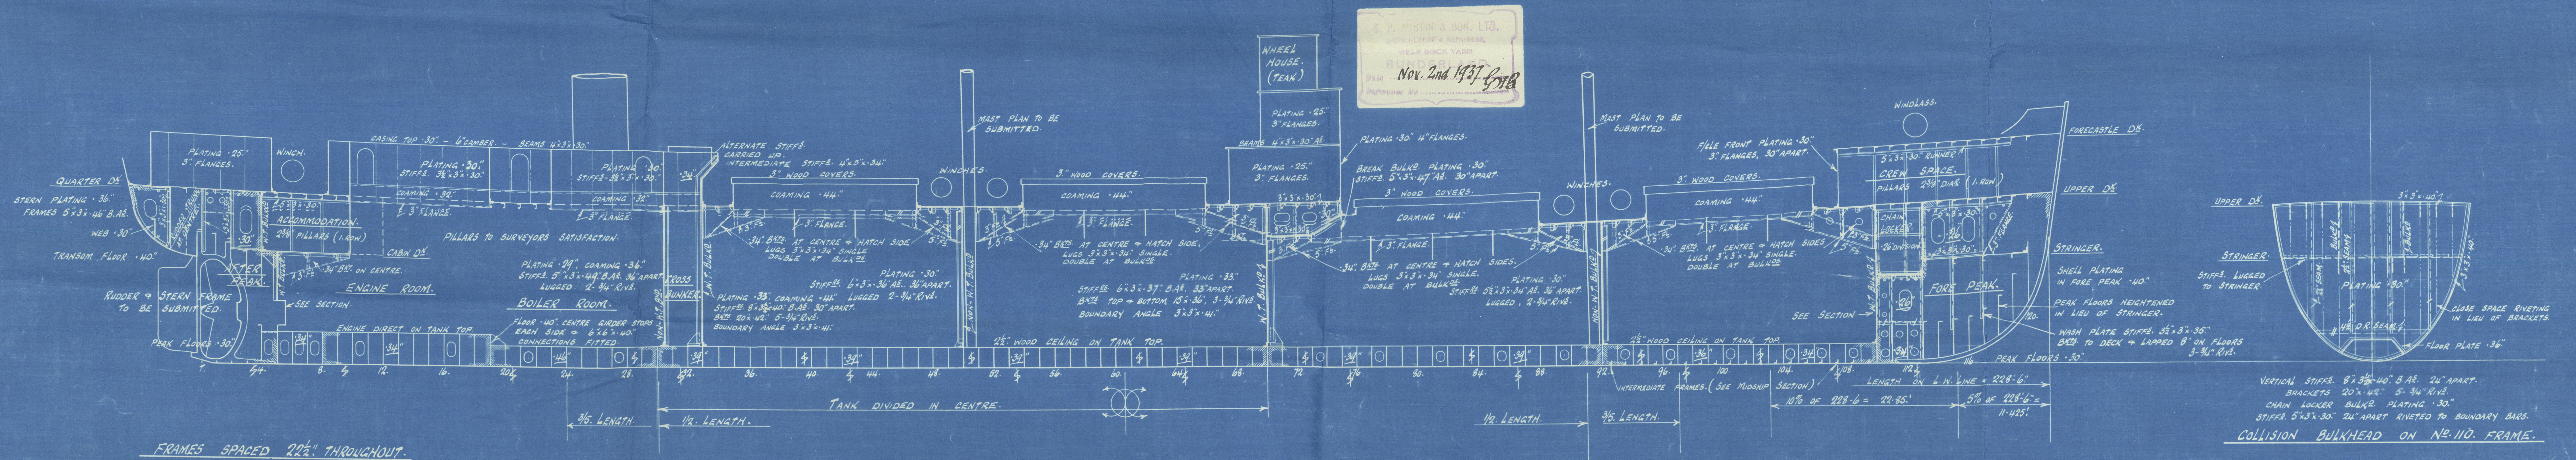


AFTER PEAK BULKHEAD ON NOS. 4 & 5. FRAMES.

STRENGTHENING IN WAY OF BREAK.

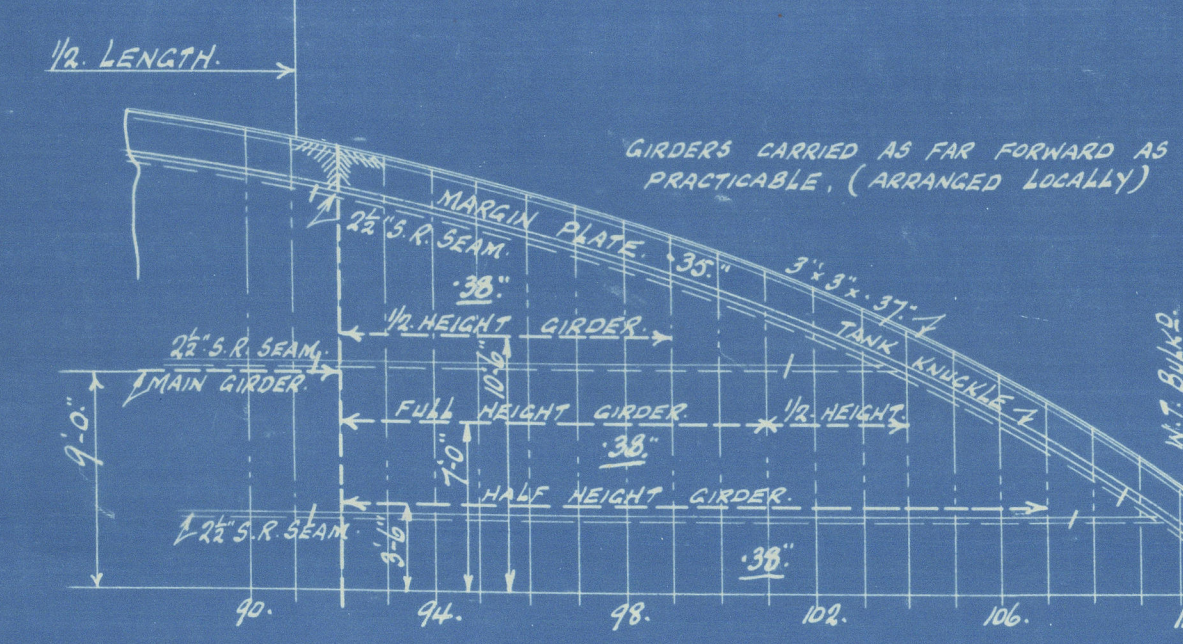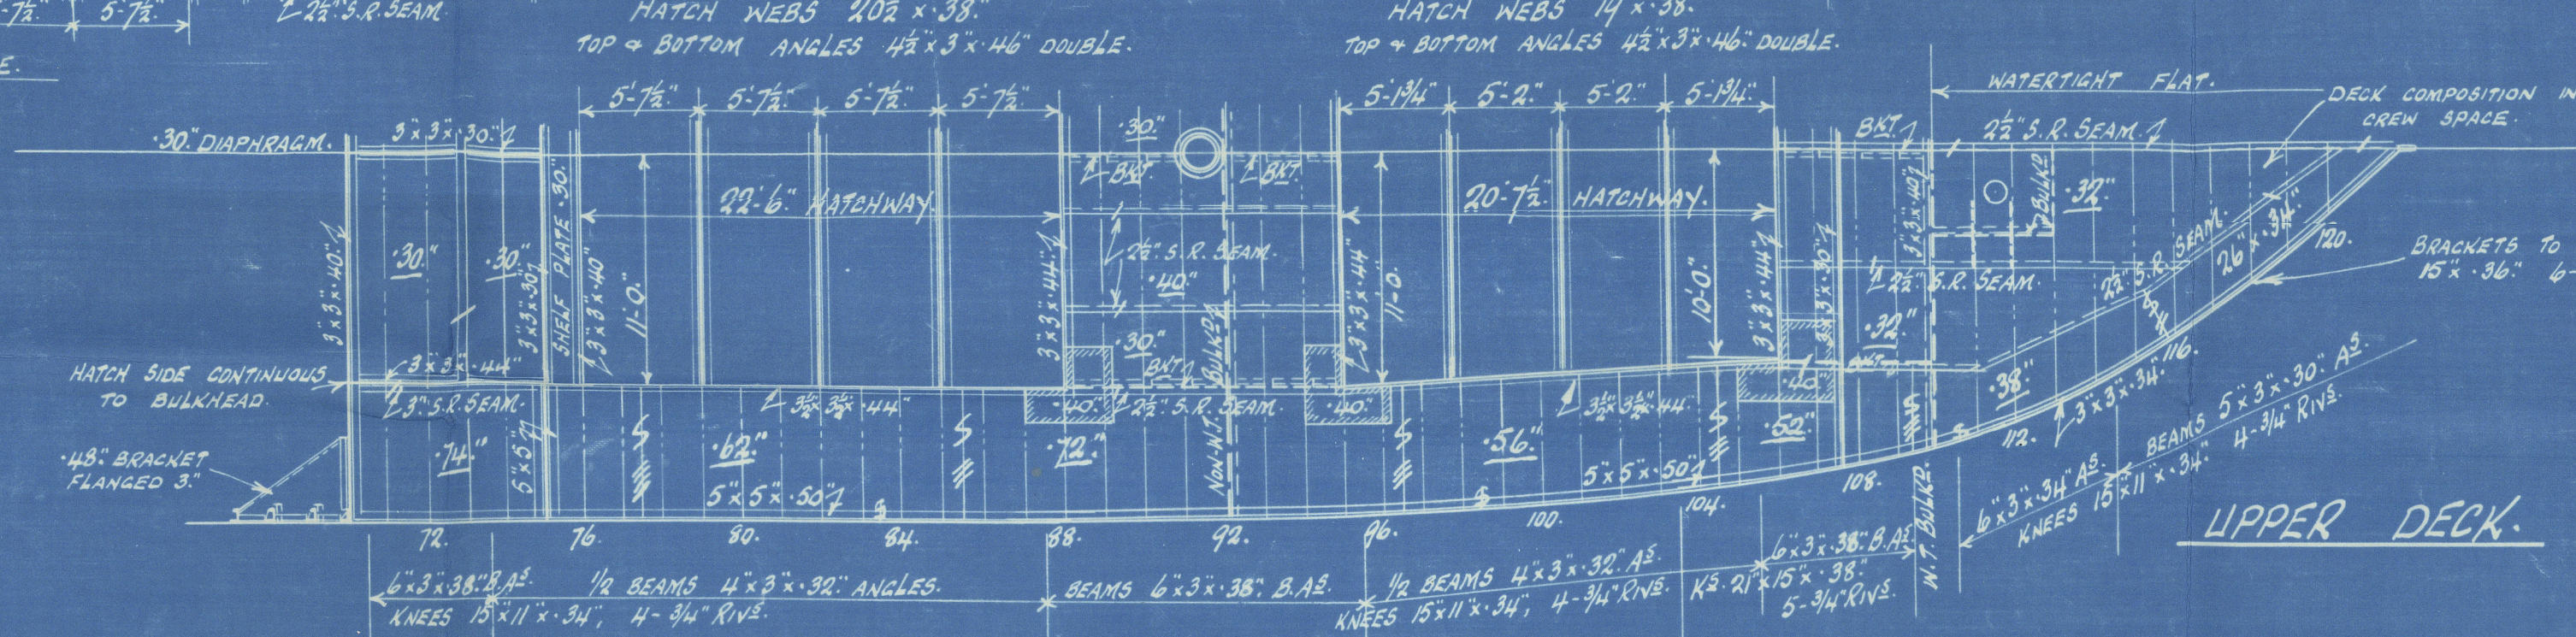

DOUBLE BOTTOM FORWARD.

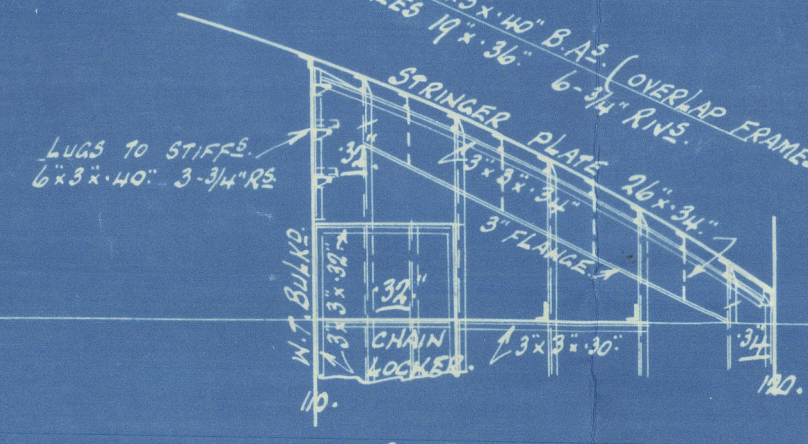

STRINGER.

<u>FREEBOARD PARTICULARS.</u>	
<u>LENGTH ON L.W. LINE.</u>	<u>228.50'</u>
<u>BREADTH MOULDED.</u>	<u>35.83'</u>
<u>DEPTH "</u>	<u>15.50'</u>
<u>85% " "</u>	<u>13.175'</u>
<u>MOULDED DISPLACEMENT AT</u>	<u>2227 TONS.</u>
<u>85% DEPTH MOULDED.</u>	
<u>DISPLACEMENT COEFF.</u>	<u>.723.</u>
<u>RAISED QUARTER DE</u>	<u>141.16' x 3.75'</u>
<u>FORECASTLE.</u>	<u>26.46' x 7.25'</u>
<u>SHEER AFT.</u>	<u>2' 3"</u>
<u>" FORWARD.</u>	<u>5' 4 1/2"</u>
<u>PARABOLIC CURVE TO RULE.</u>	



W983-0279

---

Messrs. S.P. Austin & Son, Ltd.

Profile & Decks.

S.S. "GWYNWOOD".

(As Built).

---

RETAIN



© 2020

Lloyd's Register  
Foundation