

S.S. "THE VICEROY."

MIDSHIP SECTION.

SCALE 1/2 INCH = 1 FOOT.

MOULDED DIMENSIONS: 195'-0" x 30'-3" x 14'-2" TO UPPER DECK.
18'-2" TO R.Q. DECK.

TO CLASS LLOYD'S 100 A.I.

NOTE: THROUGHOUT NO RIVET LESS THAN 3/4 DIAM EXCEPT IN CASING AND HOUSES.

| | BRIDGE DECK | FORECASTLE DECK |
|-----------------------|---------------------------|---------------------------------------|
| HEIGHT BEAM TO BEAM | 7'-6" | 7'-3" |
| ROUND OF BEAM | 7 1/2" | 7 1/2" |
| BEAMS ON ALTER FRAMES | 5' x 3' x 36" B.A. | 4 1/2' x 36" B.A. TO 14' x 30" ANGLES |
| BEAM KNEES | 15' x 12' x 32' 4-3/4 RVS | 14' x 12' x 34' 4-3/4 R |
| SIDE PLATING | 27" | 27" |
| STRINGER PLATE | 3 1/4' x 27" | 17 1/2' x 27" |
| STRINGER ANGLE | 3' x 3' x 27" | 3' x 3' x 27" |
| CUTTER ANGLE | 2 1/2' x 2 1/2' x 36" | 2 1/2' x 2 1/2' x 36" |
| TIE PLATES | 7' x 27" | 7' x 27" |
| WOOD DECK | 5' x 2 1/2" P. PINE | 5' x 2 1/2" P. PINE |


| LLOYD'S NUMERALS | |
|-----------------------------|----------|
| L | 195-0 |
| B | 30-25 |
| D | 14-17 |
| d TO UPPER DECK | 11-66 |
| d TO QUARTER DECK (HOLD) | 15-66 |
| d TO QUARTER DECK (B SPACE) | 17-36 |
| d TO QUARTER DECK (E SPACE) | 14-16 |
| 1/2 TO UPPER DECK | 13-76 |
| 1/2 TO QUARTER DECK | 10-73 |
| L x D | 27-63-15 |
| L x (B + D) | 8-66-19 |
| ERECTOR'S | 77-6% |

| EQUIPMENT NUMERAL | |
|-------------------------------------|--------------------|
| 2 ND LONGITUDINAL NUMBER | 8661-90 |
| QUARTER DECK | 110-5 x 4 |
| FORECASTLE DECK | 30-0 x 7-25 x 7-5 |
| BRIDGE DECK | 10-83 x 7-5 x 7-5 |
| CASING | 58-65 x 7-75 x 5-0 |
| EQUIPMENT NUMBER | 9555 |

| EQUIPMENT (LETTER A) | |
|---|-----------------------------------|
| 2 BOWER ANCHORS, STOCKLESS, EACH 19 CWTs. | 4 BOWER STOCKLESS AT 16 1/4 CWTs. |
| 1 STREAM ANCHOR 5 1/4 CWTs. | EX STOCK. |
| 210 FATHS 1 1/2" STUD CHAIN CABLE | |
| 60 3/4" STEEL STREAM WIRE | |
| 90 3" STEEL WIRE TOWLINE | |
| 1 OFF 90 FATHS 6" MANILLA HEMP HAWSER | |
| 1 90 FATHS 5" MANILLA WARD | |

| | BOILER SPACE | ENG. SPACE |
|------------------|-----------------------|-----------------------|
| FRAMES | 6' x 3' x 41" | 6' x 3' x 30" B.A. |
| REV. FRAMES | 3' x 3' x 41" | 3 1/2' x 3' x 35" |
| FLOORS | 19 1/2' x 41" | 38" |
| EN. THRU PLATE | 50" | 46" |
| FOUNDATION PLATE | 32' x 49" | 45" |
| TOP ANGLES | 3' x 3' x 42" | 3' x 3' x 42" |
| BOTTOM ANGLES | 3 1/2' x 3 1/2' x 44" | 3 1/2' x 3 1/2' x 44" |
| VERT. ANGLES | 3' x 3' x 49" | 3' x 3' x 45" |
| SIDE INT. PLATE | 42" | 36" |
| BOTTOM ANGLES | 3' x 3' x 36" | 3' x 3' x 32" |
| VERT. ANGLES | NONE | 3' x 3' x 38" |

| | 1/2 LENGTH | ENDS |
|----------------------------------|--------------------------------------|---------------|
| BUTT RIVETING | | |
| KEEL | TREBLE STRAPS | TREBLE STRAPS |
| SHEER STRAKE UPPER DK. | | DOUBLE LAPS |
| QUAR DK. | TREBLE LAPS | |
| STRAKE BELOW SHEER | | |
| BOTTOM PLATING | DOUBLE LAPS | |
| SIDE PLATING | | |
| UPPER DK. STRINGER PLATES | TREBLE LAPS | |
| QUAR | | |
| B.R. FEEL | DOUBLE LAPS | |
| TANK MARGIN & MIDDLE LINE STRAKE | | |
| TANK TOP PLATING | | SINGLE LAPS |
| B.R. FEEL SIDE PLATING | | |
| EDGE RIVETING | | |
| SHELL PLATING | DOUBLE LAPS THROUGHOUT TO UNIMMERSED | |
| DECK | SINGLE LAPS | |
| TANK TOP | | |

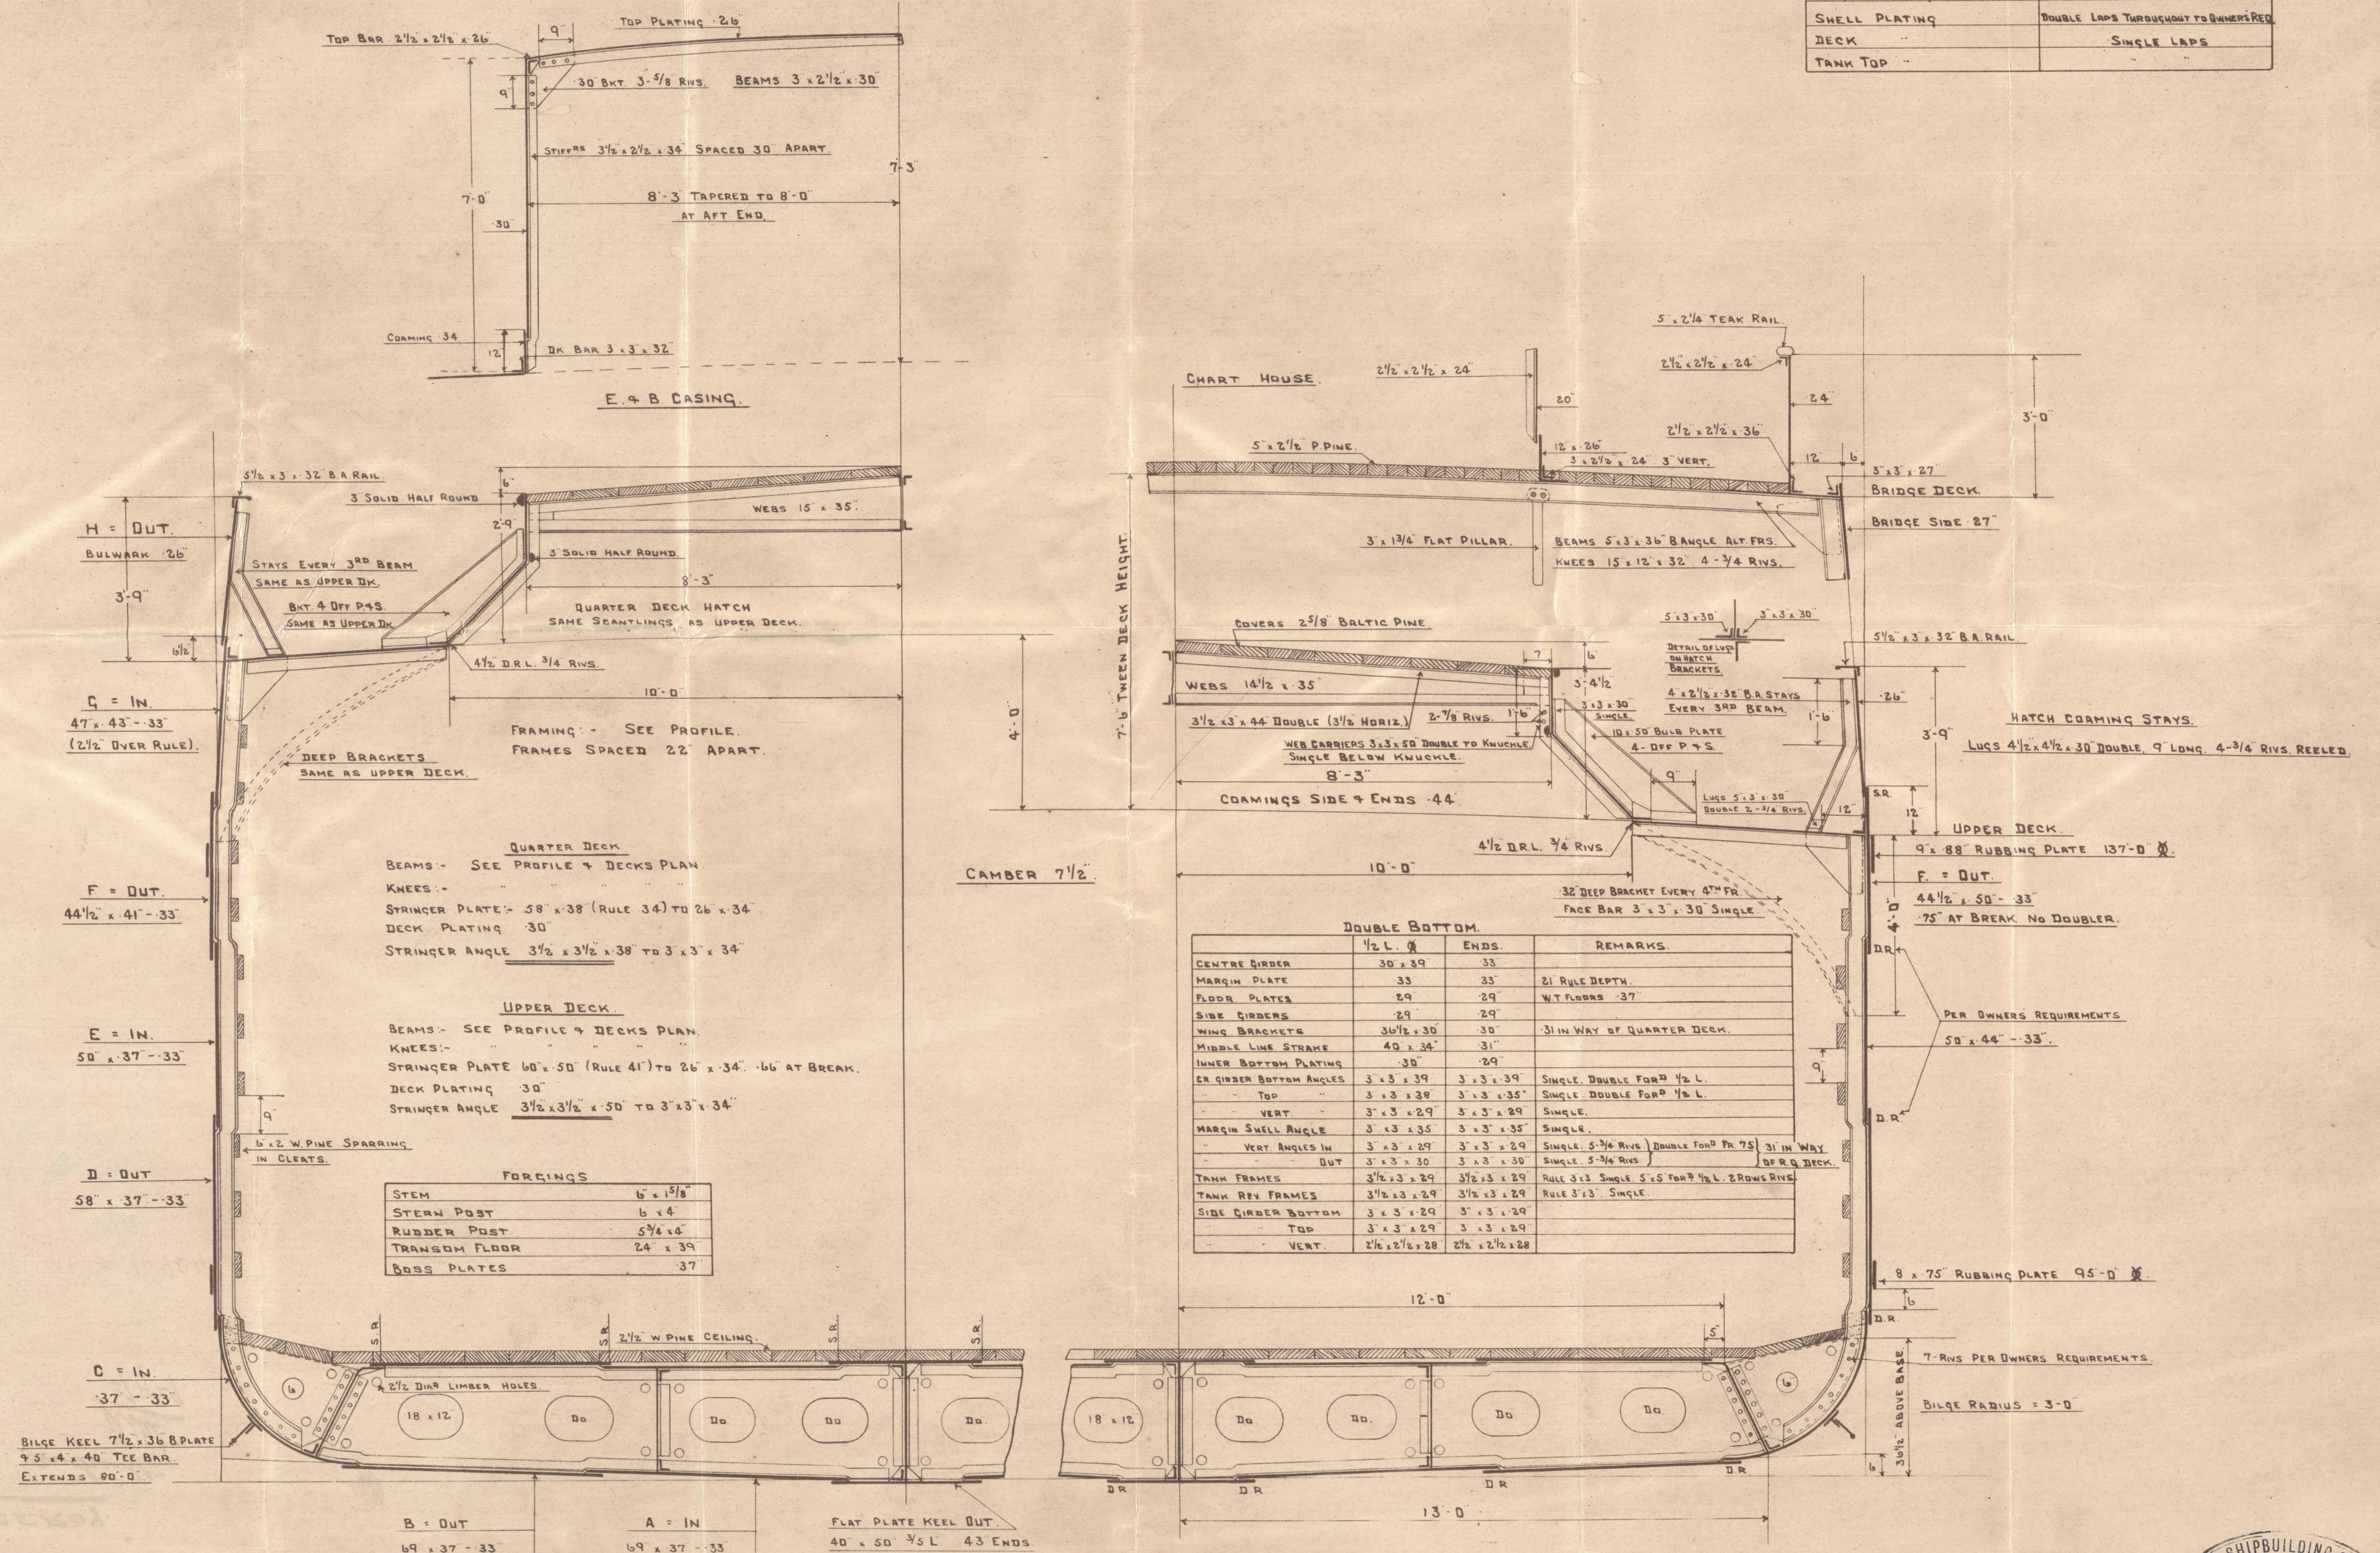

SECTION THRU OPEN FLOORS
IN BOILER ROOM.

SECTION THRU HOLD IN WAY OF QUARTER DECK

SECTION THRU HOLD IN WAY OF UPPER DECK

ALSA. S. B. Co

MIDSHIP SECTION

No. 407.

"THE VICEROY."

as built.

W. H. L.
5/4/29.

GLASGOW REPORT No. 49048.



© 2020

Lloyd's Register
Foundation

W991-0062