

MIDSHIP SECTION

of No 224

DIMENSIONS

LENGTH BETWEEN PERPENDICULARS	142
BREADTH EXTREME	28
DEPTH IN HOLD	14.5
TONNAGE	Under Deck 385
TONNAGE	gross 415
TONNAGE REGISTER	399

Class 100A1


Frames for steel wings

Number for equipment 7352

Main Hatch 14' 3" x 14' 3"

Plate 1/4"

Length of Raised Deck 32.5
Length of hull along deck 2.9

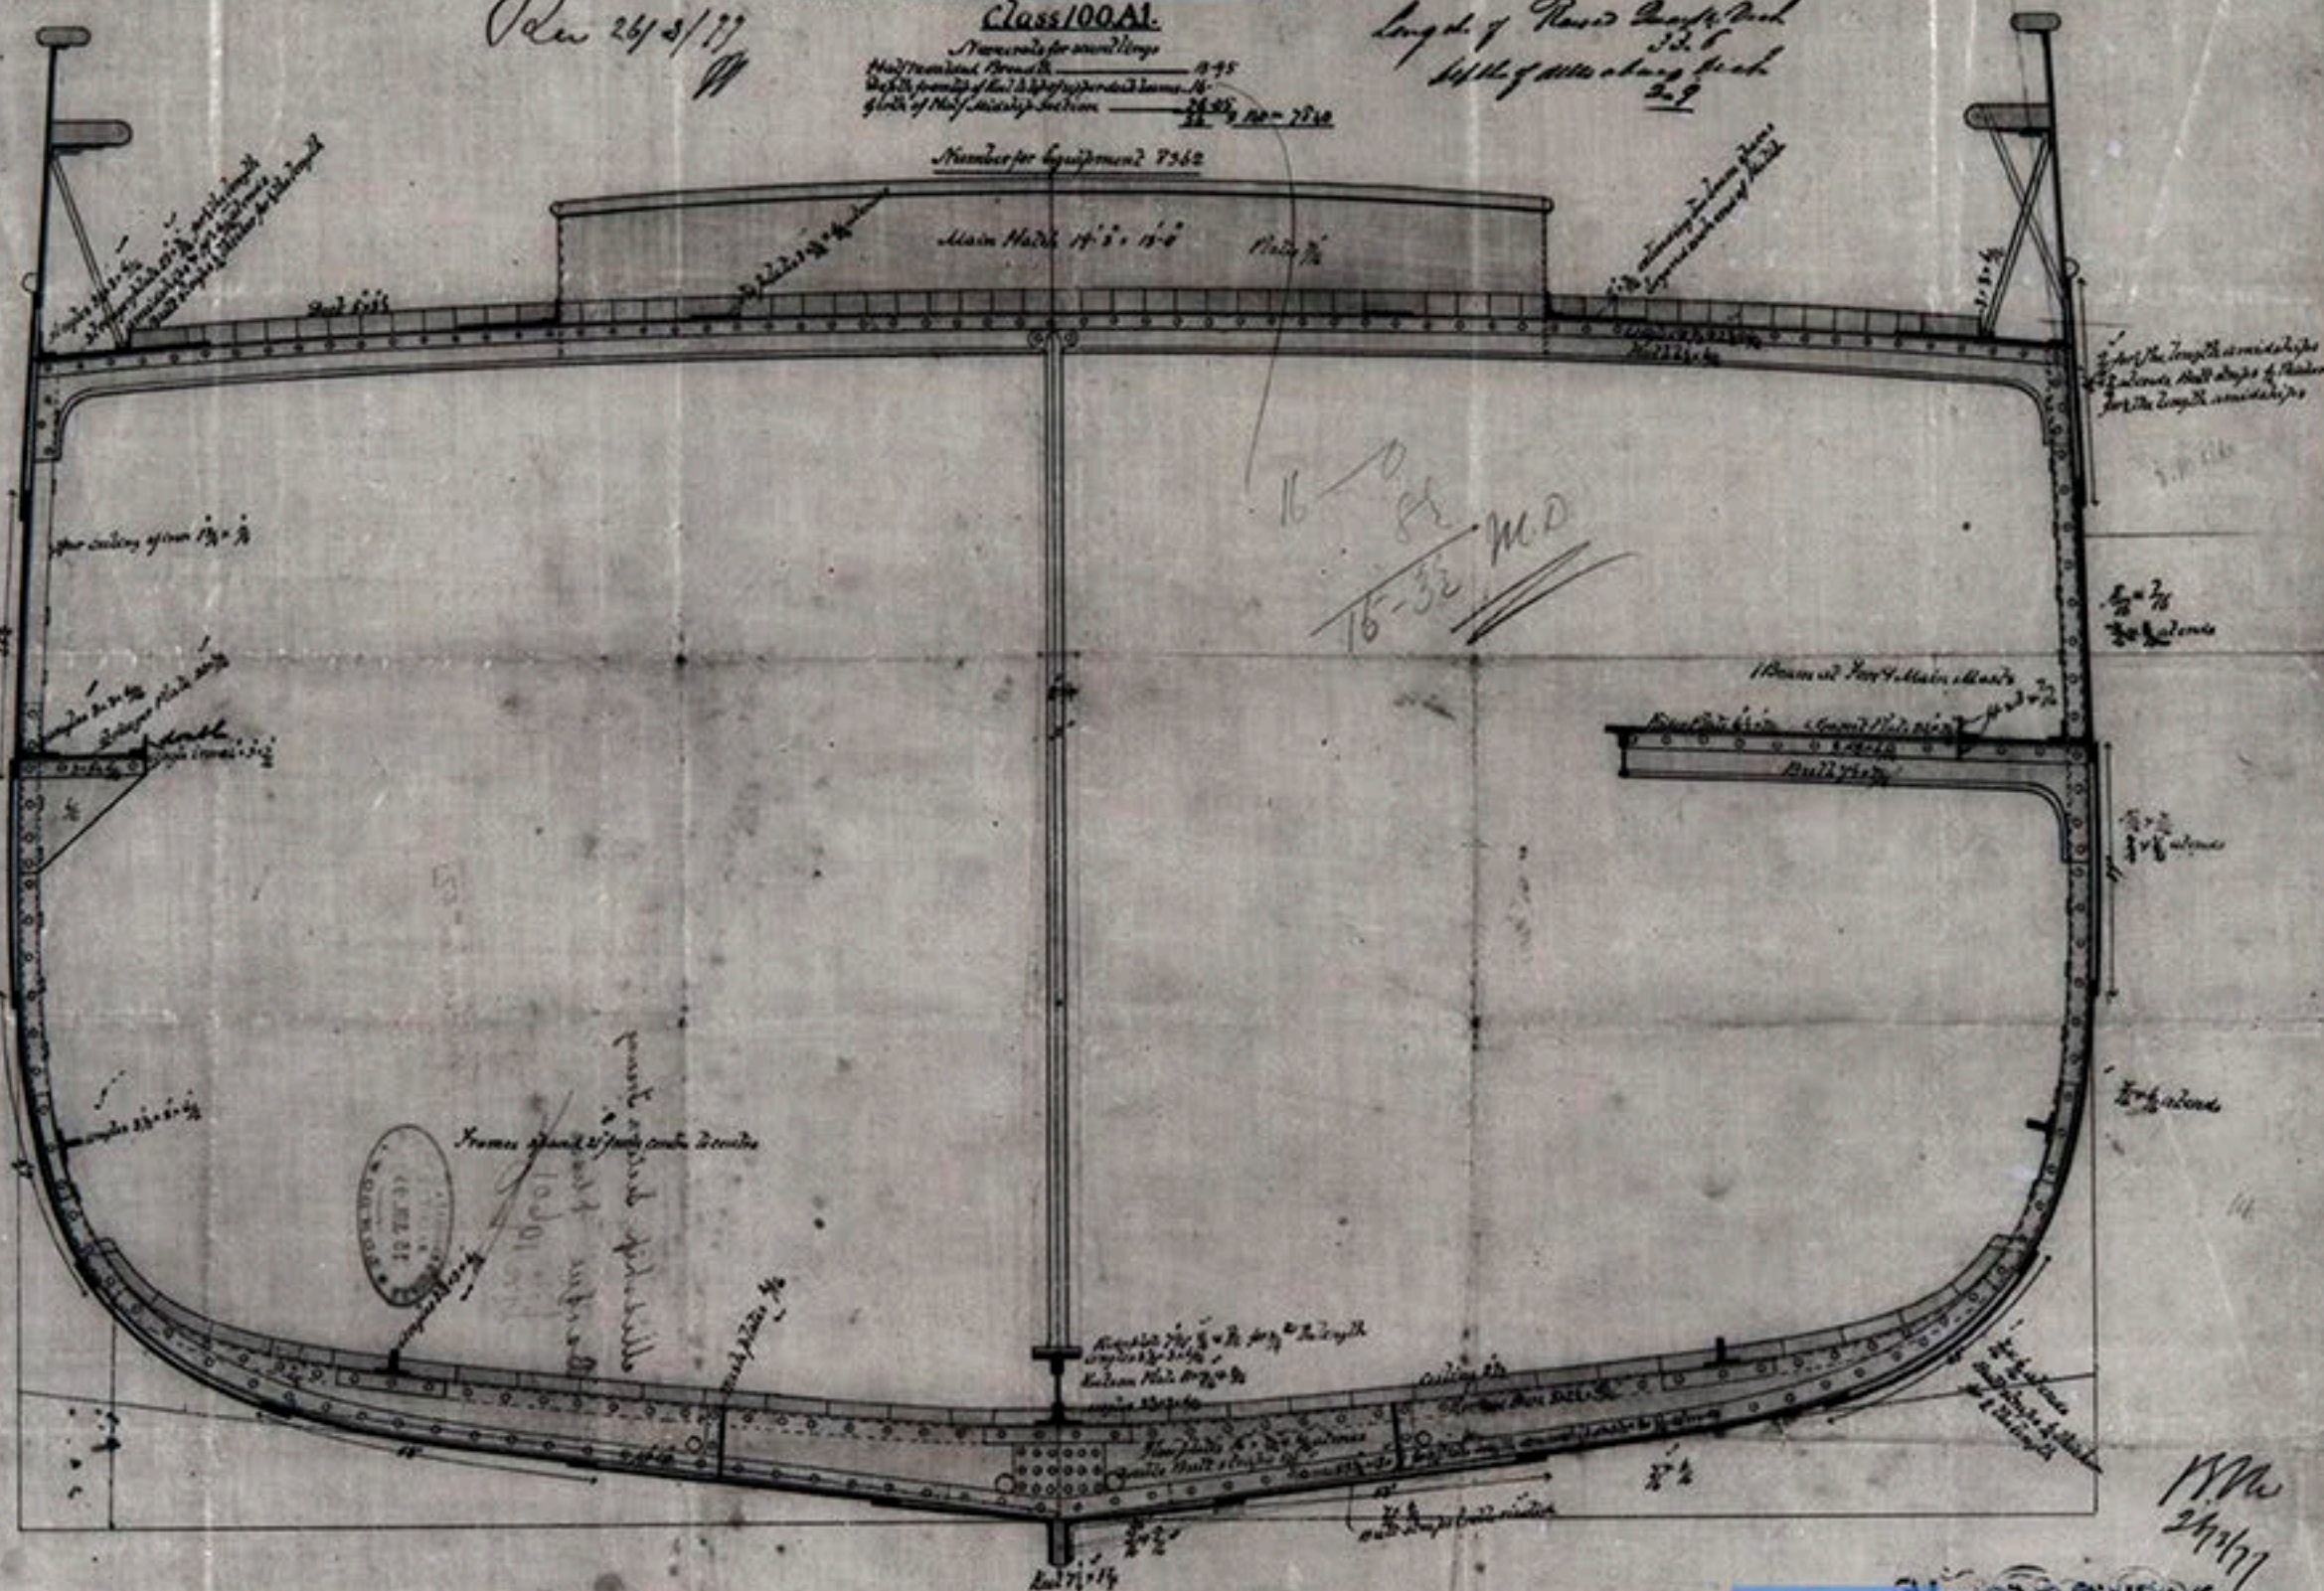

SCALE 1/4 INCH TO A FOOT



Alexander Hall & Co
 Shipbuilders

ABERDEEN 24/1/77

Lloyd's Register
 Foundation