

For the information of Surveyors and the Committee only.

Received at

7-SEP. 1925

Office

19

Lloyd's Register of Shipping.

(Report on Vessel No. _____)

Port

Hull

SHIP FORGINGS OR CASTINGS.

I have to report that the undermentioned Iron or Steel Forgings or Castings, manufactured by *M^{rs} Sunderland Forge & Eng^g Co. L^{td}* of *Sunderland* for the Vessel No. _____, being built by *S.S. Lizzie & Annie* of _____ have been inspected by me as set forth below and found to be, so far as can be seen, *Sound*

Forgings or Castings.

Lloyd's

No. 4018



4-9-25

D. D. Williamson

Sunderland 4-9-25

| | STERN FRAME. | RUDDER FRAME. | STEM. |
|--------------------|------------------------------|---------------------------------|-------|
| ... | <i>Scrap Iron</i> | <i>Scrap Iron</i> | |
| ... | <i>Forged</i> | <i>Forged</i> | |
| ... | <i>5 1/2" x 2 1/2"</i> | <i>3 1/2" dia to 2 7/8" dia</i> | |
| on Inspection ... | <i>Forged & Finished</i> | <i>Forged & Finished</i> | |
| Inspected | <i>1-9-25 to 3-9-25</i> | <i>2-9-25 to 4-9-25</i> | |
| STINGS. | | | |
| Standard Test | <i>Old Bone Used</i> | | |
| pieces. | | | |
| st- | | | |
| quare inch | | | |
| per cent. ... | | | |
| ng Test- | | | |
| re fracture | | | |
| on ground ... | | | |
| Test- | | | |
| ording to Rules | | | |
| d satisfactory ... | | | |

SKETCHES OF FRAMES SHOWING POSITION AND DESCRIPTION OF WELDS OF FORGINGS.

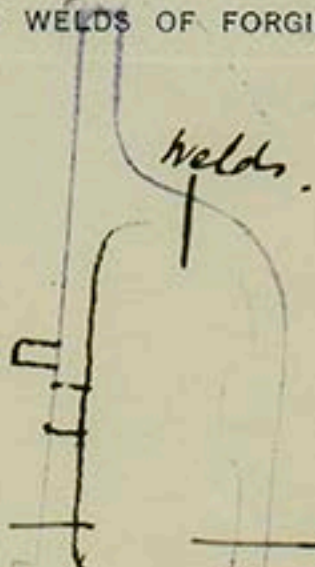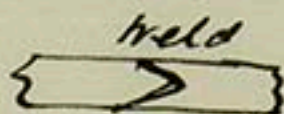

any chargeable) £ 4 : 4 : 0 Applied for
be paid at *Sunderland*

, state whether scrap or puddled iron. If of Steel, state whether made on the Open Hearth process

if annealed



© 2018

Lloyd's Register
Foundation