


MESSRS A & E. WOODWARD
HULL.

SKETCH NO 67A.H.7
SEPT. 21ST 1932

M.S. AIR RECEIVER

16 DEC 1932

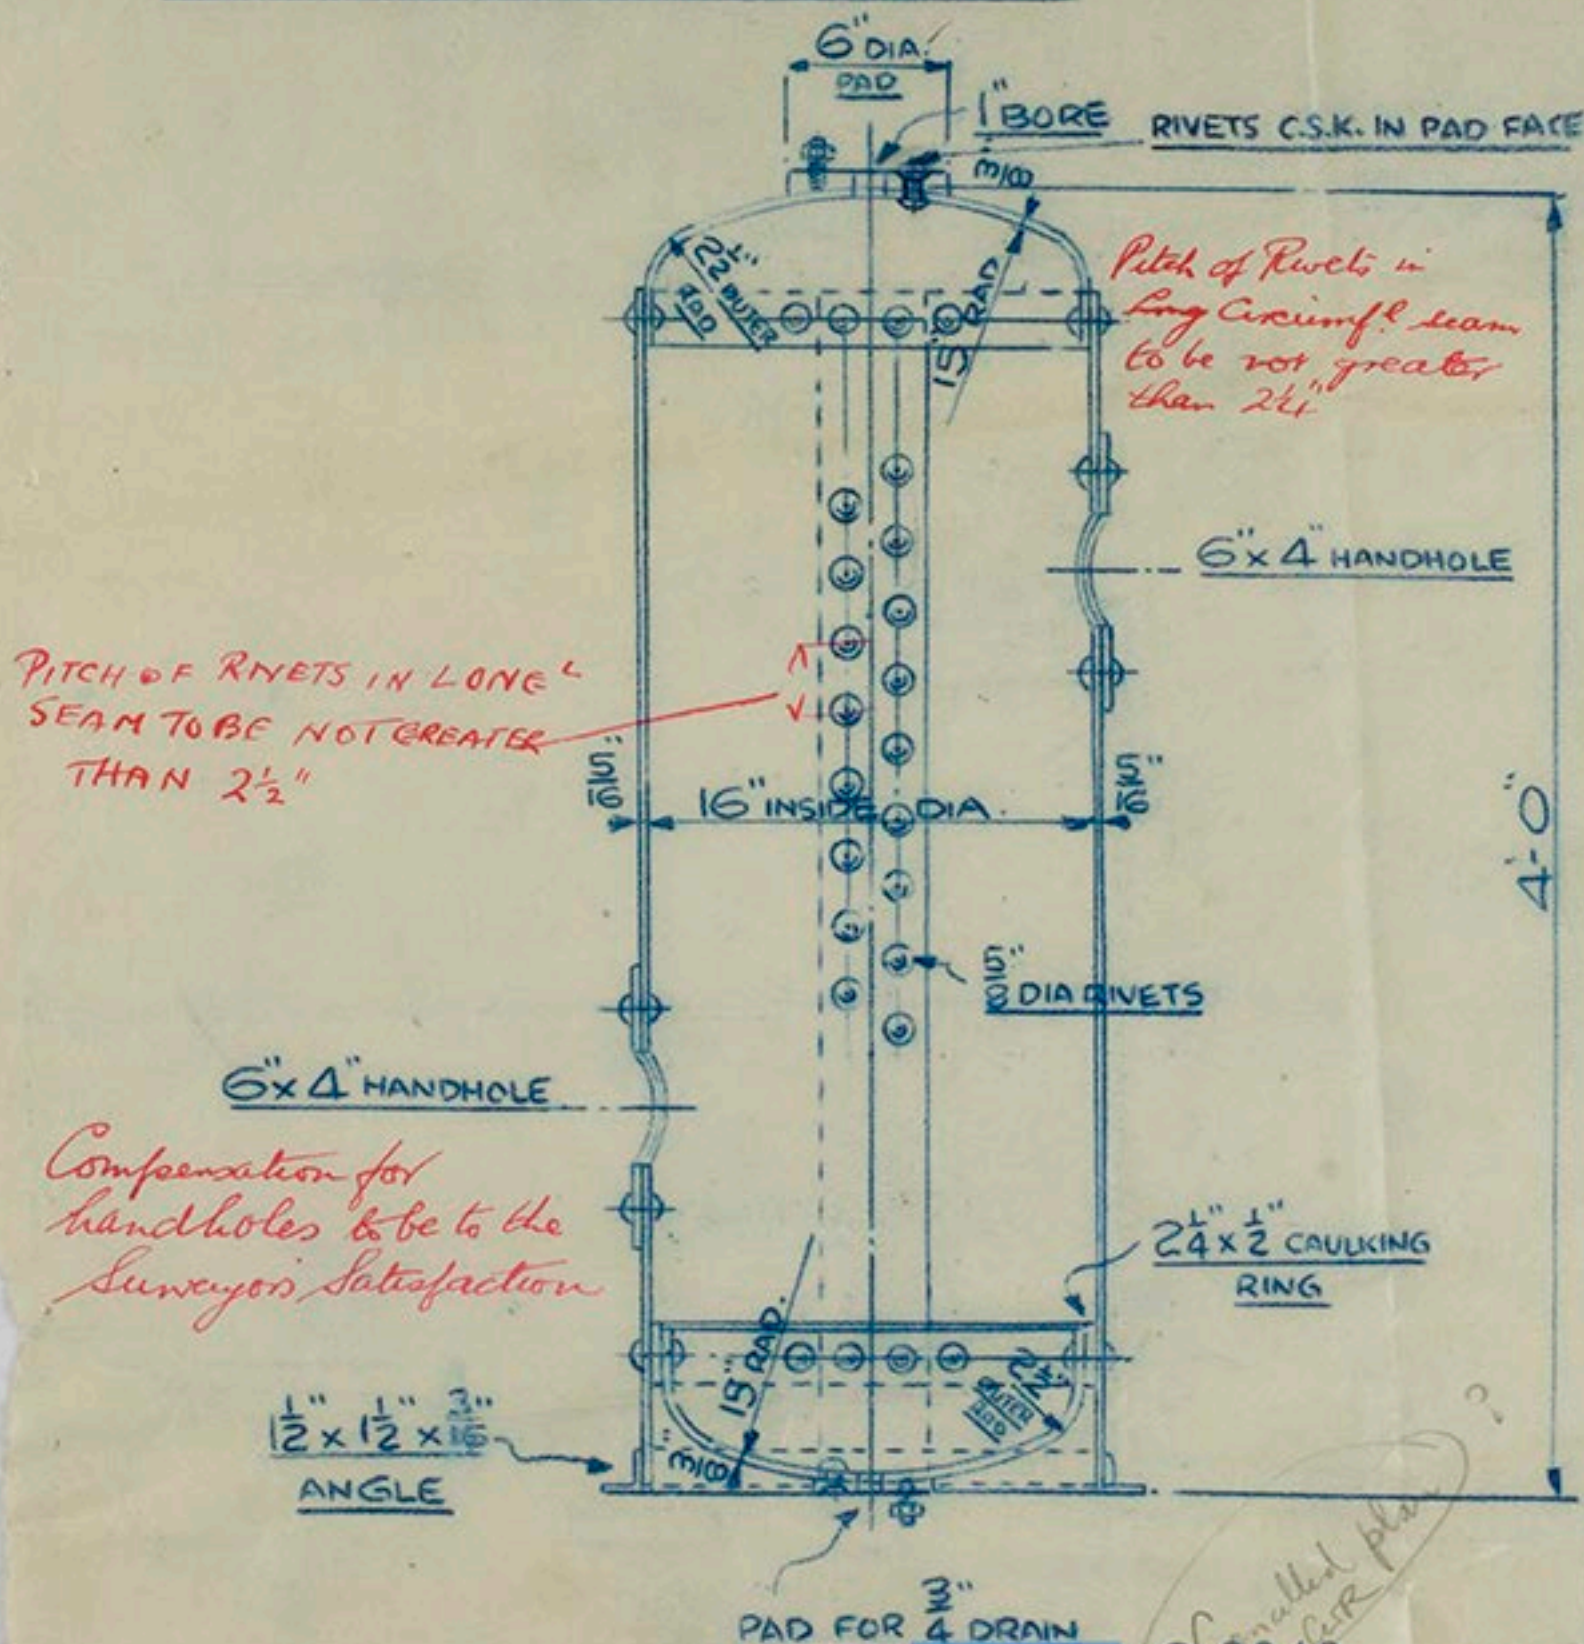

260 LBS. / 0" W.P.
440 LBS / 0" TEST P.
TO PASS LLOYD'S SURVEY

© 2018

DAVY BROS LTD

Lloyd's Register
Foundation
SHEFFIELD