


27.9.32
MESSRS A & E. WOODWARD
HULL.

SKETCH NO 67A.H.
SEPT. 21ST 1932

M.S. AIR RECEIVER

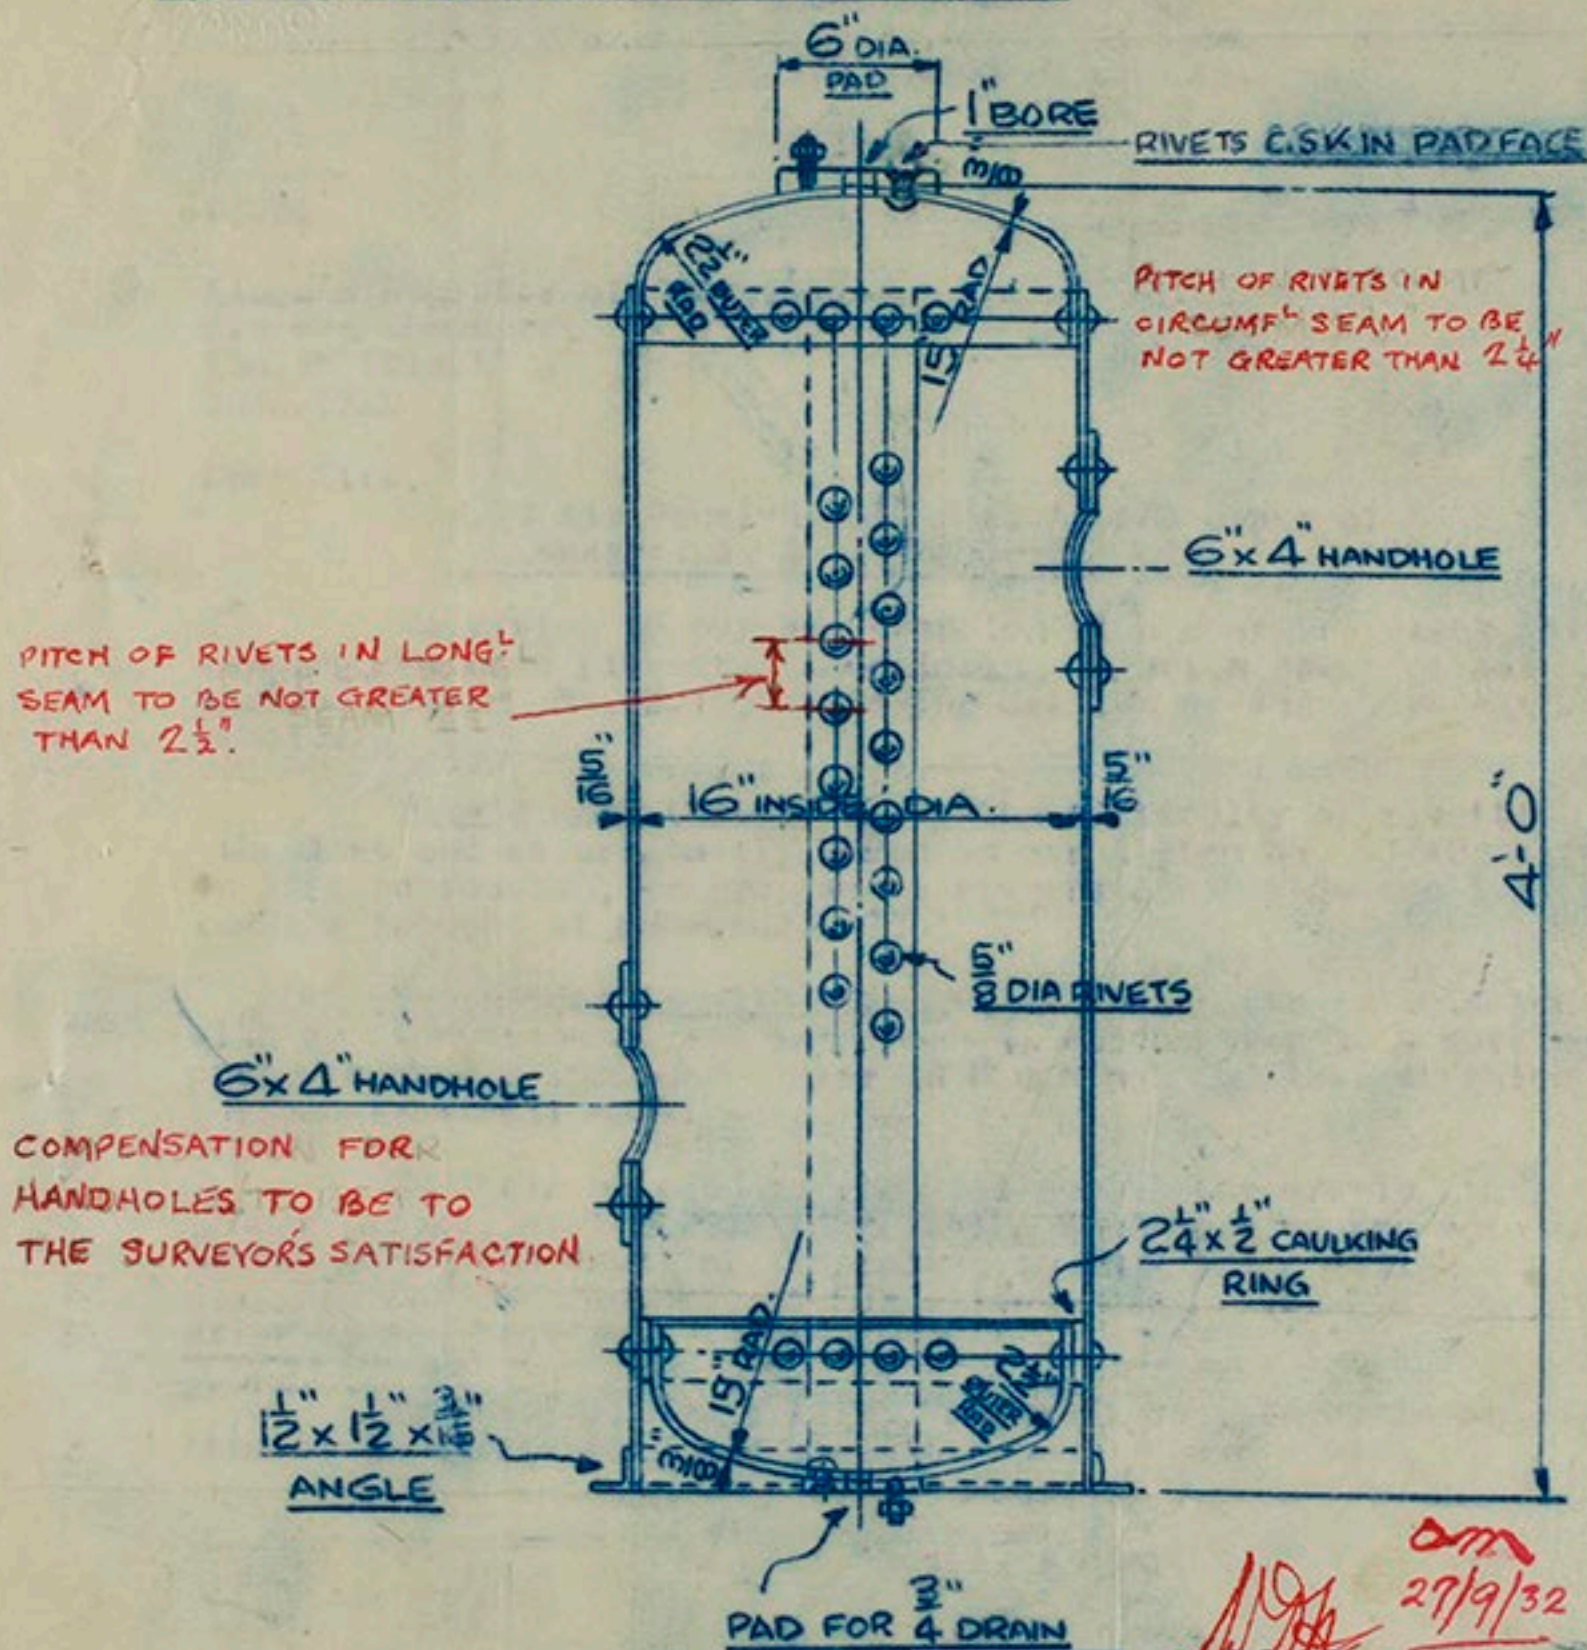

260 LBS. / 0" W.P.
440 LBS. / 0" TEST P.
TO PASS LLOYD'S SURVEY

27/9/32
DAVY BROS LTD
PARK IRON WORKS
SHEFFIELD
Lloyd's Register
Foundation

ENCLOSURE
NO 563