

"Lizzie & Annie" Report No 13655.

MIDSHIP SECTION.

Scale $\frac{1}{2}$ of an inch to a foot.

11.8 12.4

Rev 20/2/77

21/2/77

Half beam 9.6

Depth 16.3

Depth 9.0


Sum $\frac{34.9}{2} \times 89 =$

Sum

3092.15

Length as per rule 89 feet

To class 90 ft.

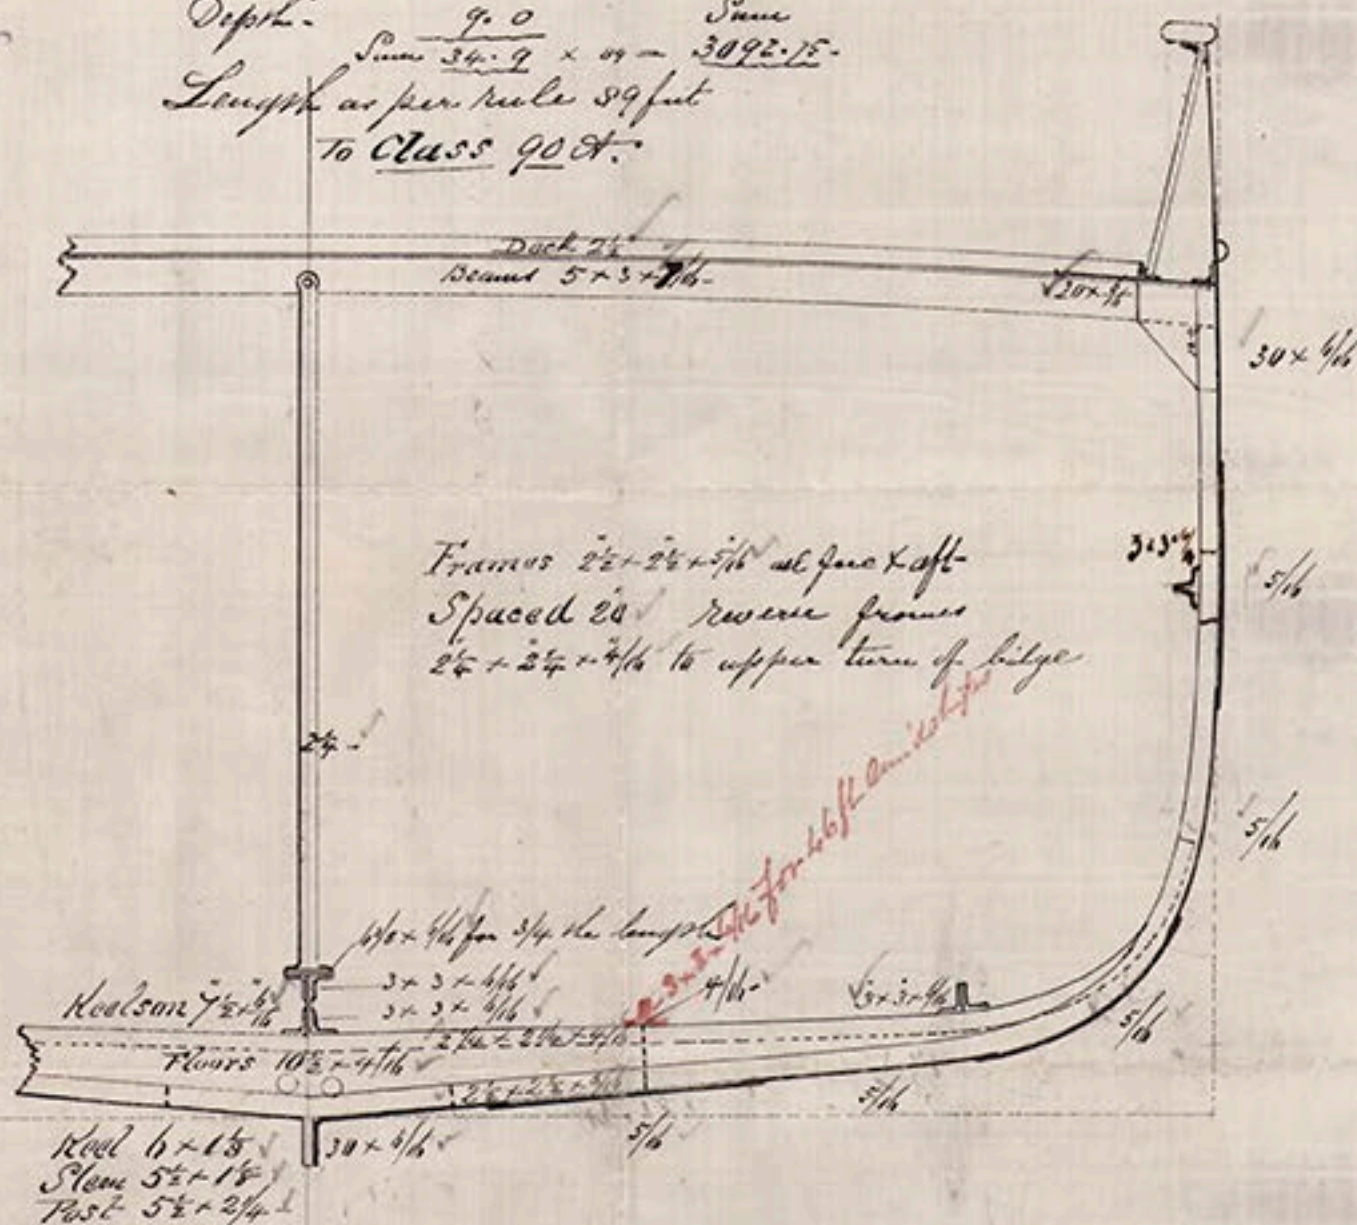

John Lloyd's Sons
North Shields

© 2018
Lloyd's Register
Foundation