

21/2/77


"Loggie & Annie" - Report 20 13655.

No. 1214 vessel

John Softley & Sons

Dimensions 70 x 19 x 9.0

Plan 20/7/77

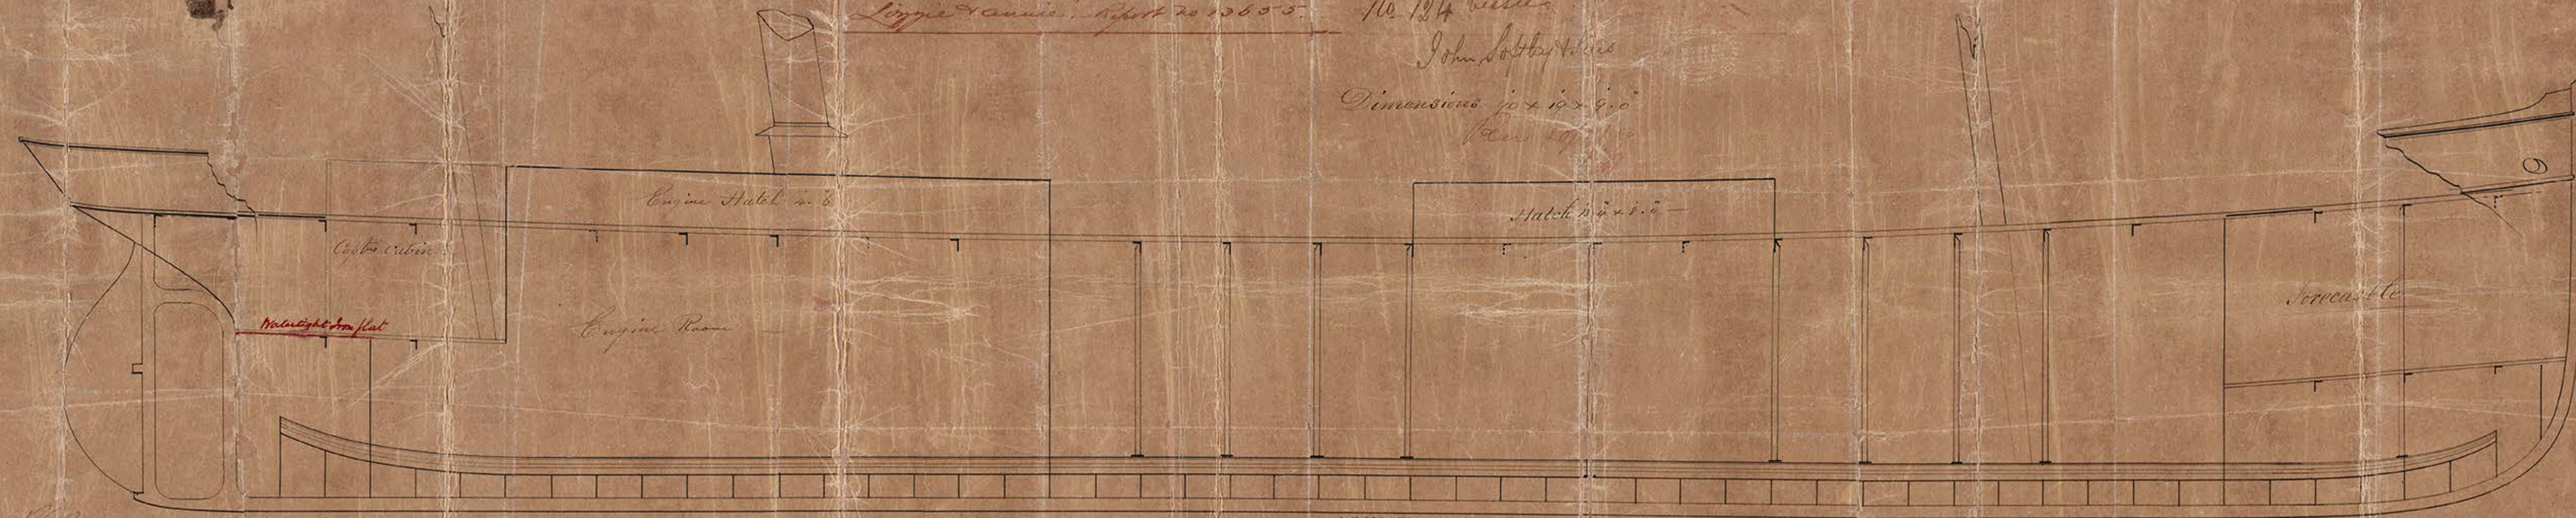

1872
20/7/77

LONGITUDINAL SECTION

Scale 3/8" of an inch to a foot



© 2018
Lloyd's Register
Foundation

Lizzie + Annie



© 2018

Lloyd's Register
Foundation

1-22