Barrow Report No. 3466.

Copy of Midship Section
approved 11. 12. 79

Scantlings marked in red are subsequent alterations on account of increased length

No 77

Scale ½ inch = 1 foot

Dimensions

Length between p. p.	546'-0"
Breadth Moulded	52'-0
Depth of Hold from tops of floors	37'-0

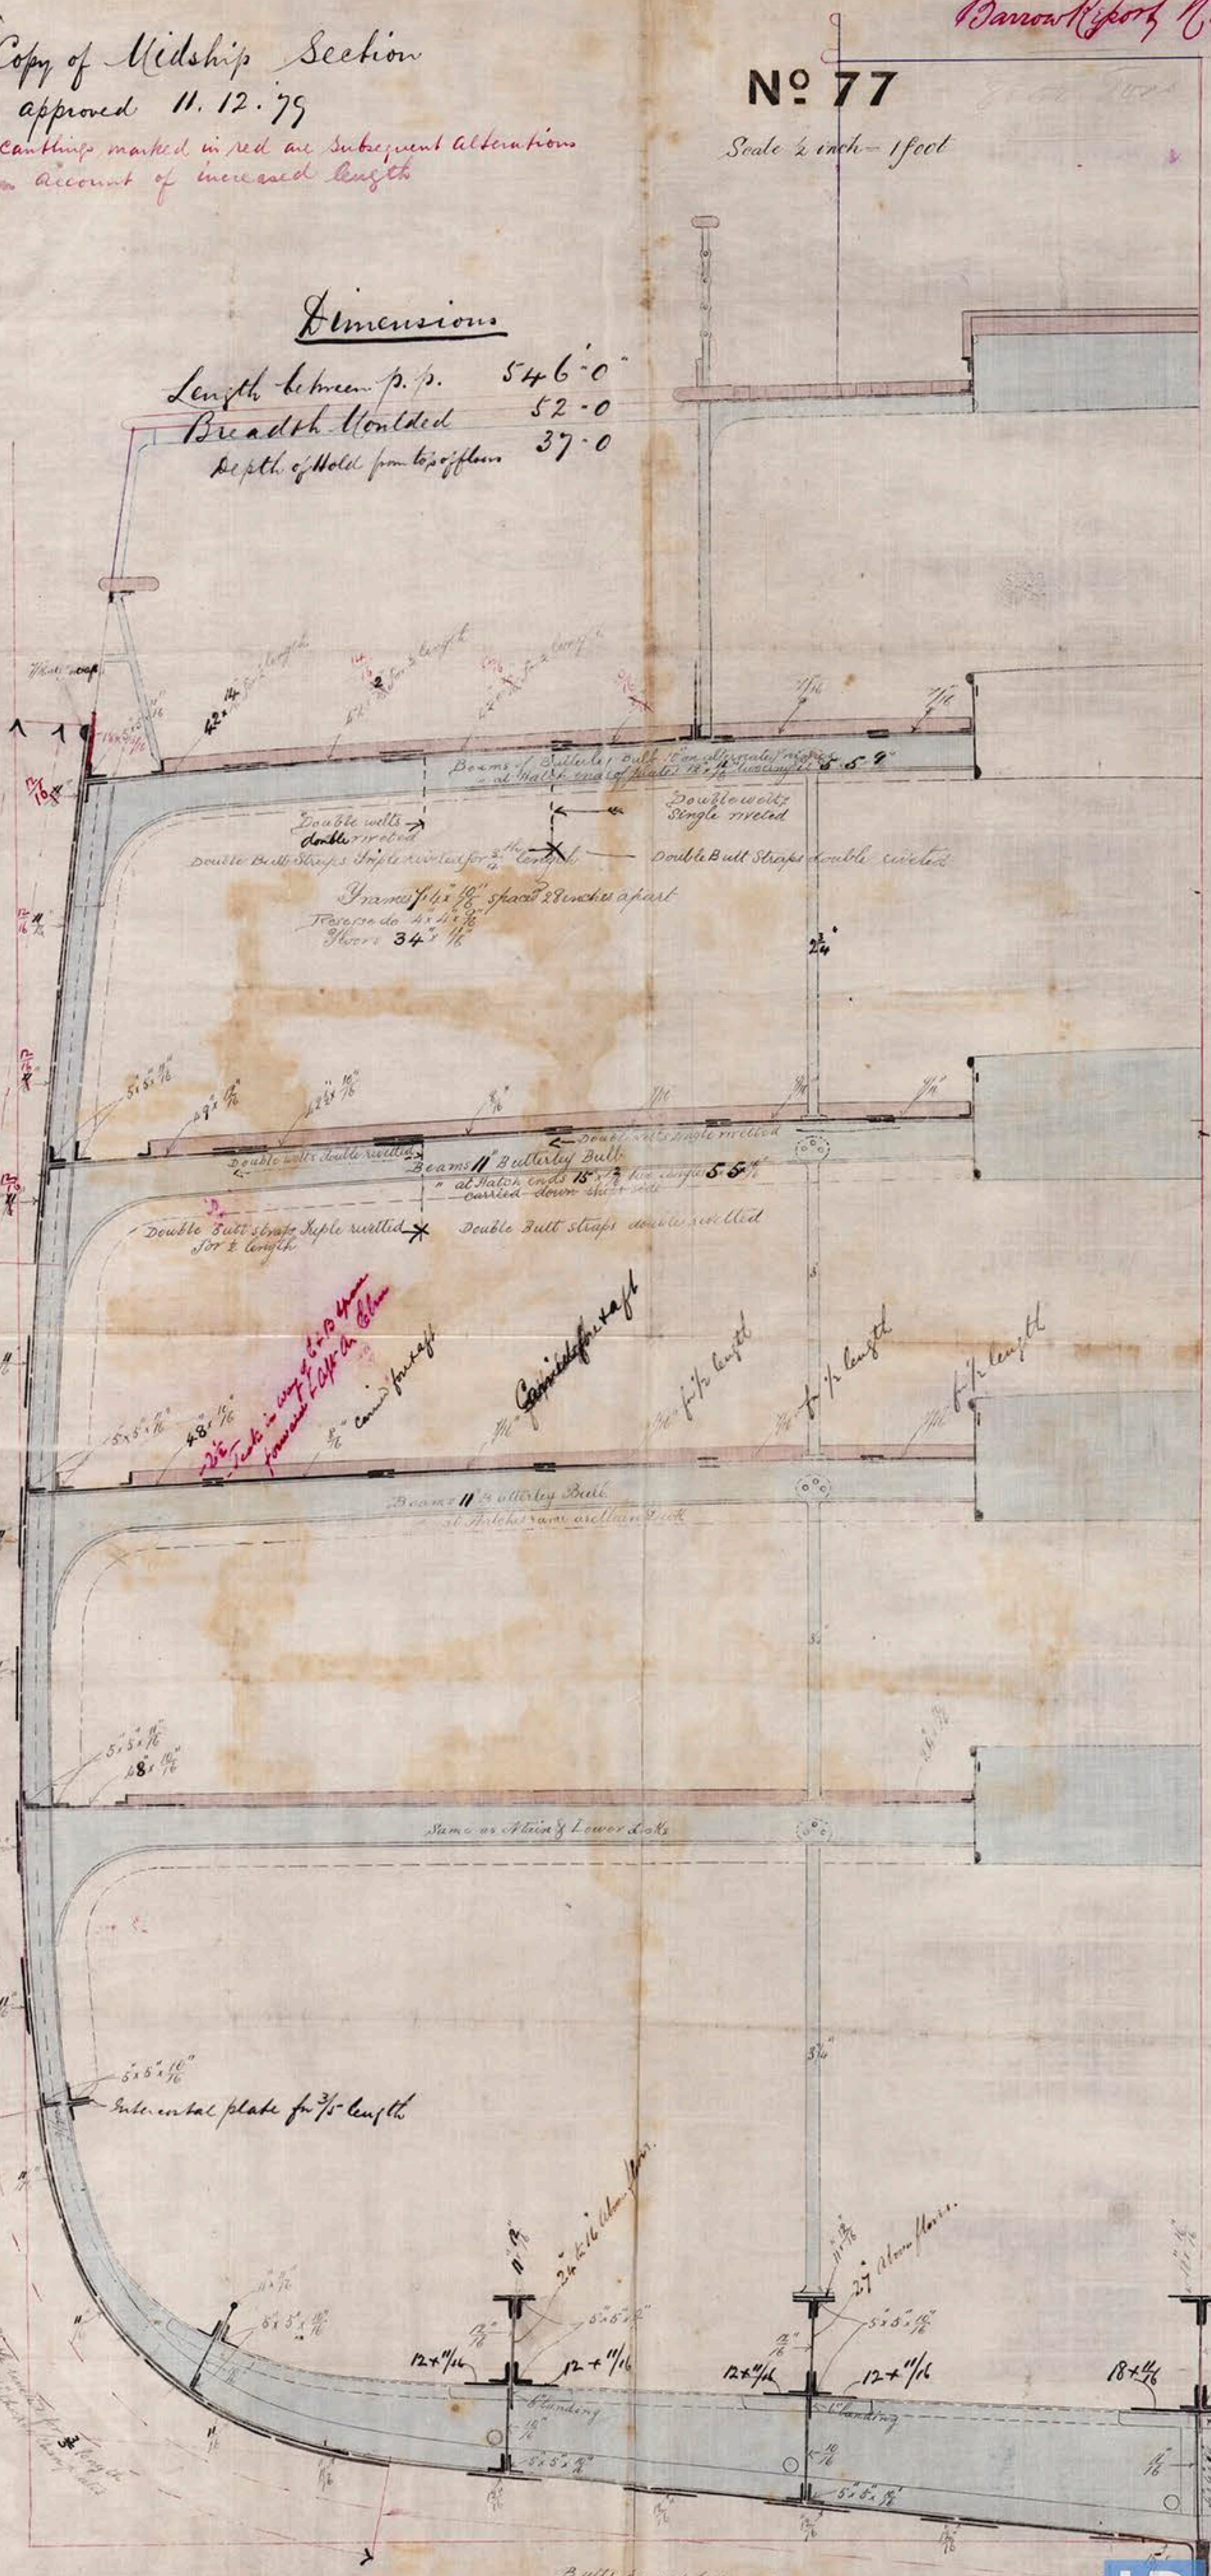

© 2018
Lloyd's Register Foundation