


See Ltr: 12/2/86.

17.2.86.
15.3.86
26.3.86.
18/5/86
13.7.86

18M
17/2/86

L. Bakin W. H. Report No. 611.5

Profile of Oil Boat
No 314 SS.

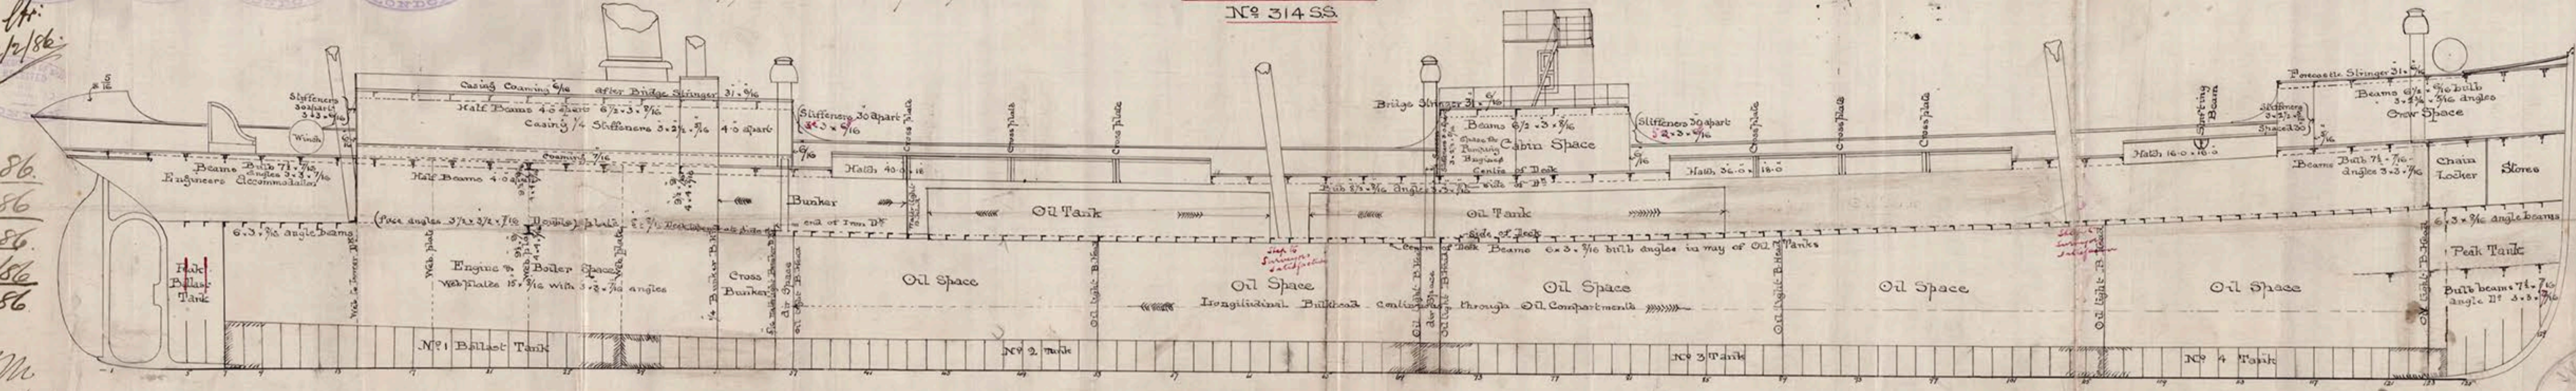

Scale 1/8 Inch = one ft

Note. The Oil B.H.s will have vertical stiffeners only, all on one side. B.H.s on frames 53, 89, 106 + 123 to have a 7 1/2 x 7/16 bulb on each stiffener. B.H.s 36 + 37, and 70 + 71 to be stayed to each other by stay plates attached to the stiffeners at intervals in lieu of bulbs to surveyors satisfaction.

W. GRAY & Co.
IRON & STEEL CO.
SHIPBUILDERS
LONDON