


"S.S. Bakuin" Cardiff Regd No: 2984.

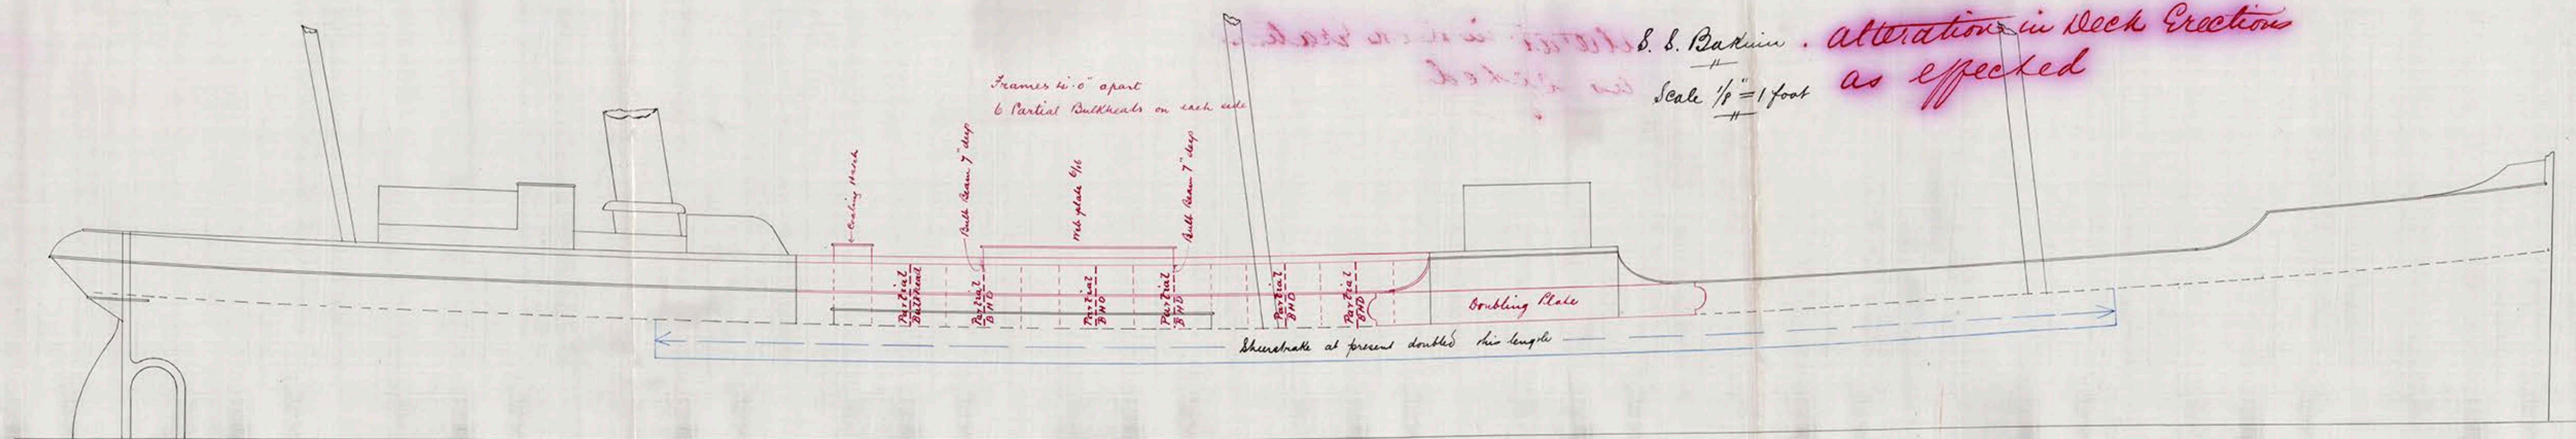

S. S. Barkin . alteration in Deck Erection
as effected

