


1800
 1801
Dimensions & Thicknesses of Steel Lower Masts.


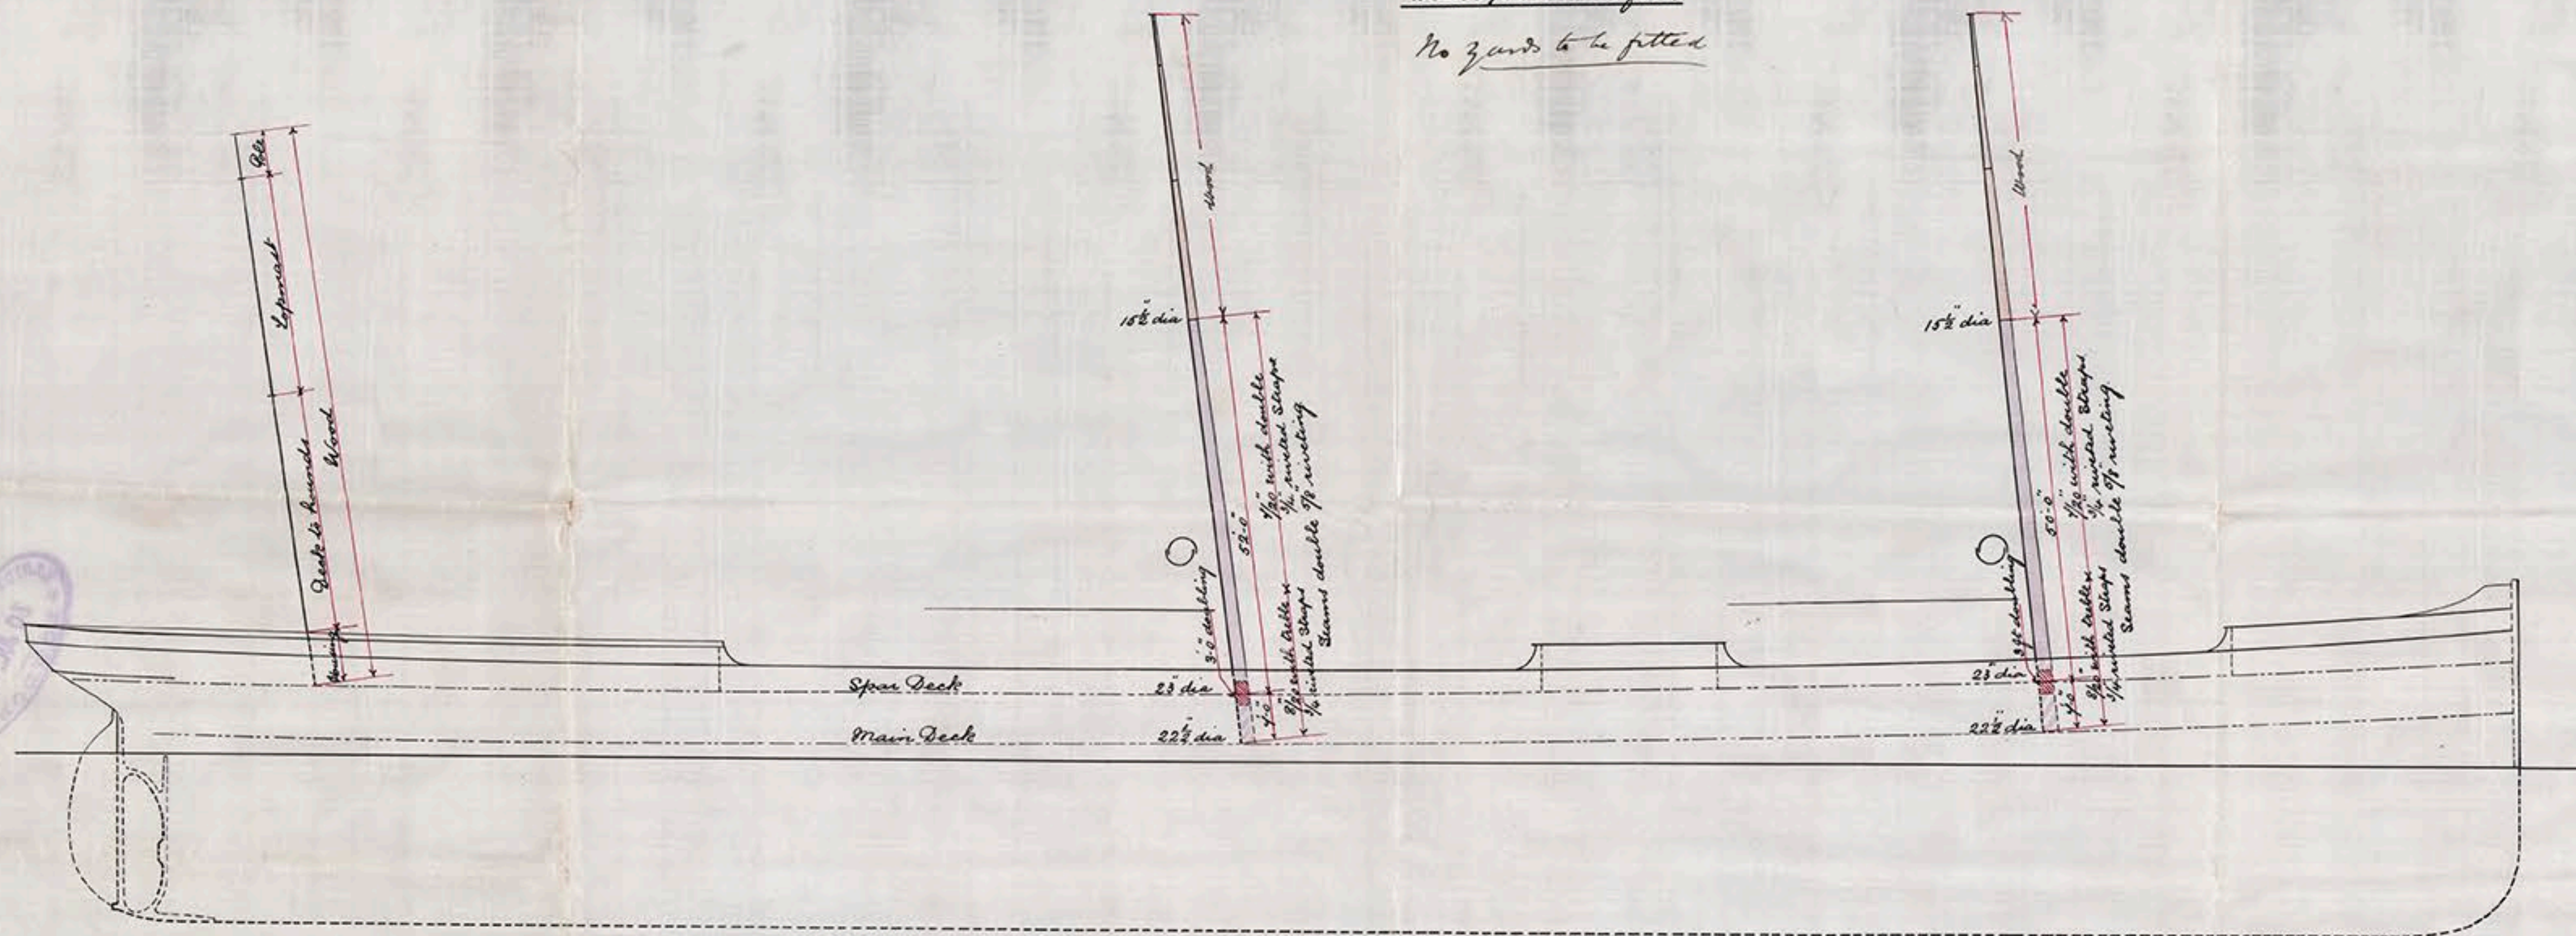


NEWCASTLE-UPON-TYNE

NO 7422 DATE 27.7.98

WALKER SHAW
Lloyd's Register
Foundation

SP. 8. 3

Mr W. G. Armstrong Mitchell
& Co 577 Marsh
"Baku Standard"
Kive Report 28302

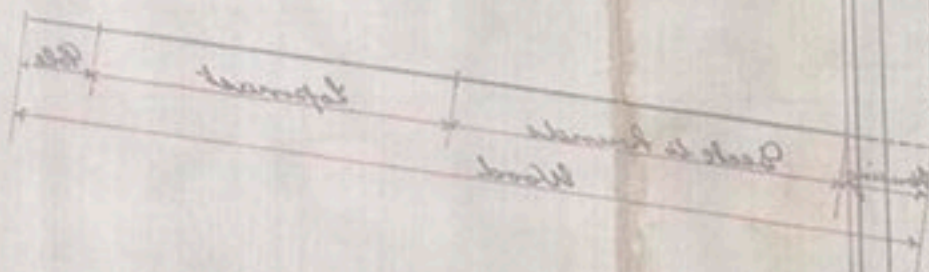

© 2018

Lloyd's Register
Foundation