

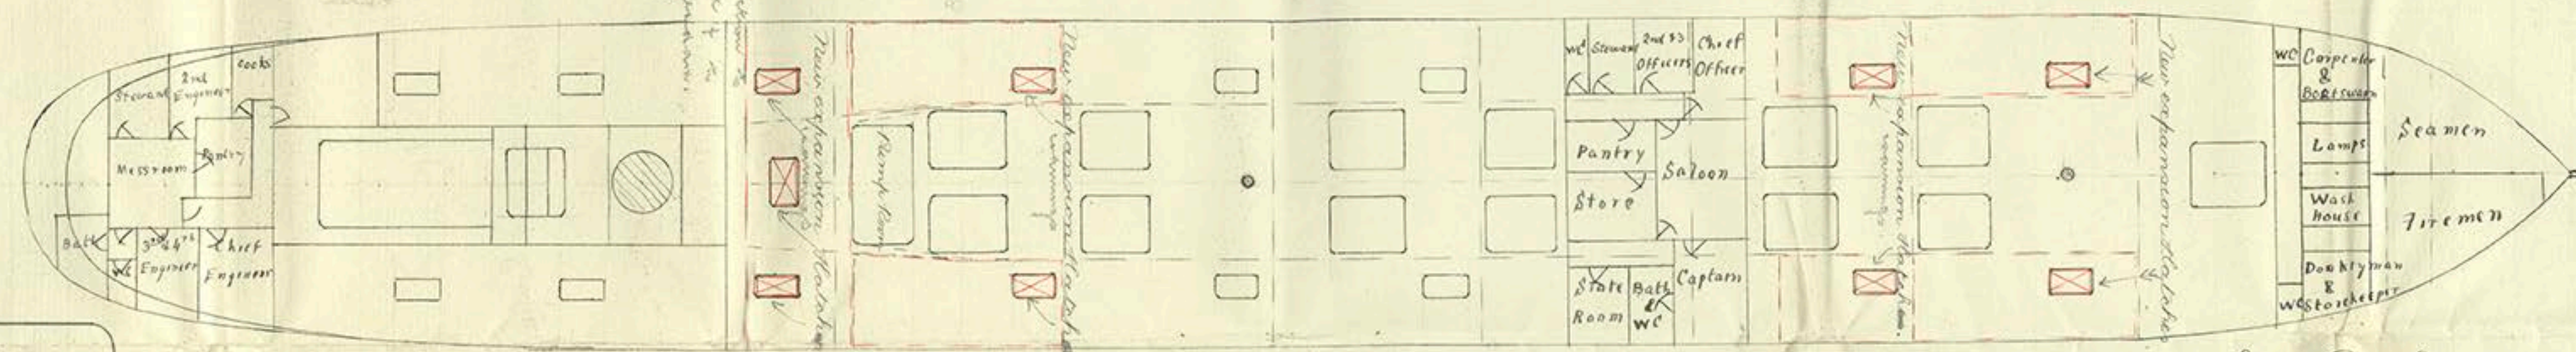



16.6.13.

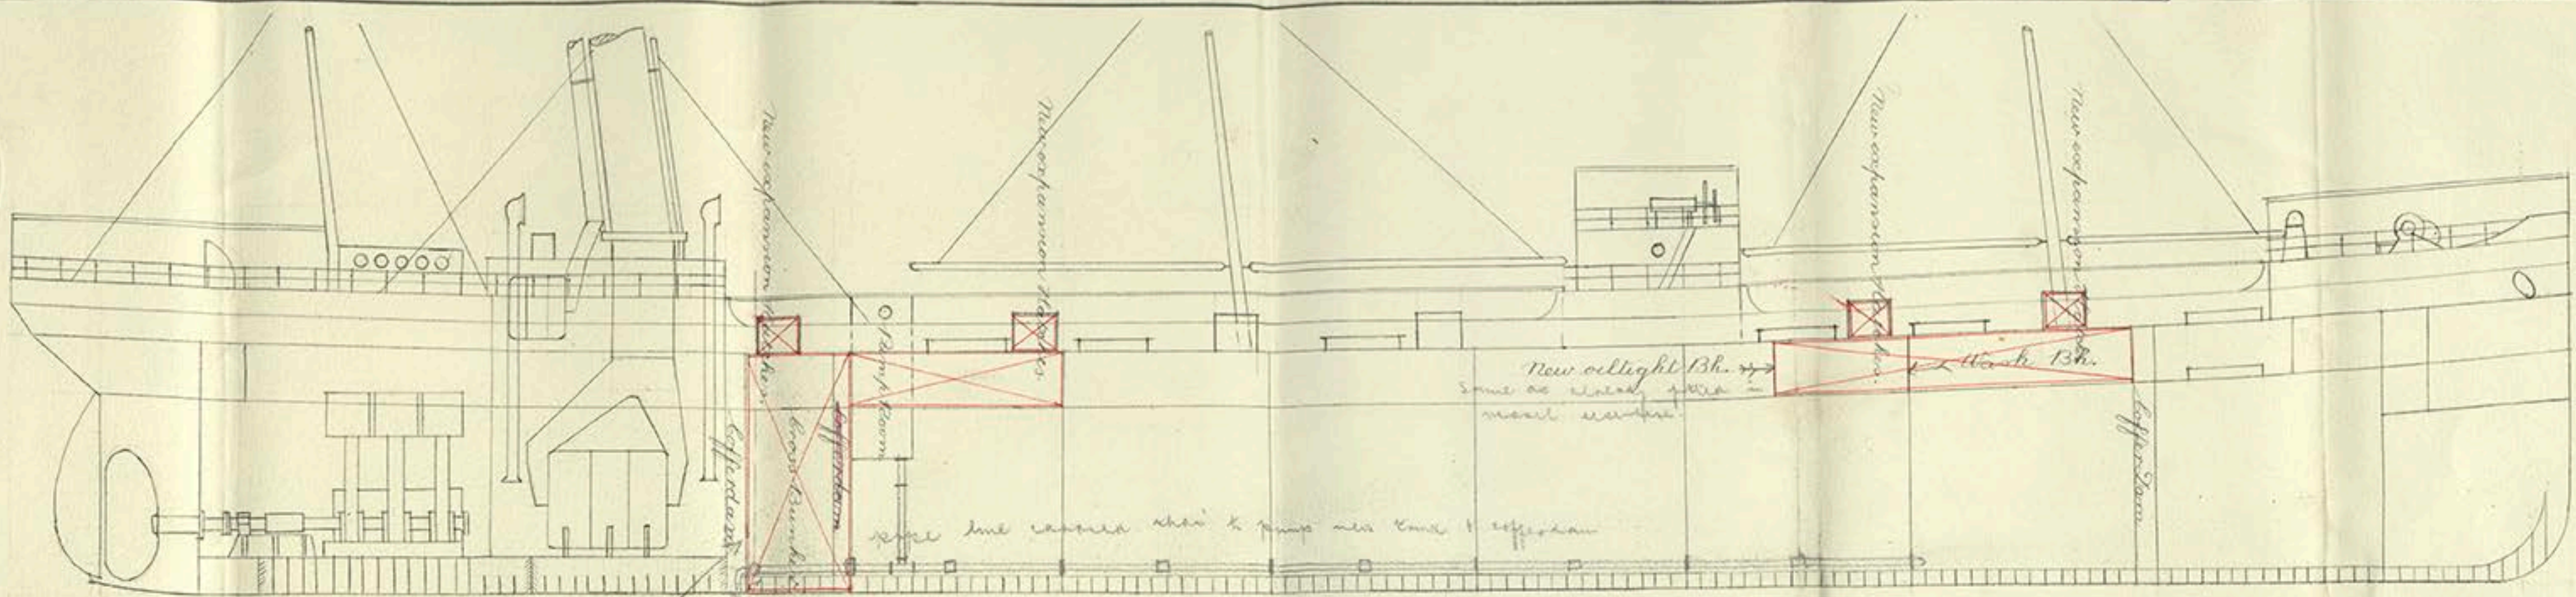

Spar Deck

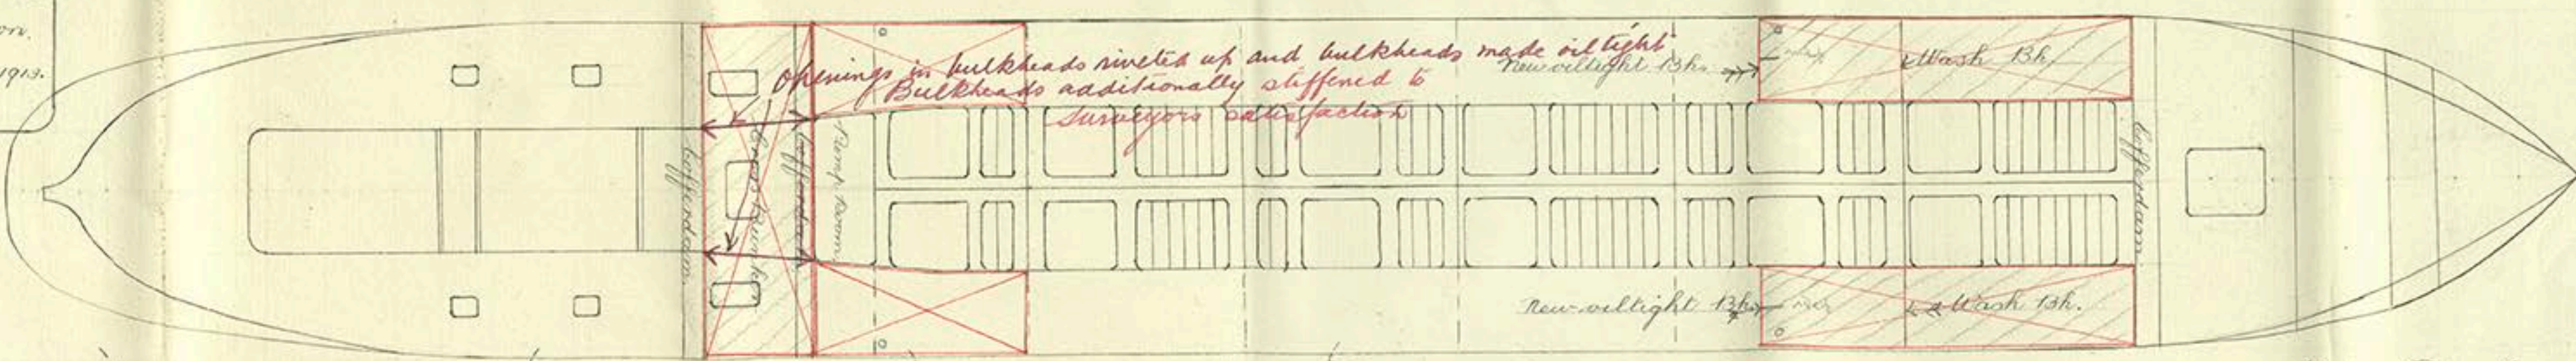


Main Deck

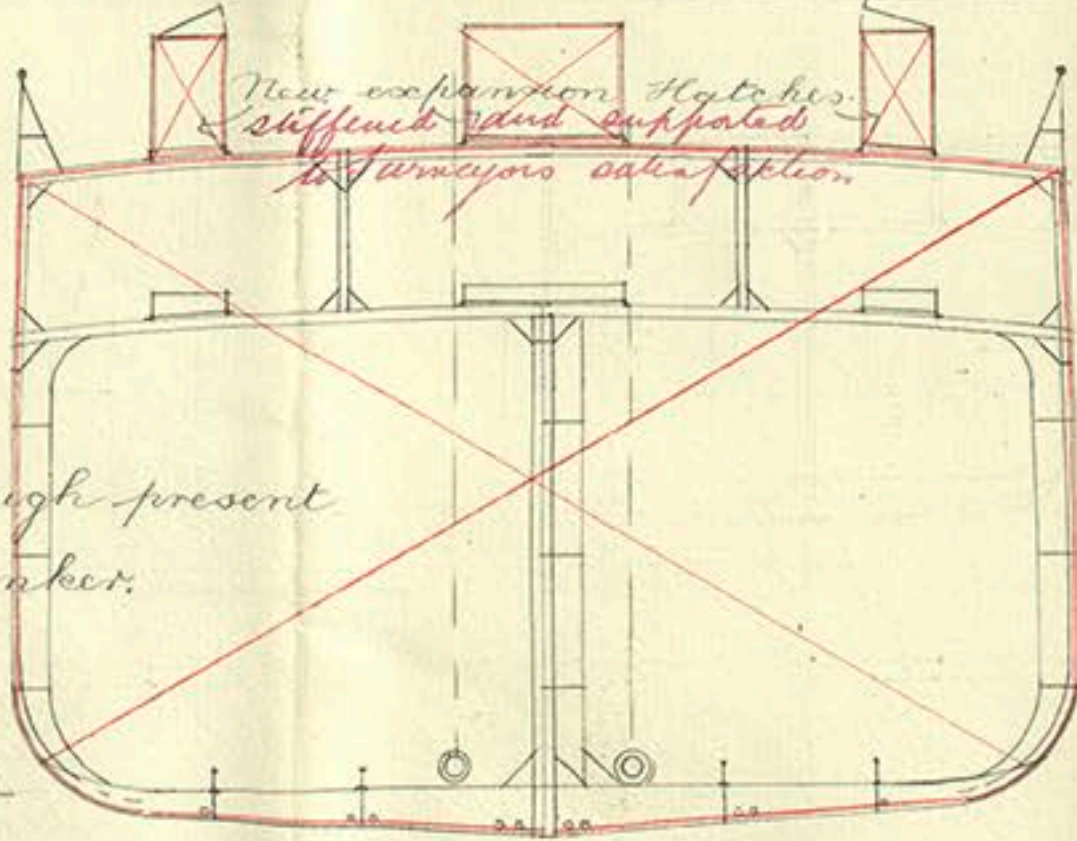

Section through present cross Bunker.

Scale 1" = 7ft.

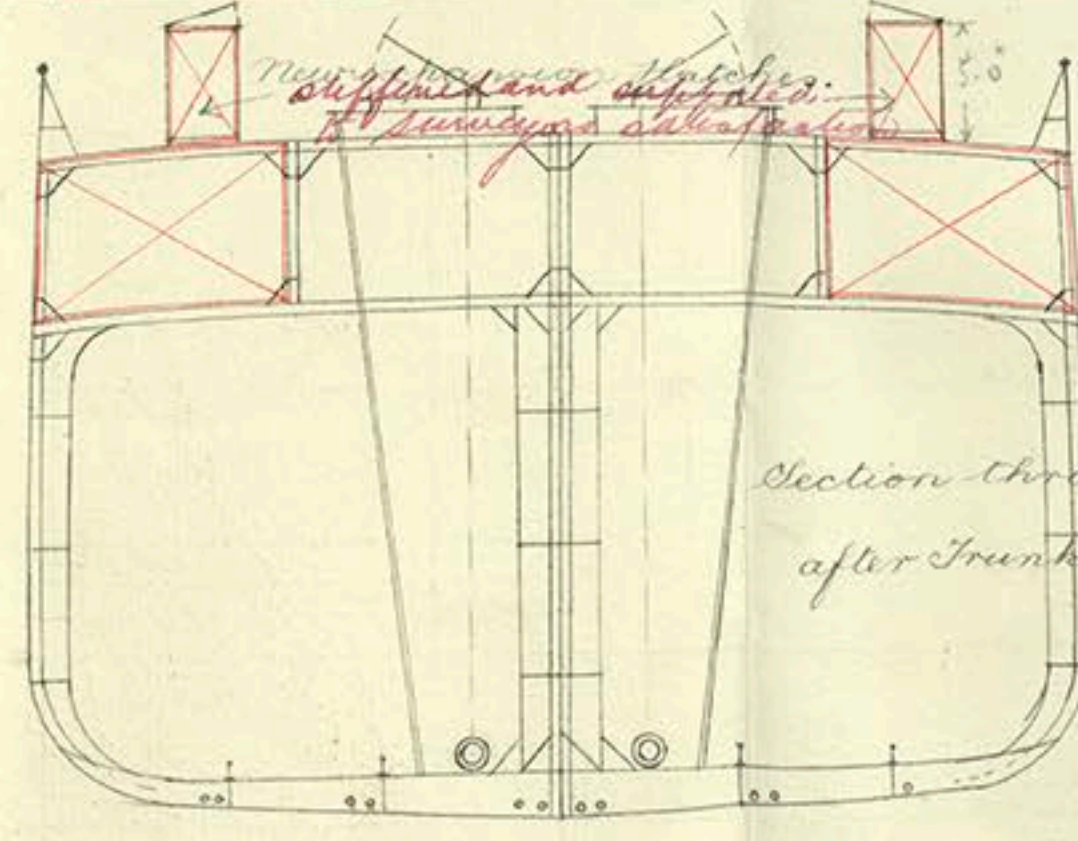

Section through 2nd and after Trunk Spaces.

9.9.13

C.F.
16.6.13.

S.S. Baku Standard

Converted cross Bunker and Trunk Spaces shown in Red.

Sketch showing converting arrangements

Scale 1/2" = 1ft.