

S. 97 180.

Numbers:  $\frac{G}{2} = 45,20$ .  $\frac{B}{2} = 23,0$ .  $D = 28,75$ .

$$\frac{B+G}{2} + D = 96.95 = 1^{st} \text{ Number}$$

$$96.95 \times 313 = 30345, 2^{nd}.$$


$$\frac{L}{D} = 10,89 \quad \frac{L}{B} = 6-7$$

class. ✠ 100 A I Engl. Sloyd.

Scale 1:25.

Liverpool plate  $5\frac{1}{2}$   
 Prop & ~~Support~~ High plates  $15 \cdot \frac{1}{2}$   
 Bridge Keel deck  $5 \frac{1}{2}$

Skinnerplate <sup>36</sup>  $33\frac{1}{2} \cdot \frac{9}{10} - 30 \cdot \frac{9}{10}$   
 $3\frac{1}{2} \cdot \frac{9}{10} \cdot \frac{9}{10}$

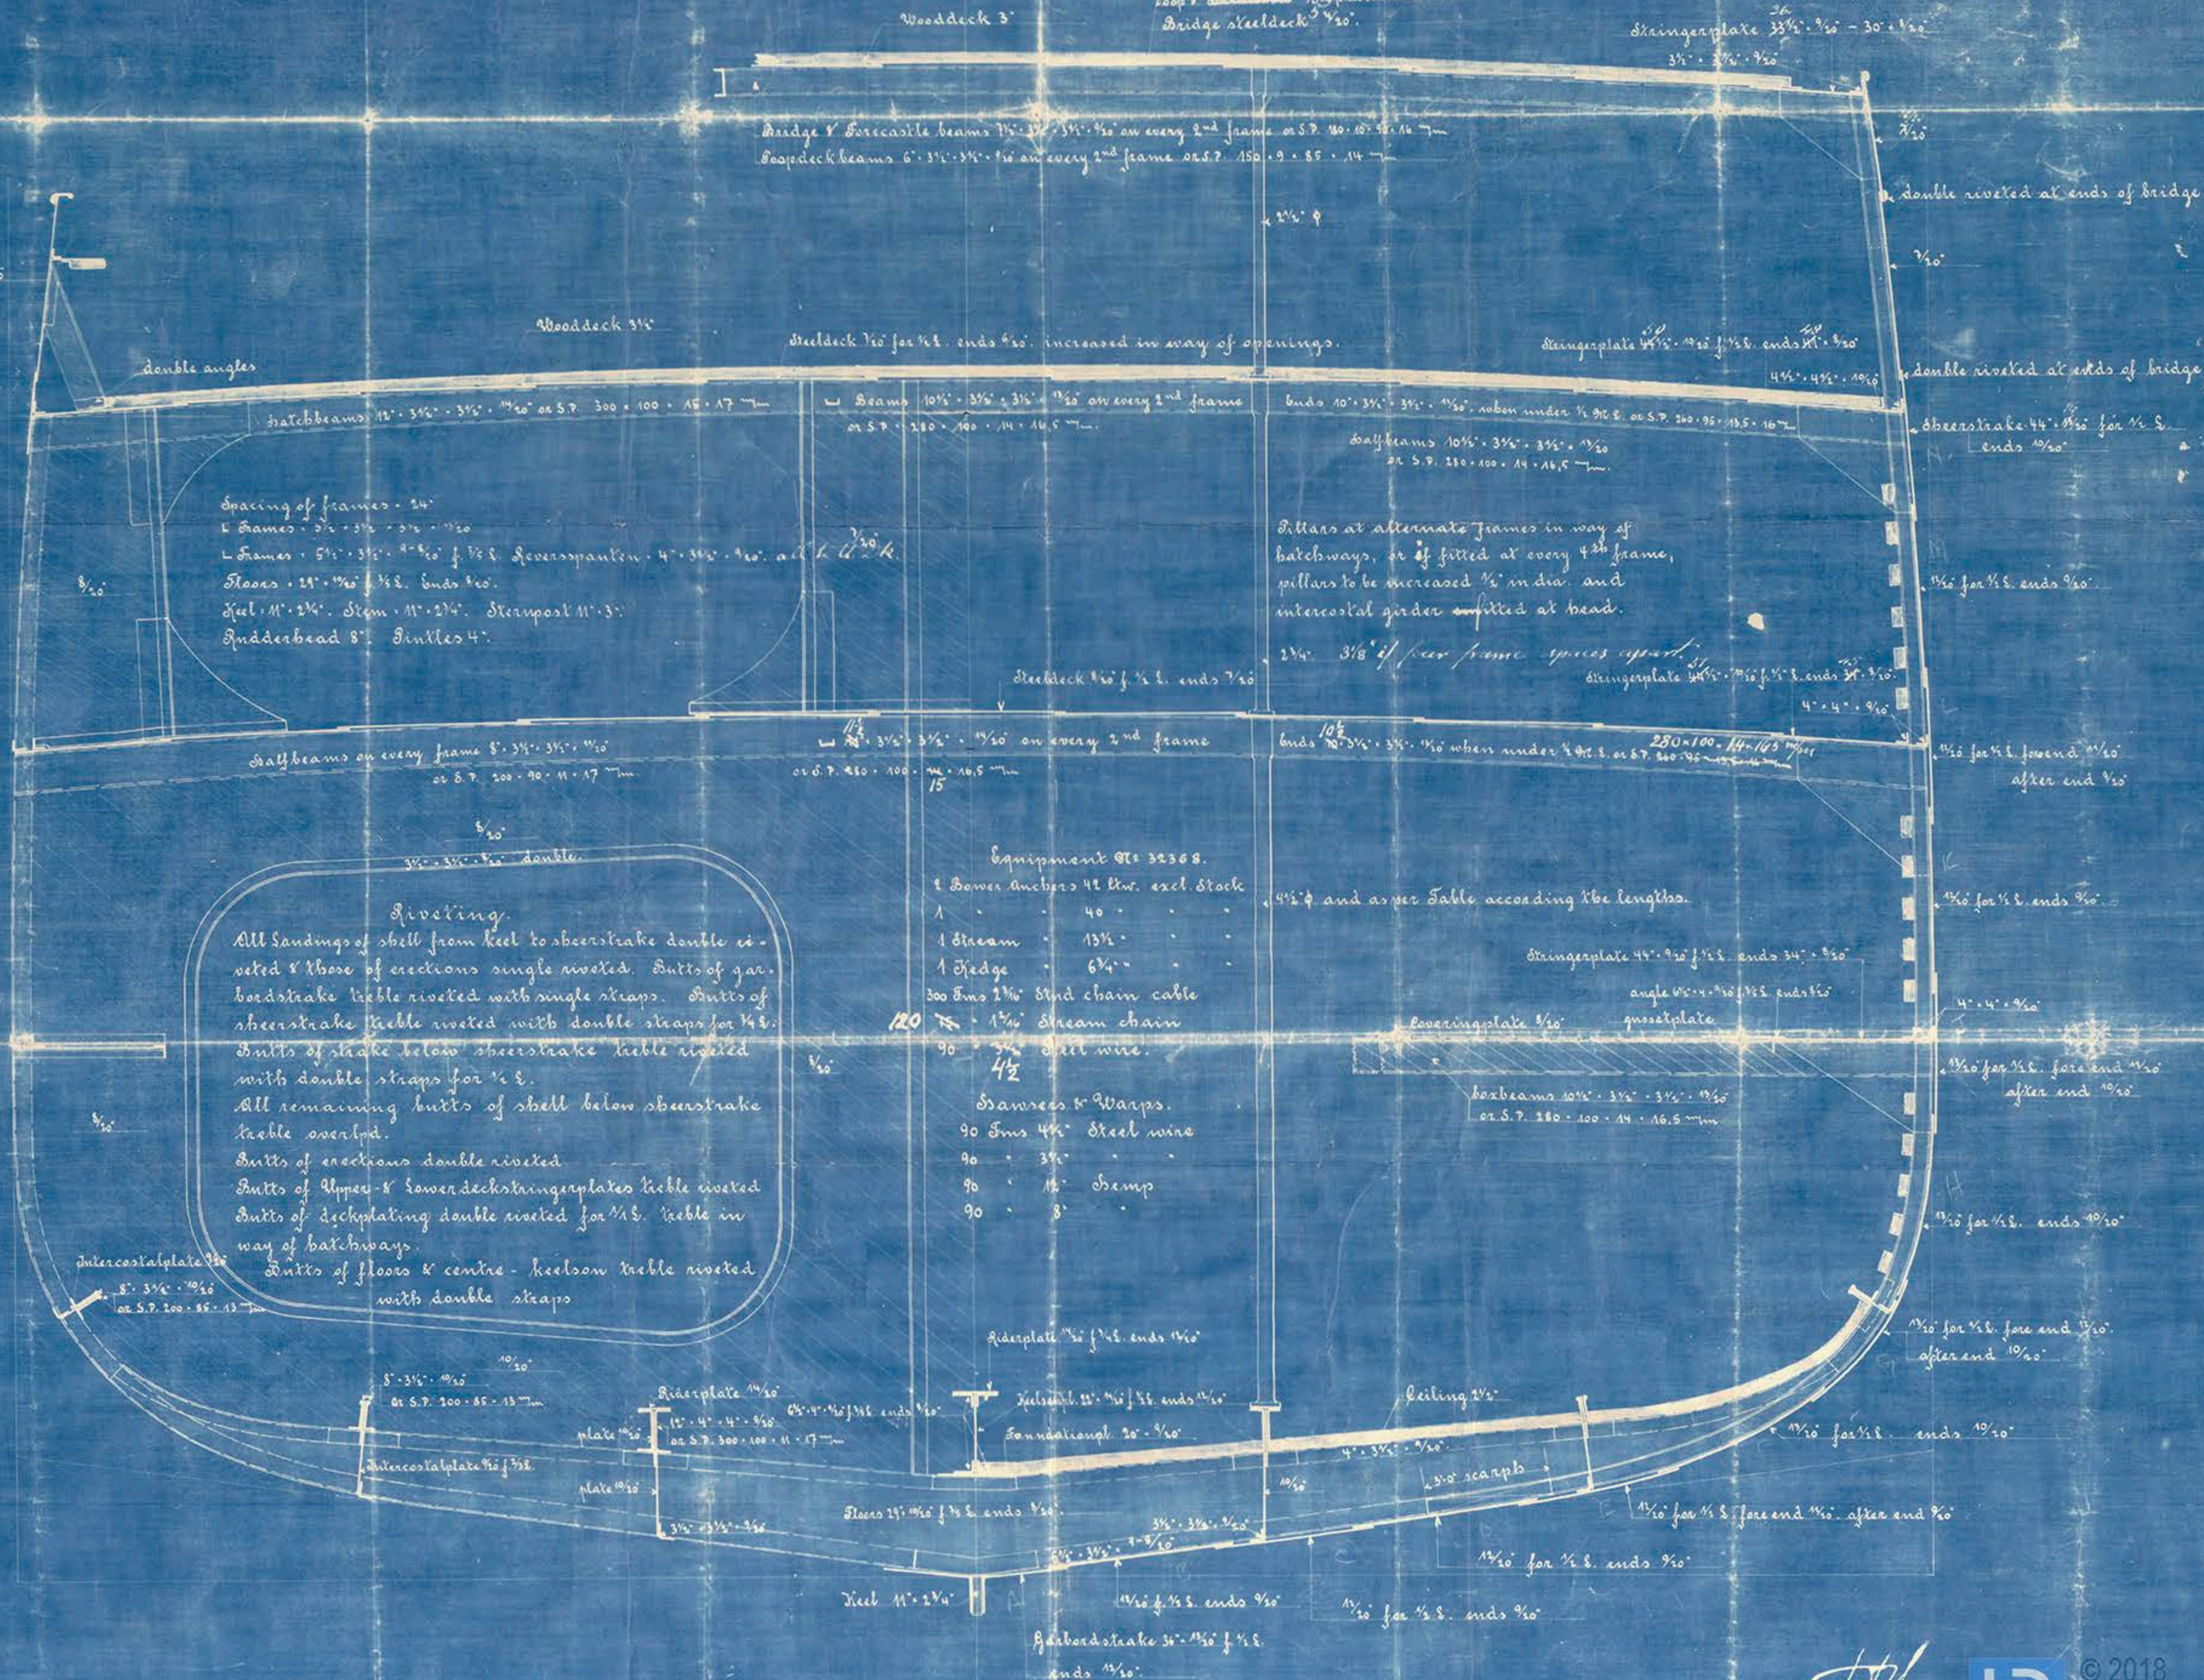

23  
1/2/04



Midship Section

b/20

LR-FAF-SA24-P-4



© 2018

Lloyd's Register  
Foundation