


21/6/05.

Ward Hunters SS N° 735

Topside plating.

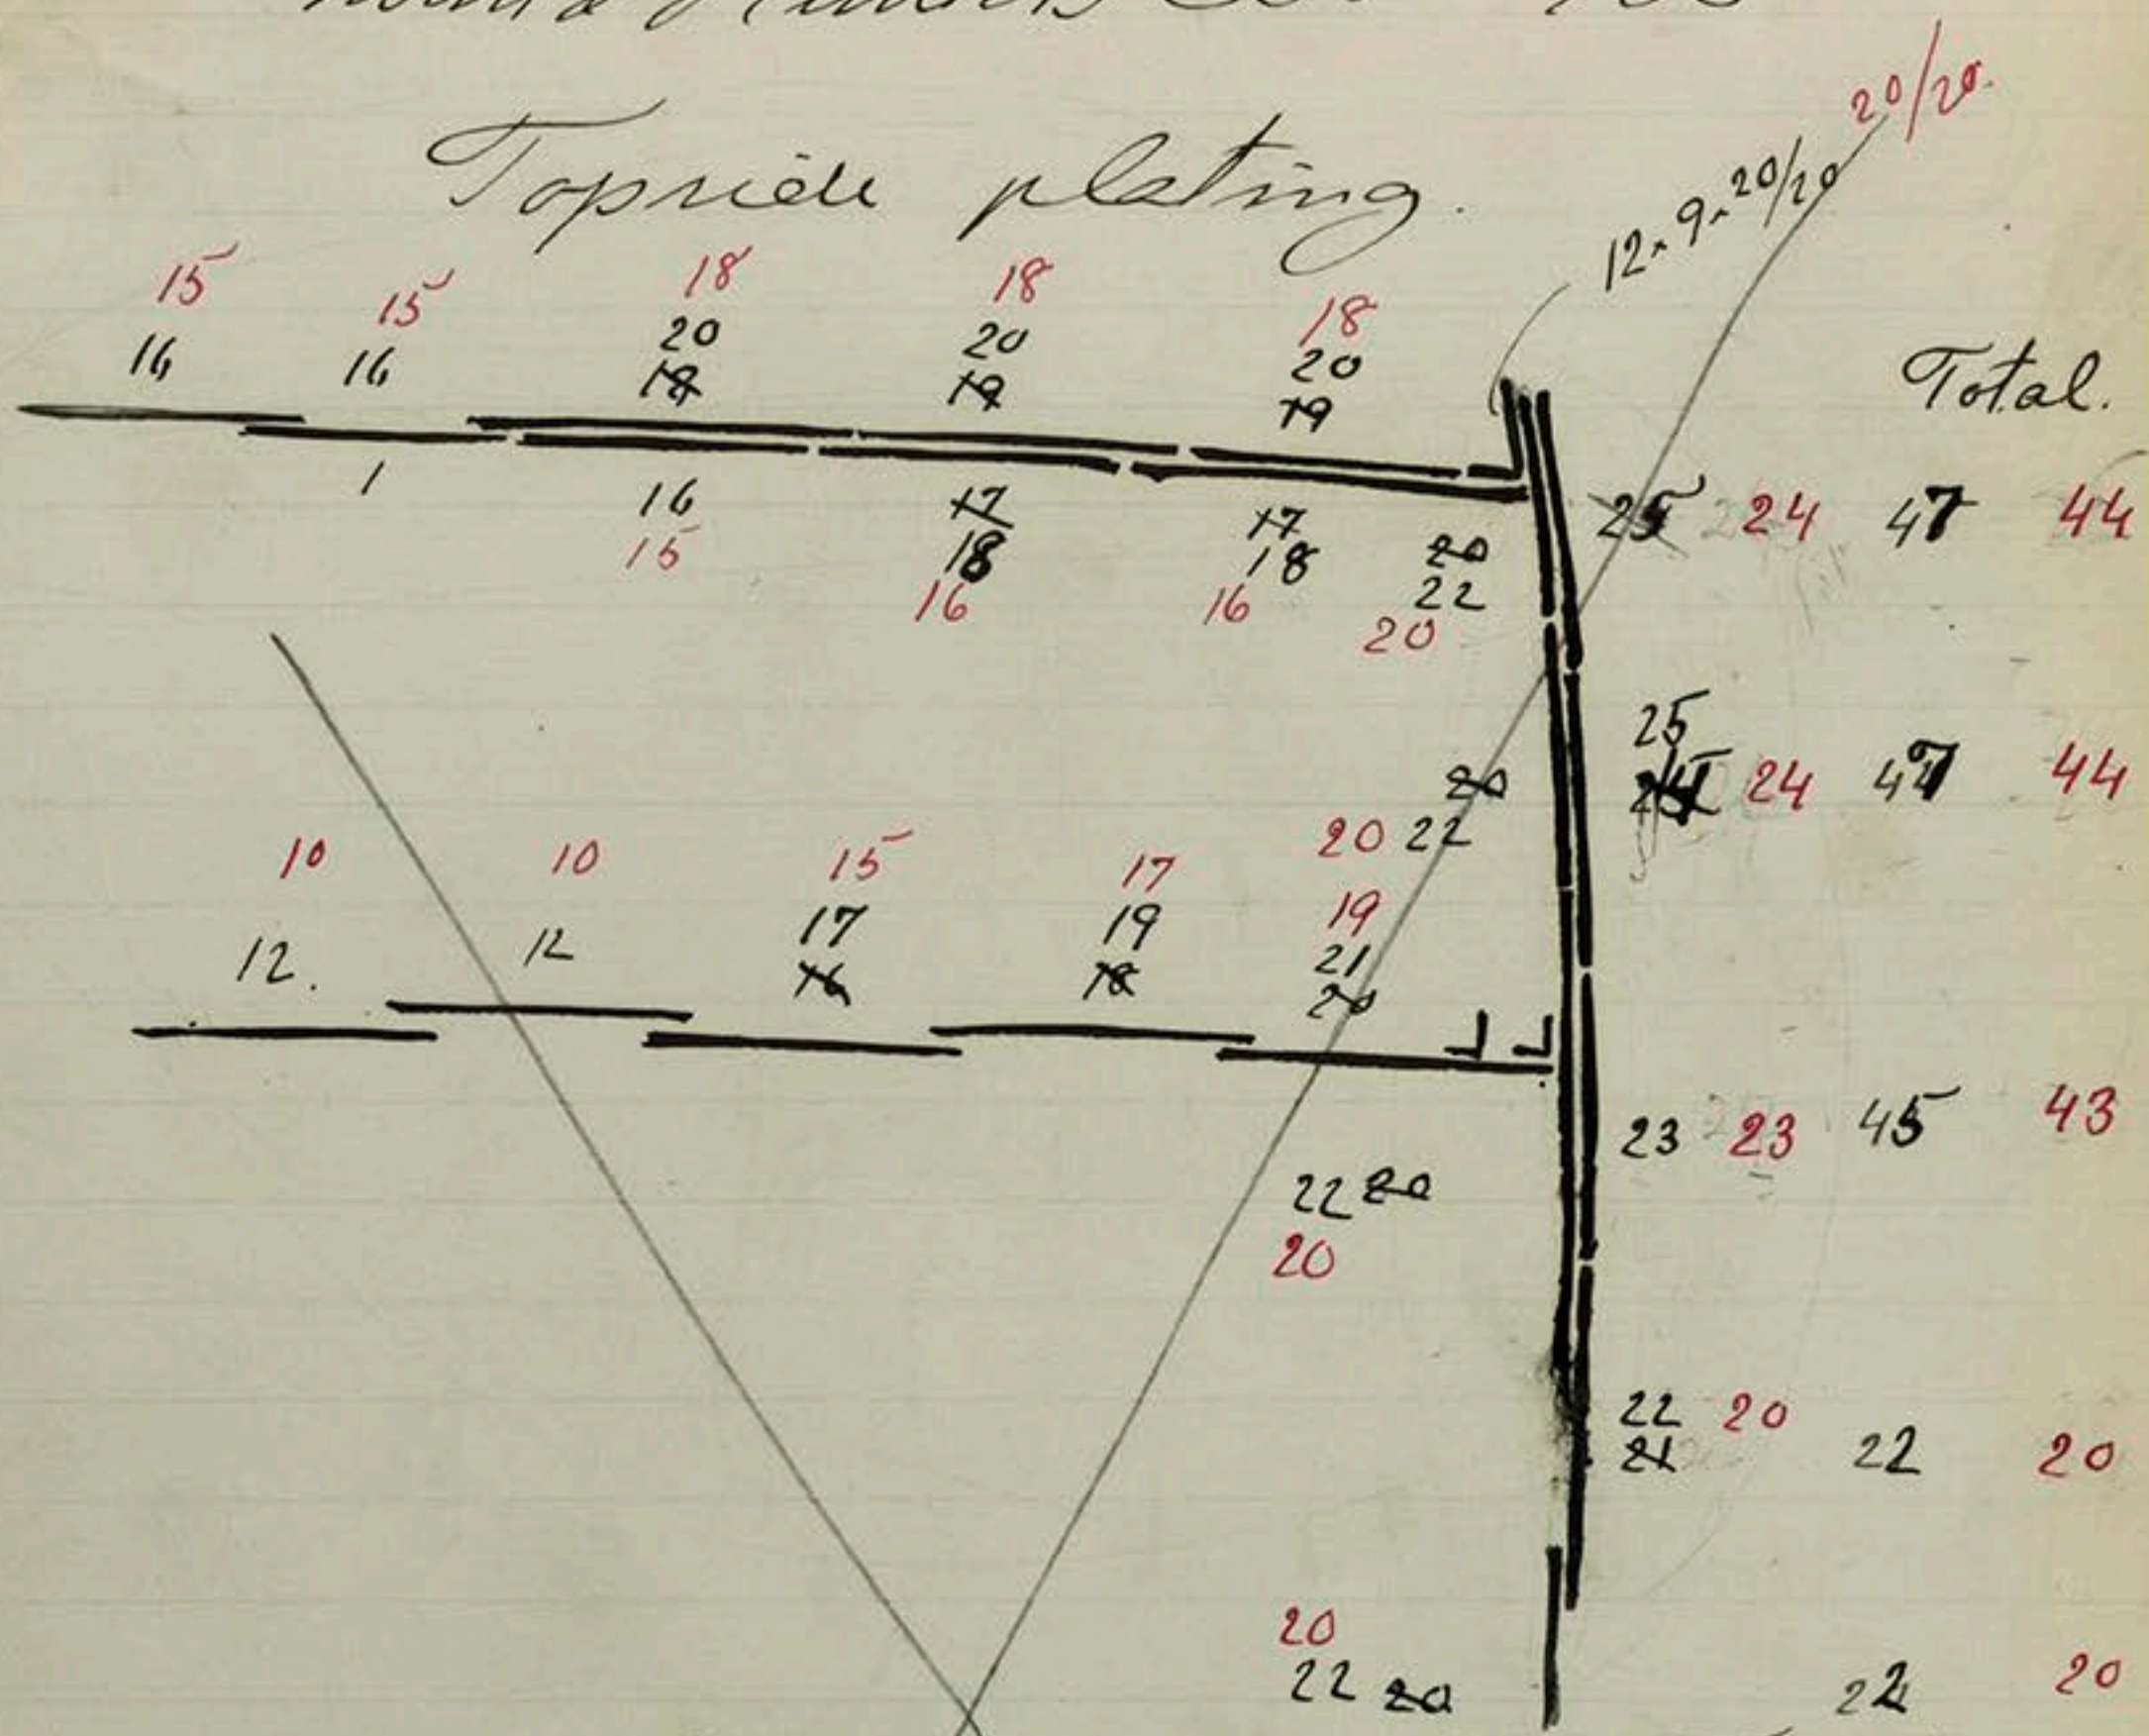

	Ordinary		High Tensile.	
Topside plating.	166	20	166	20
" + 2/10 " 1.	60	25	75	24
" " 2	54	25	67	24
" " 3	42	23	48	23
" " 4.				
th. Sh thr.	124	18	112	16
" " " doubl. 111	20		111	18
Strake next thr.	54	20	54	18
Doubl. " "				
th. Sh plt.	240	16	192	15
U. Sh thr.	54	20	57	19
Next strake.	54	17	59	17
" " "	54	17	46	15
Upper deck pl	234	12	140	10
			1145	
			114	
			1031	