



ALL SIDE SCUTTLES FITTED WITH HINGED DEAD LIGHTS. NO DEADLIGHTS ON DK BELOW FREEBOARD DK.

Portable Wood Plugs

OPEN RAILS ON SUPERSTRUCTURE DK (CLEARED WITH S.I. FULL HEIGHT). BULWARKS 4'-0" HIGH ON SUPERSTRUCTURE DECK.

ALL SINGLE OR DOUBLE (AS DRAWN) STEEL W.T. DOORS RUBBERED 3 CLIPS. (OPENING FROM BOTH SIDES). ALL 12" SILLS.

OPEN RAILS BULWARK 4'-0" HIGH.

Q.S.T.S. Mauretania
PLAN OF FREEBOARD DECK.

SCALE $\frac{1}{16}$ = 1 FOOT

BULWARKS 4'-0" HIGH ON SUPERSTRUCTURE DECK.

SIDE PLATING ON SUPERSTRUCTURE DK.

(SWIVAL PORTS) NO DEADLIGHTS FITTED ON DECK BELOW FREEBOARD DK. ALL SIDE SCUTTLES FITTED WITH HINGED DEADLIGHTS. FREEBOARD OF SIDE PLATING.

Portable plugs

COMPARTMENTWAY ON SUPERSTRUCTURE DK. (STEEL). DOUBLE WOOD DOORS ON ART AND 2" THICK. DEPTH OF SILL 18".

HATCH ON SUPERSTRUCTURE DK. (TRUNKED). L. 9'-0" x B. 10'-0" HEIGHT OF COAMING 18" ABOVE WOOD DR. THICKNESS 1" 15" SIDES & ENDS. NO BEAMS OR P.A.'S STEEL MINARD COVER W.T. STIFFENED BY 4 S.A. STIFFS.

COMPARTMENTWAY TO CIRCULAR BR. 5" STEEL MINARD COVER. NO DOORS. DEPTH OF SILL 7".


TRUNKED HATCH ON SUPERSTRUCTURE DK. 3'-4" x 3'-4" COAMING 3" HINGED STEEL COVER.

DOOR STEEL NON W.T. 6'-2" x 3'-2". DEPTH OF SILL 2".

OPENING IN TRUNK SIDE ON FREEBOARD DK. 6'-3" x 6'-6" HIGH. DEPTH OF SILL OF OPENING 18". NO MEANS OF CLOSING.

HATCH ON SUPERSTRUCTURE DK. (TRUNKED). L. 9'-11" x B. 10'-0" HEIGHT OF COAMING 15" ABOVE WOOD DR. THICKNESS 1" 15" SIDES & ENDS. NO BEAMS OR P.A.'S STEEL MINARD COVER W.T. STIFFENED BY 4 S.A. STIFFS.

OPENING IN TRUNK SIDE ON FREEBOARD DK. 6'-3" x 6'-6" HIGH. DEPTH OF SILL OF OPENING 18". NO MEANS OF CLOSING.

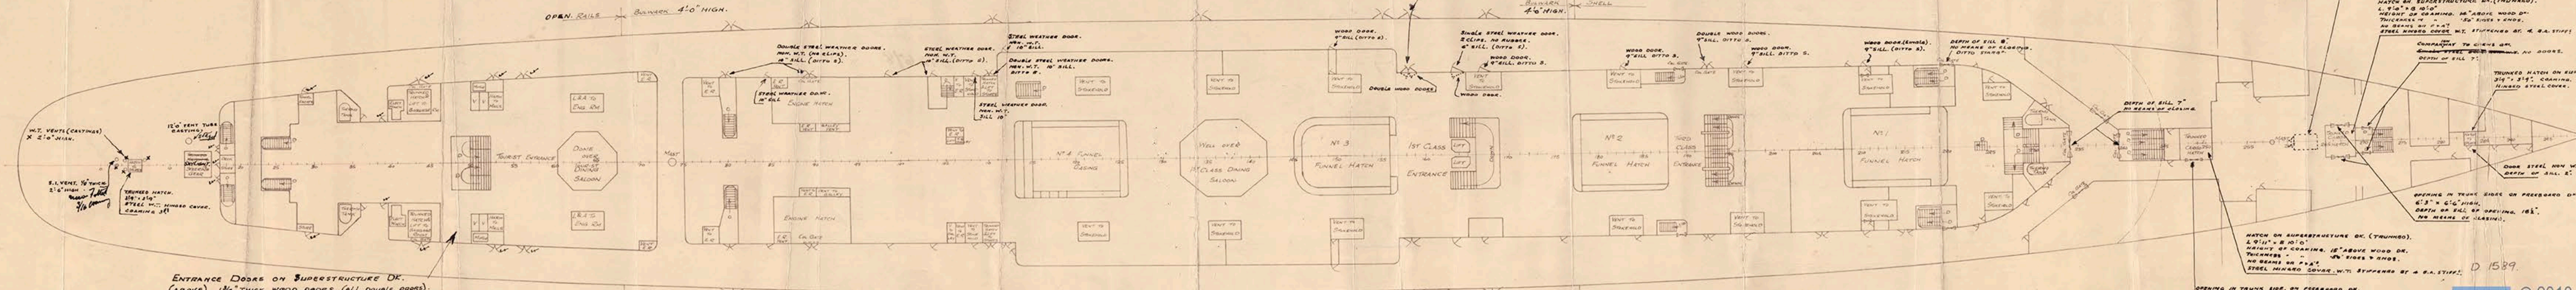

ENTRANCE DOORS ON SUPERSTRUCTURE DK. (ABOVE). 1 1/4" THICK WOOD DOORS. (ALL DOUBLE DOORS). DEPTH OF SILLS. 7".

ENTRANCE DOORS IN DECK HOUSE ABOVE (ON SUPERSTRUCTURE DK.) ALL 1 1/4" TEAK WOOD DOORS. DEPTH OF SILLS. 7".

S/S Mauritania
Particulars of openings
on shellter IDA.

Southampton Report
No 14678.

Southampton
© 2010
G.O.D.T.
Lloyd's Register
Foundation
22/5/12



un

Open

Southampton
G.H.D.T.



© 2018

Lloyd's Register
Foundation

LA-FAT-SALC-1-14

5