
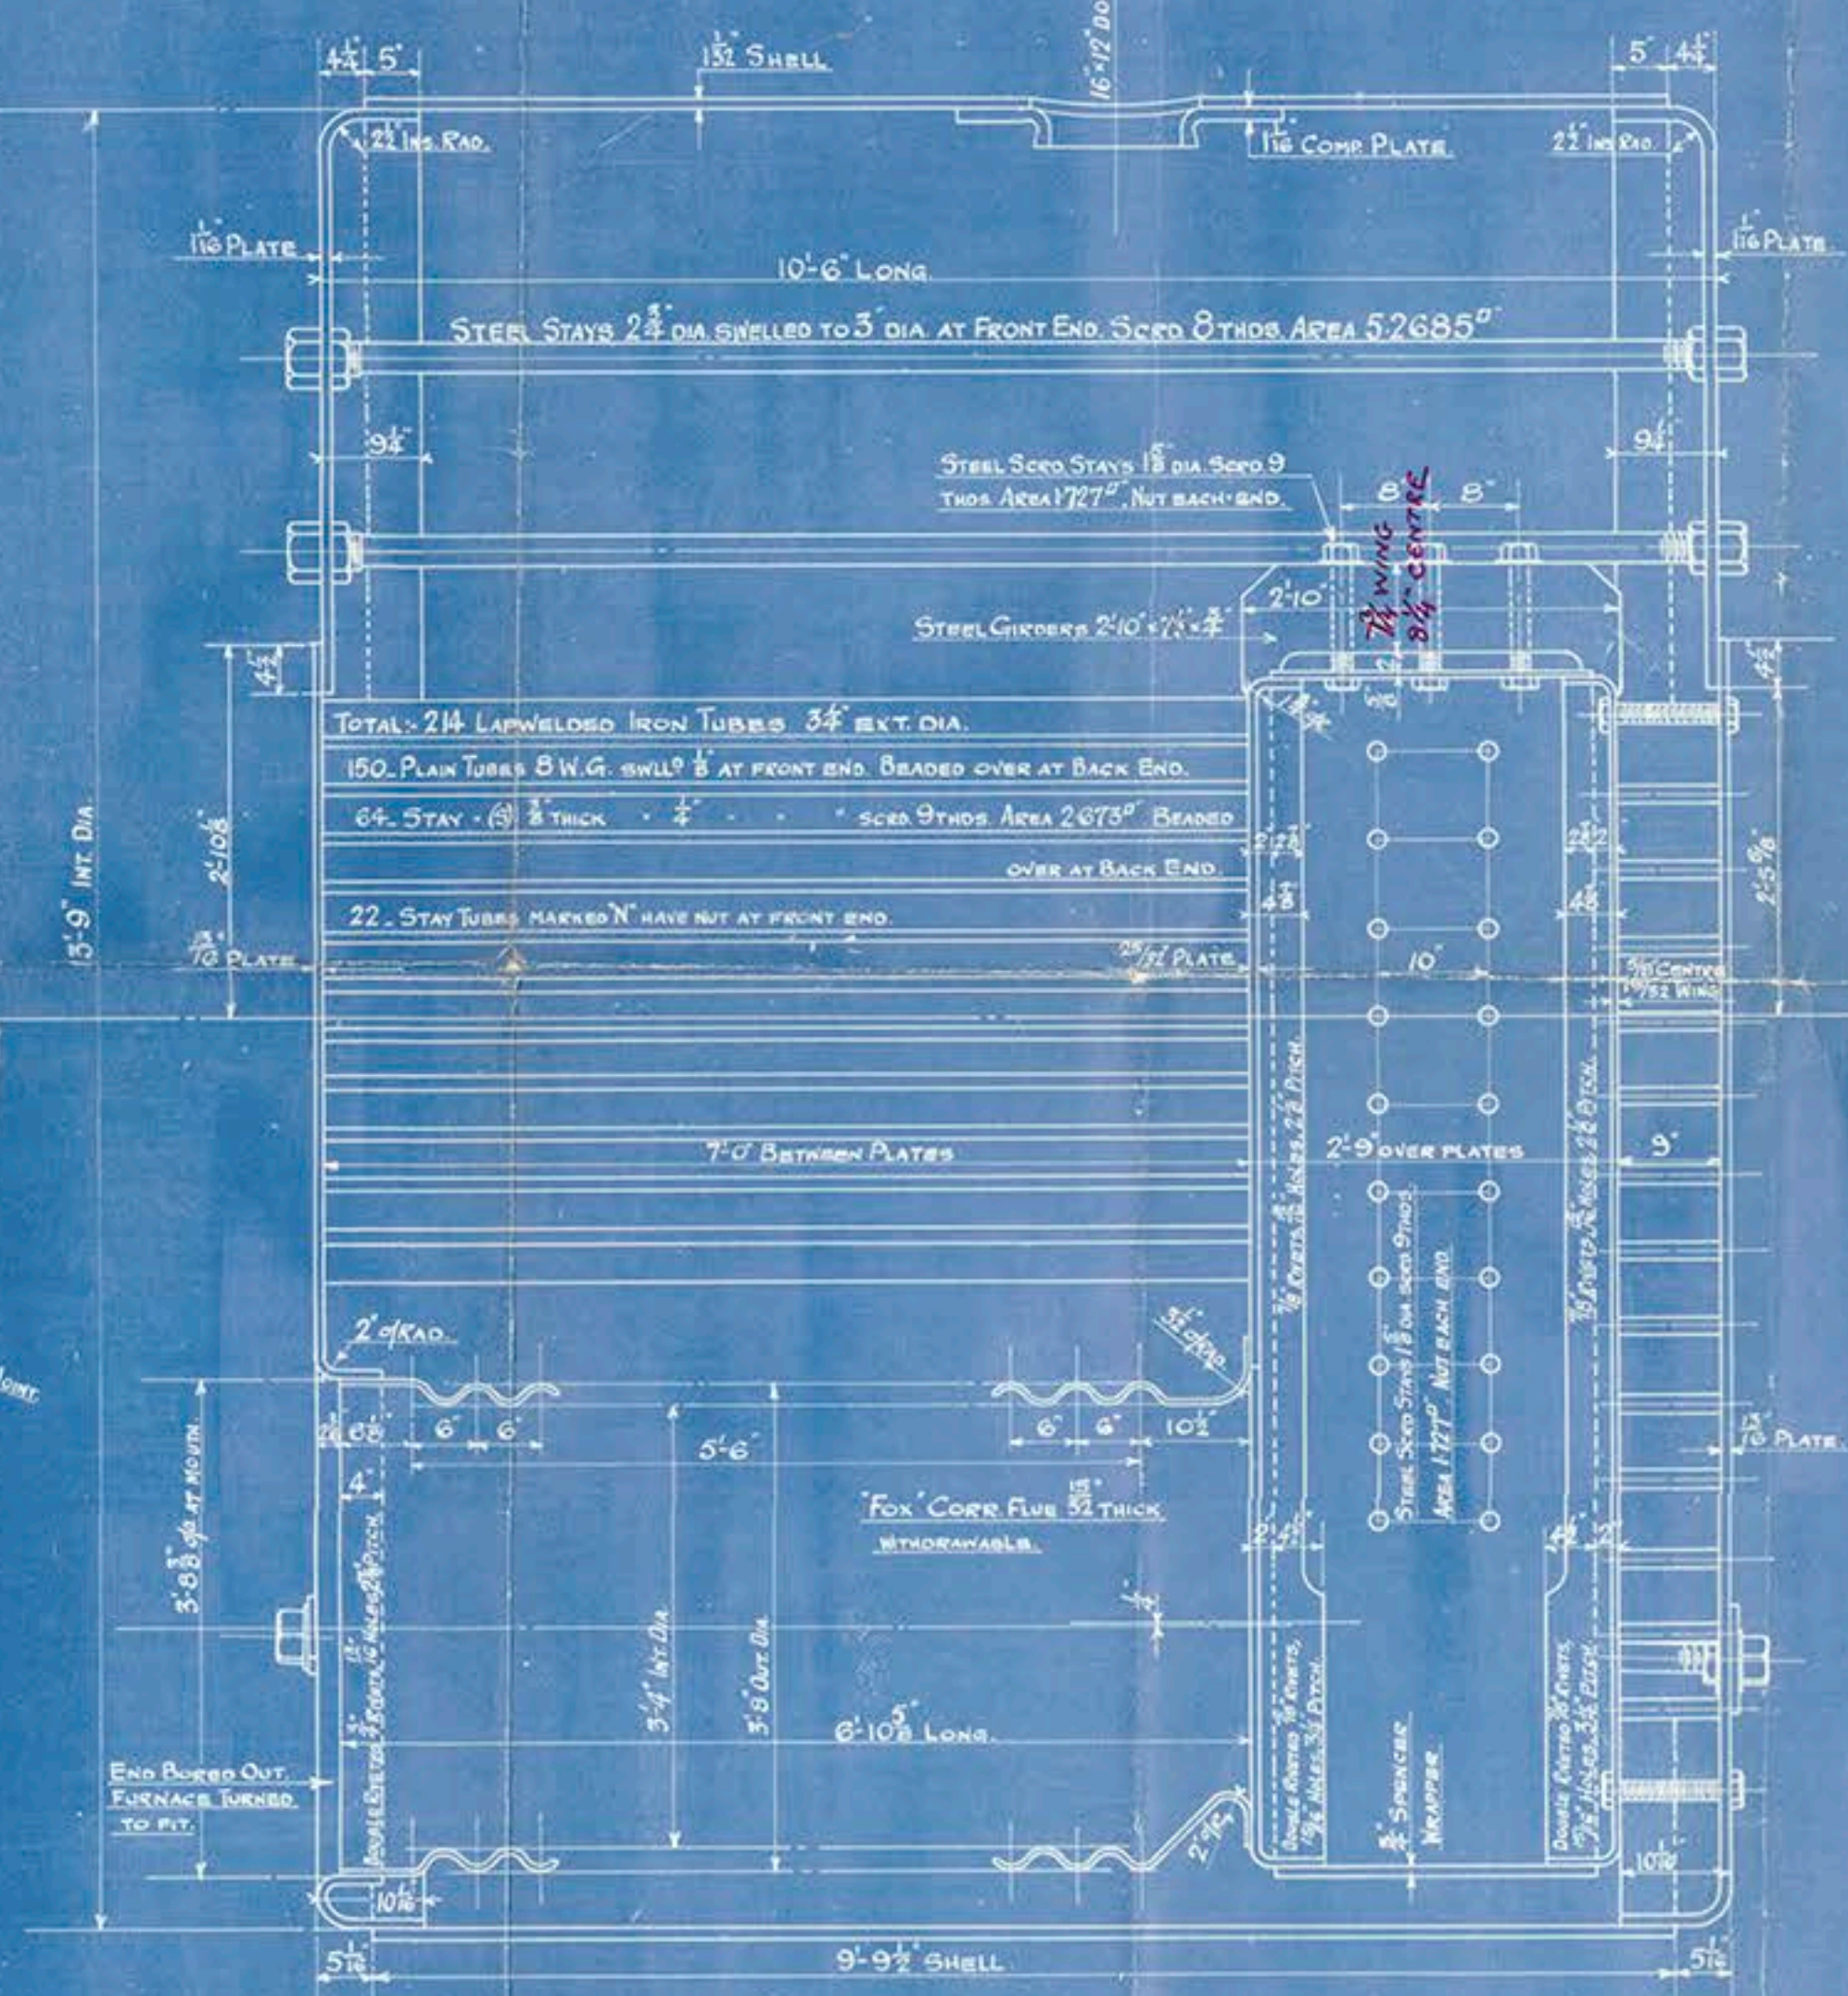


ALL PLATES, BARS, GIRDERS & RIVETS OF STEEL.  
TUBES OF IRON.

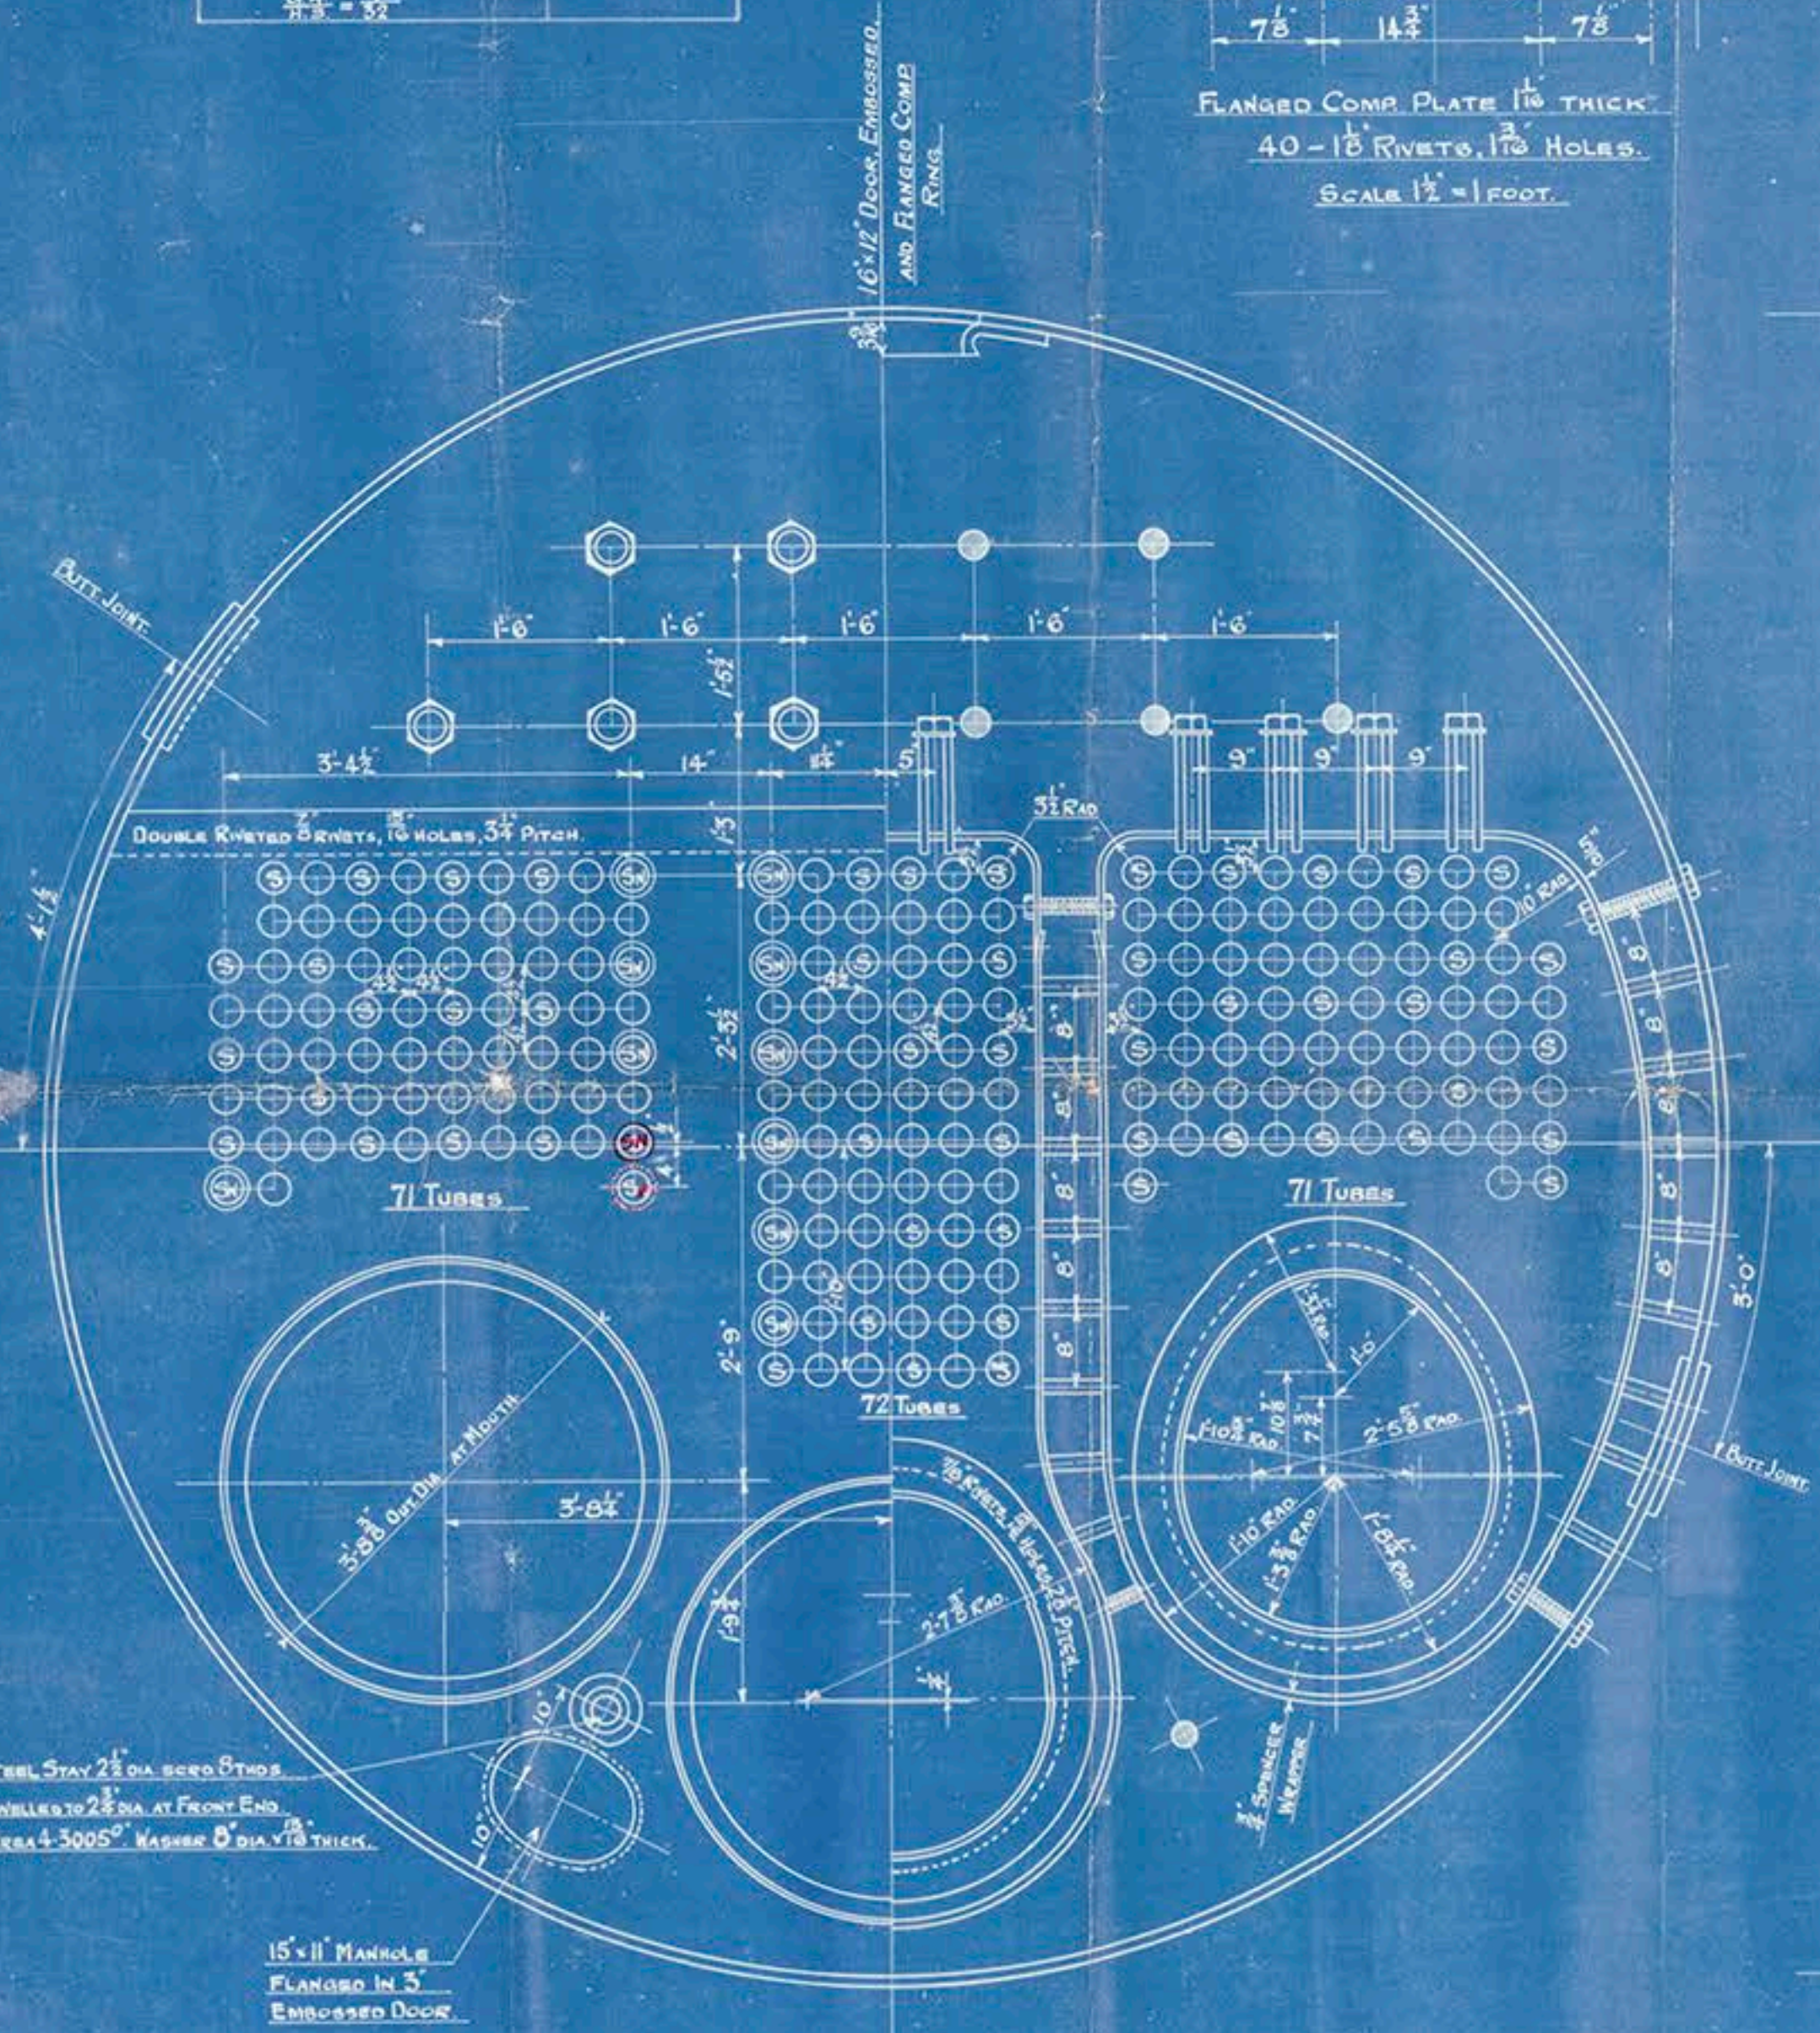

THE FORTH SHIPBUILDING &  
ENGINEERING CO (1921) LTD  
LINDSAY BURNET'S MOORE PARK  
BOILER WORKS  
GOVAN. GLASGOW.

SCALE ONE IN = 1 FOOT

DRAWING N° 9167

MAIN BOILER FOR S.S. "STETTIN"

BLR. № 18 LR

© 2018  
Lloyd's Register  
Foundation



MARINE BLR. N<sup>o</sup> 1818

13'-9" INT. DIA.

10'-6" OUT. LENGTH

160 LBS. W.P.

LLOYDS SURVEY

MAIN BLR. FOR S.S. STETTIN

16630 LLOYDS TEST. 290 LBS. WP. 160 LBS. 9.10.24. W.L.
---

Glasgow Register 44087

Vol 16611

GO



© 2018

Lloyd's Register  
Foundation