



N<sup>o</sup> 150  
Section through After Hold  
Scale  $\frac{1}{2}$ " to a foot.

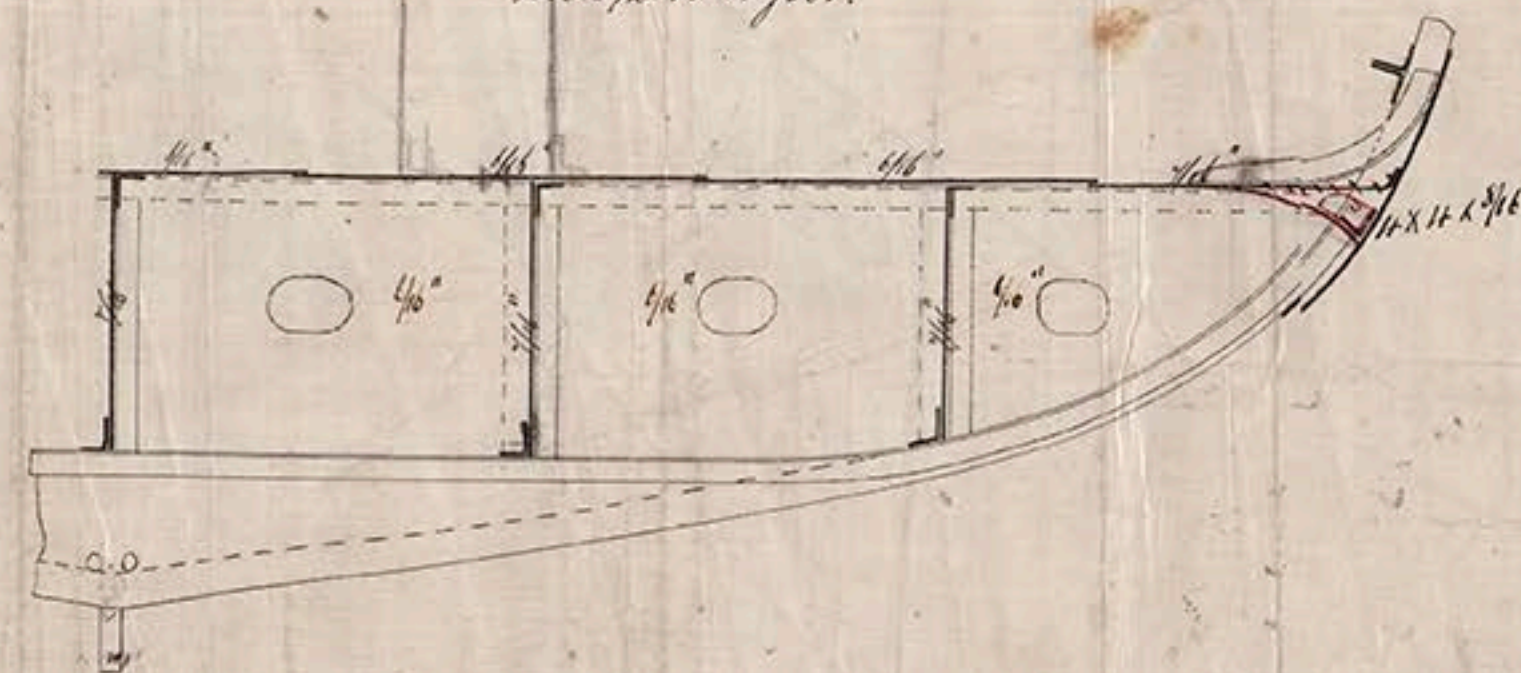

Charles McCord.

N<sup>o</sup> 150  
Section through Engine Room  
Scale  $\frac{1}{2}$ " to a foot

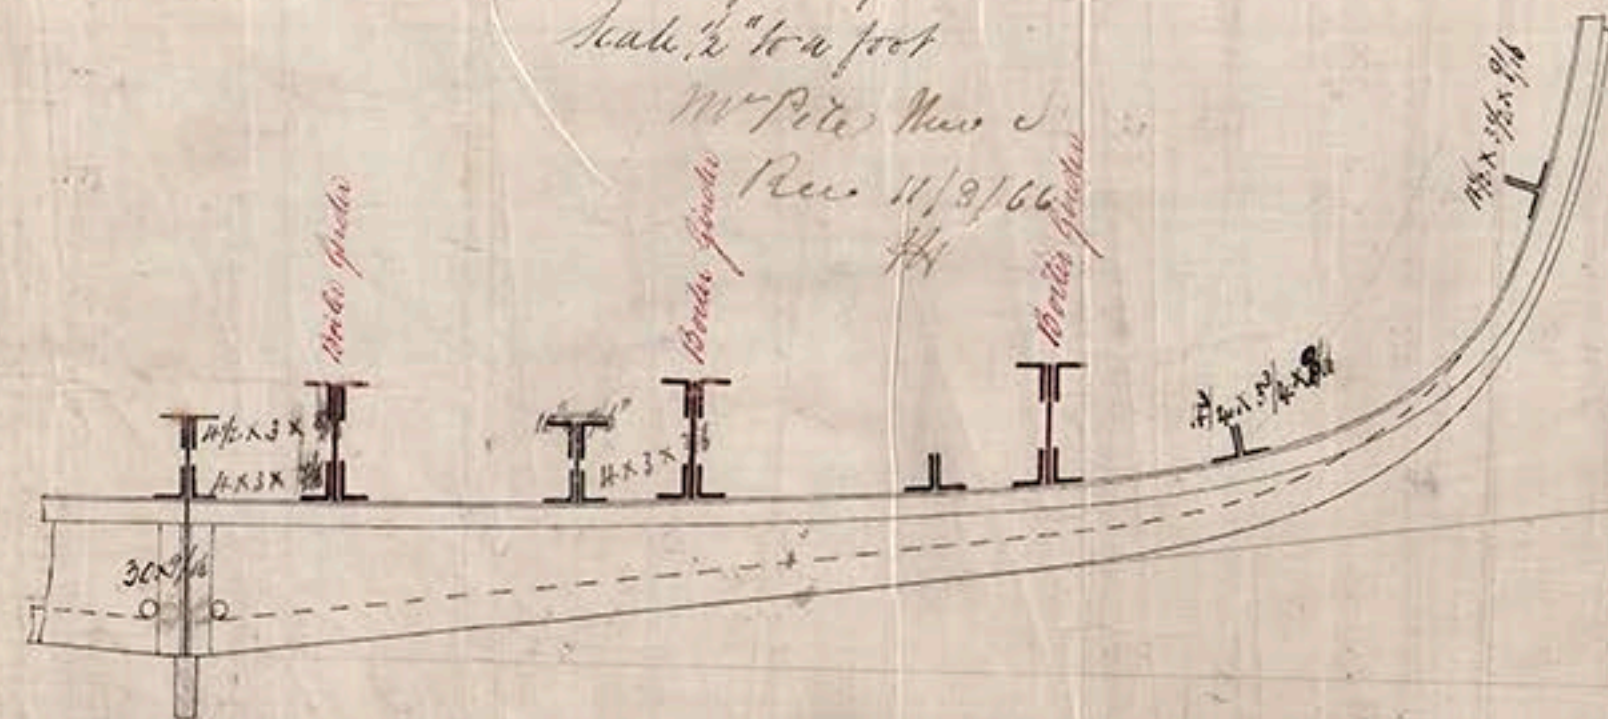

W. P. M. M.  
Rev. 11/3/66  
H.