Charles Howard

No. 150

Scale 1" = 1 foot.

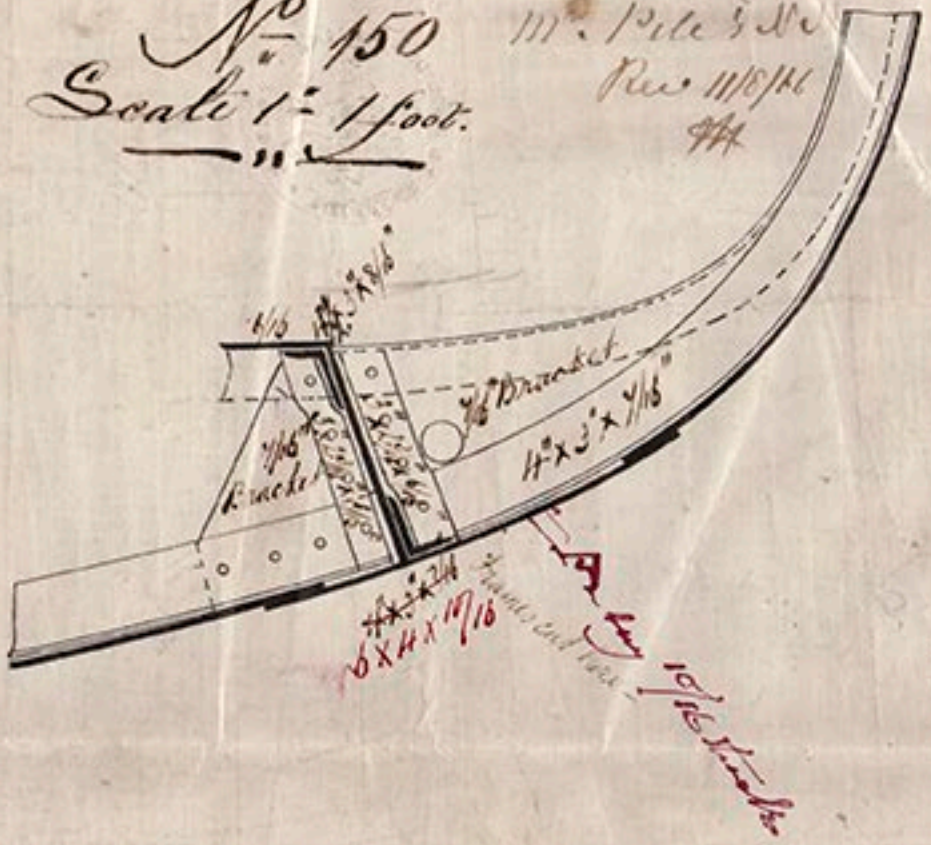

© 2018