




28/10/86  
18.3.87  
31.3.87

— S.S. "Charles Howard" — Rive. Report No. 20216  
Scale 1/8 Inch = 1 Foot

Sketch Showing Proposed Arrangement for Carrying Petroleum in Bulk

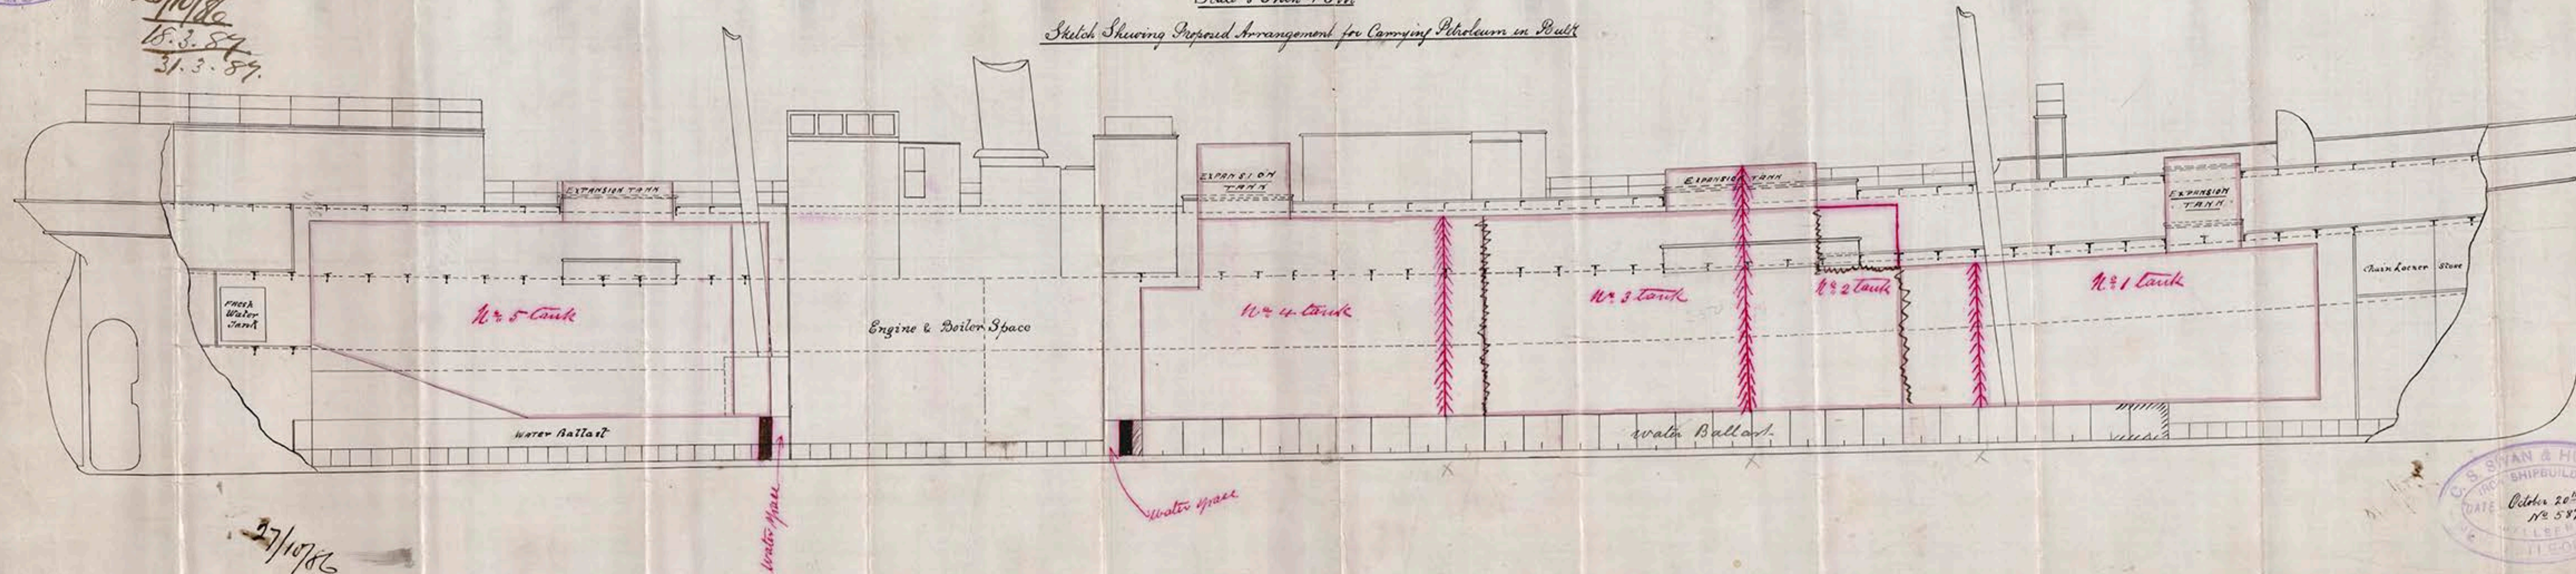

28/10/86



25/10/86  
14.3.87  
25.3.87